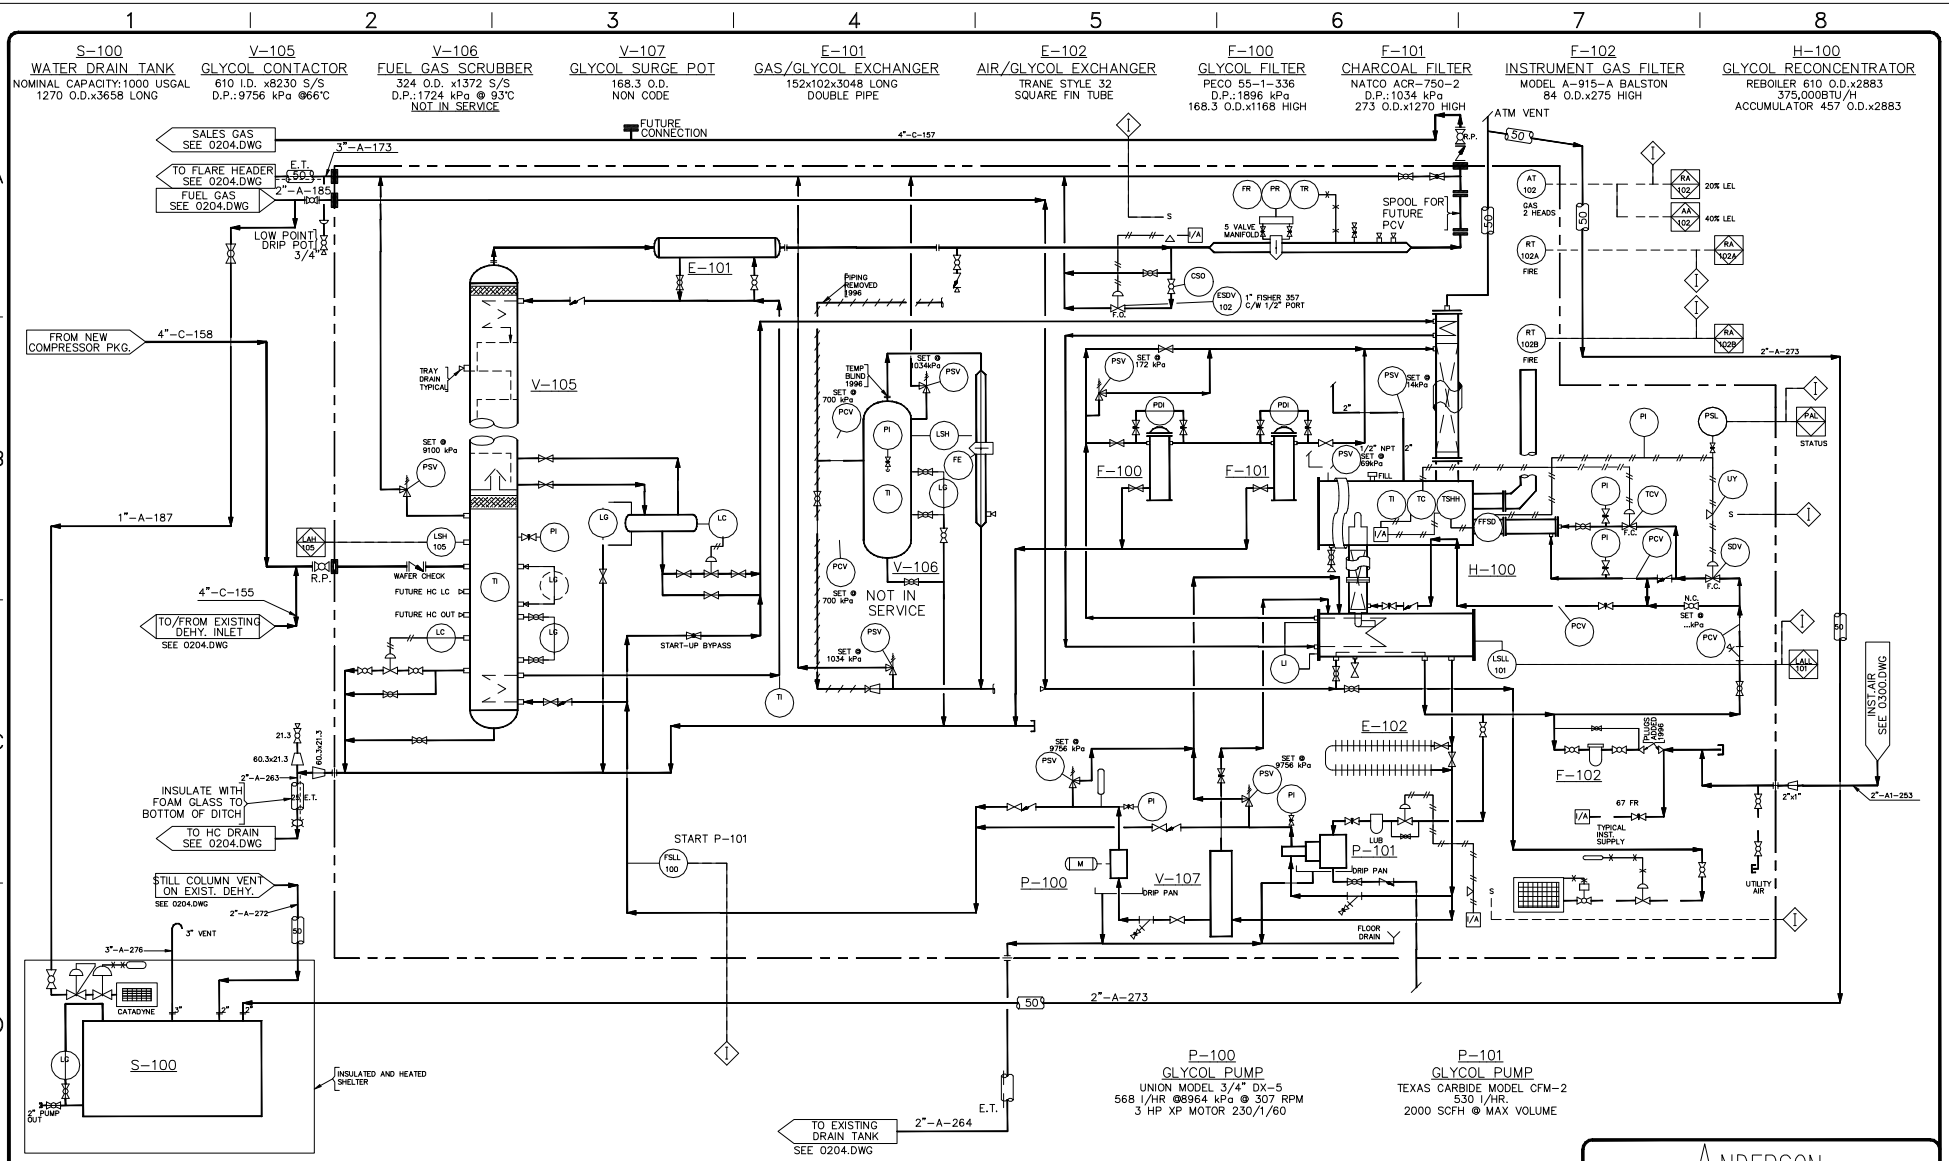

REV.	OWNER PROJECT NO.	DESCRIPTION	DATE	DRWN BY	CHKD BY	CIVIL APP	MECH APP	ELEC APP	I&C APP	PROJ ENG	Q.A.	OWNER CHKD	OWNER APP
1	963062	AS BUILT 1996 EXPANSION	96.06.19	A.D.L.									
0	963062	ISSUED FOR CONSTRUCTION	96.04.01	A.D.L.									
C	963062	ISSUED FOR BID	96.03.05	A.D.L.									
B	963062	DESIGN BASIS 1996 EXPANSION	96.02.22	A.D.L.									
A	963062	ISSUED FOR APPROVAL	96.01.17	A.D.L.									

REFERENCE DRAWINGS

GENESIS ENGINEERING LTD.
CALGARY ALBERTA
1996 EXPANSION

ANDERSON EXPLORATION

MISTAHAE
COMPRESSOR STATION 1996 EXPANSION
P&ID NEW DEHYDRATOR
LSD 06-07-78-01 W5M

SCALE	DWG. No:	REV
NONE	D-0607CS-078015-0208.DWG	1

CONTR. DWG. No. 9540-A1-208