THIS DRAWING IS THE PROPERTY OF NORTHERN DRAFTING SERVICES LTD. ON BEHALF OF ITS CLIENT. FOR COPIES OR REVISIONS TO THIS DRAWING, PLEASE CALL 1-250-785-0131.

AutoCAD 14

280-MF-04

V-2-100
TEST SEPARATOR

SIZE: 762 mm ø x 2438 mm S/S
MAWP: 9618 kPa @ 66°C
SN: 01-2933-1
CA: 3.2 mm
CRN: N-4676.213
A No.: 439360

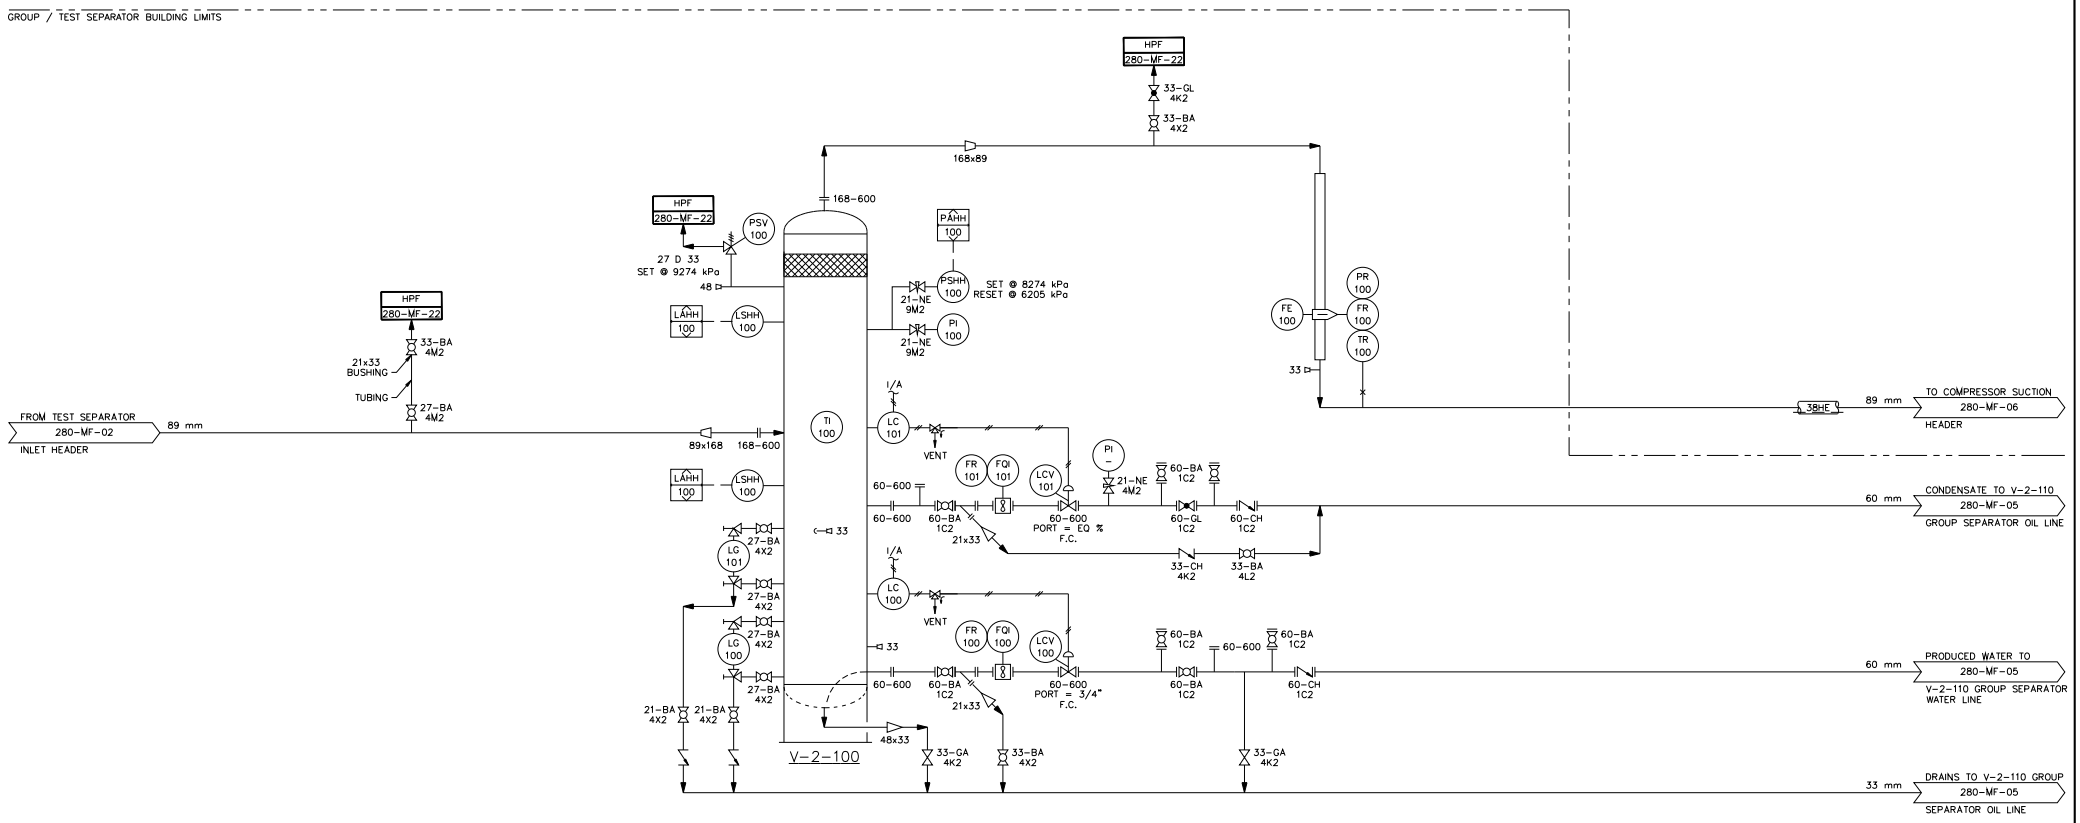

280-MF-04

NO.	DATE	REVISIONS	DRAWN	CHECK	DESIGN	APPR.
			DRAFTING		ENGINEERING	
7	12 06 02	GENERAL REVISION - REDRAWN	WRM	WRM		
6	22 09 99	AS BUILT - NORTHERN DRAFTING SERVICES LTD	JW	PW	MK	MK
5	27 04 99	AS BUILT	JW	WC	MK	MK
4	09 03 99	RE-ISSUED FOR CONSTRUCTION - LINE No ADDED	PW	MK	MK	MK
3	19 02 99	ISSUED FOR CONSTRUCTION	JW	MK	MK	MK
0	17 11 98	ISSUED FOR CONSTRUCTION	JW	PW	MK	MK

NO.	TITLE
280-MF-01 TO 30	MECHANICAL FLOW DIAGRAMS
280-PP-01	MECHANICAL PLOT PLAN

REFERENCE DRAWINGS

PROFESSIONAL AND PERMIT STAMPS AFFIXED HEREUNDER SHALL APPLY ONLY TO REVISION(S) 0 TO 6

PROFESSIONAL ENGINEER
PROVINCE OF BRITISH COLUMBIA
M. A. KAPPELHOFF

PROFESSIONAL AND PERMIT STAMPS

NORTHERN DRAFTING SERVICES LTD
OILFIELD DESIGN AND DOCUMENTATION
FORT ST JOHN B.C.
1-250-785-0131

APPROVED FOR CONSTRUCTION

BY_____ DATE YY MM DD

BY_____ DATE YY MM DD

Anadarko Canada Corporation

5-12-87-25 W6M HALFWAY BATTERY
V-2-100 TEST SEPARATOR
MECHANICAL FLOW DIAGRAM

CLIENT FILE NO.	SCALE	NORTHERN DRAWING NUMBER	REV.
-	NTS	HAF0512-220-0005	7
CLIENT DWG NUMBER -			