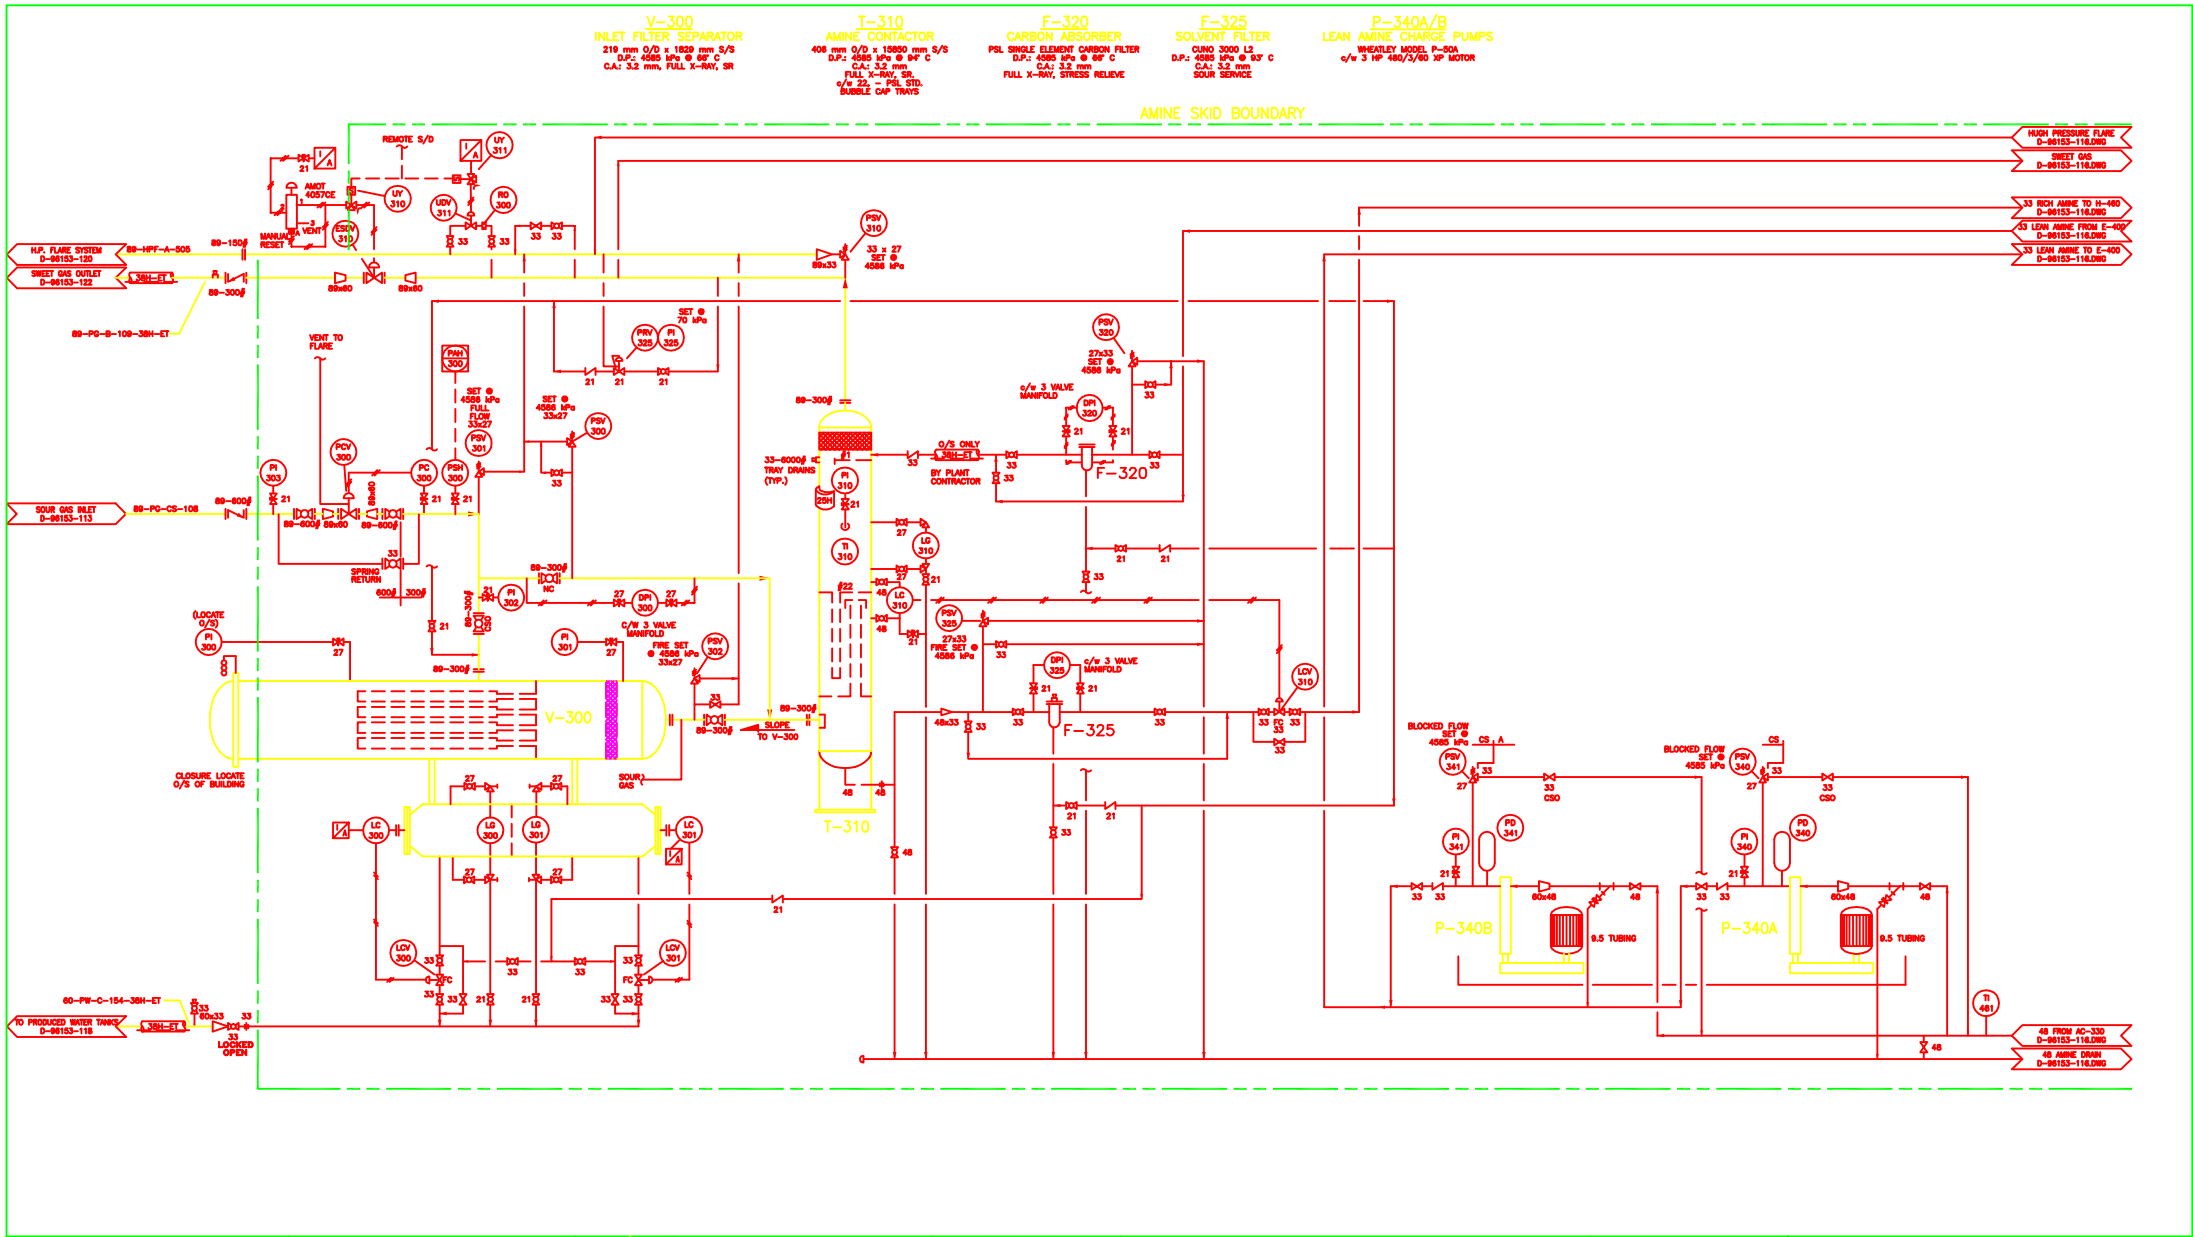

DWG. NO.	REFERENCE DRAWINGS	DEVON PROJECT	REV	REVISIONS	DATE	BY	CHK'D	APP'D	OWNR APP'D
		046225	4	BOOSTER COMP. #2 ADD'N – AS-BUILT (ASHER)	06-05-21	WL	JU	BHT	
		003981	3	COMP #2 ADDN – AS BUILT	02-01-09	SB			
			2	AS BUILT PHASE 2	97-11-12	OFF			
			1	AS BUILT	97-04-18	OFF			

CONSULTANT: GAS LIQUIDS ENGINEERING LTD.

ENGINEER AND PERMIT STAMPS

SIGNED BY PROFESSIONAL ENGINEER BRENT TAYLOR ON JULY 27, 2006 FOR REVISION NO. 4

CADD FILE: 6153-115.dwg

DESIGNED		
DRAWN	GAS LIQUIDS ENG.	05-02-04
CHECKED		
PROCESS CK.		
MECH. CK.		
STRUCT. CK.		
ELECT. CK.		
OWNER APP.		
OWNER APP.		

devon

BIRLEY CREEK COMPRESSOR STATION
BOOSTER COMPRESSOR ADDITION
P & ID – AMINE SYSTEM (SHEET 1 OF 3)
b-99-G, 94-H-3

CONTR JOB NO	SCALE	DWG. NO.	DEVON PROJ.	
594	NTS	D-96153-115	046225	4