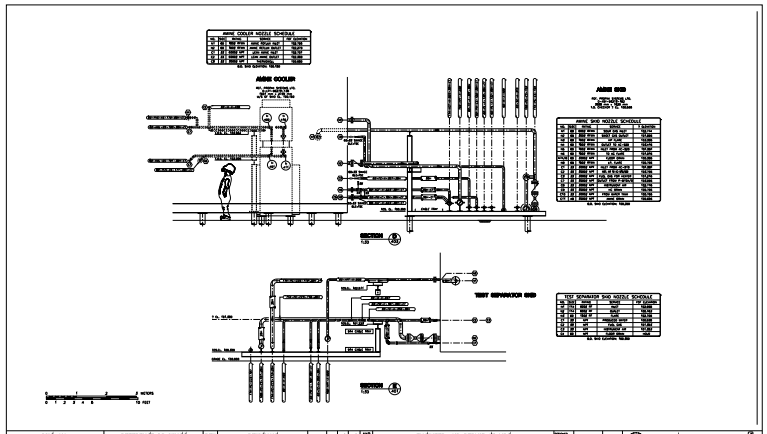

DWG. NO.	REFERENCE DRAWINGS	REV	REVISIONS	DATE	BY	CHK'D	APP'D	APP'D
		4	ISSUED COMP.(2) REV - IS-DWG 2007-24222	09-05-27	KL	JK	BP	
		3	AS BUILT PHASE 2	07-11-12	BP			
		2	AS BUILT	07-08-08	AP			
		1	UPDATED AMINE & SEPARATOR SKIDS	07-02-01	JM			
		C	ISSUED FOR CONSTRUCTION	07-01-02	KL			
		B	ISSUED FOR IDC	06-12-12	MC			

ENGINEER AND PERMIT STAMPS

ISSUED BY
PROFESSIONAL ENGINEER
BRIAN BLUM
ON JULY 20, 2006
FOR SEAL SEE 4

DESIGNED	KR JAMES (KL)	06-12-12	
CHECKED			
PROJECT ENG.			
DRAWN			
DRAWING No.			
SCALE No.			
APP. DATE			
APP. NAME			

ANADARKO EXPLORATION
CALGARY, ALBERTA, CANADA

PROJECT
BIRLEY CREEK COMPRESSOR STATION

DRAWING
MISCELLANEOUS PIPING SECTIONS
AMINE SKID
LSD. 6-36-61-11-W5

JOB No. 04026 | SCALE 1:20 | DWG. No. D-06152-414 | A


