


E

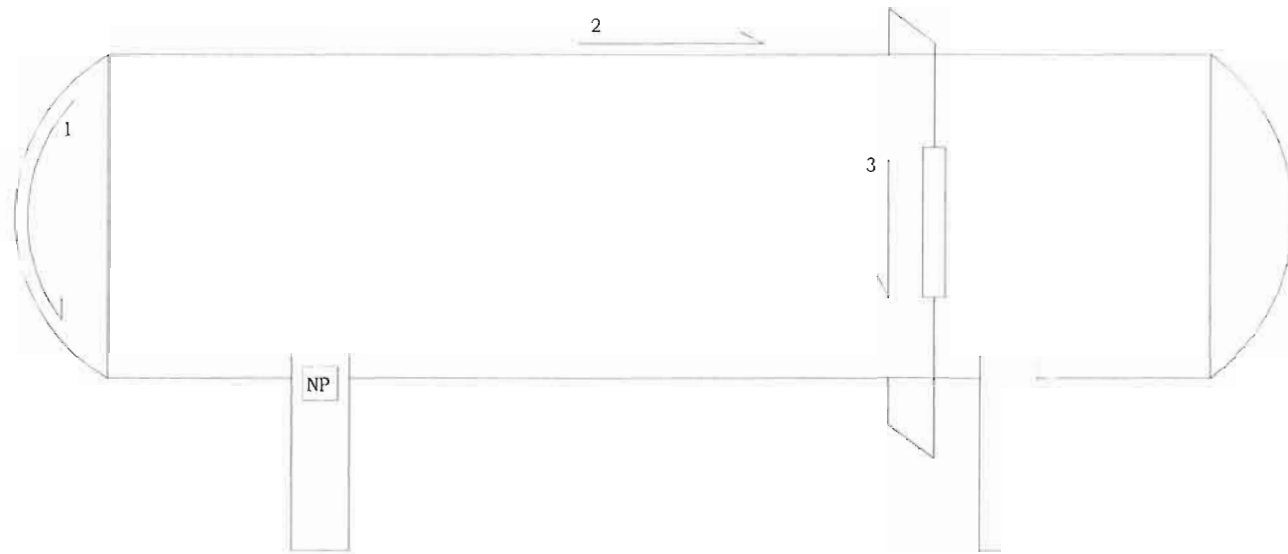

ENTERED  
09/20/2013  
CF

VESSEL DATA

UNIT#: 22890 TAG#: SH-1011A

DESCRIPTION: Propane Accumulator

MANUFACTURER: Presson

SERIAL#: 5496 21

C.R.N.#: M 0196.2

ALBERTA#: 2980791

B.C.#:

M.W.P.: 270 psi @ 150 F

SHELL: 9.5 mm 516 70

HEAD: 8.6 mm 516 70

SIZE: 36" x 15'

CORR. ALLOW.: 1.6 mm

MAN. DATE: 1994

HEAT TREAT.:

RADIOGRAPHY: RT 2

CLIENT: DEVON CANADA CORP.

LOCATION: SADDLE HILLS 1-3-77-7 W6M PLANT

DATE: Nov 3, 1999

DRAWN BY: JWE

DRAWING#: SH-0103-V45

# DEVON CANADA CORP

Location: Saddle Hills 1-3-77-7 Plant

Unit #: 22890 Propane Accumulator

Dwg #: SH-0103-V45

Eq#: SH-1011A

Band #:	1	West Head					T'Nom:	8.6	T'Min:	7.0
Point#		Oct 1999	May 2002	Jun 2005	Mar 2008	Aug 2013				
1		9.8	9.8	9.9	9.7	9.8				
2		9.8	9.7	9.8	9.7	9.8				
3		9.7	9.8	9.8	9.6	9.7				
4		9.6	9.6	9.7	9.6	9.7				
5		9.6	9.6	9.7	9.6	9.8				
6		9.6	9.7	9.8	9.6	9.7				
7		9.6	9.6	9.7	9.7	9.8				
8		9.7	9.7	9.8	9.7	9.7				
9		9.7	9.8	9.8	9.8					
10		9.8	9.8	9.9	10.0					
Average		9.7	9.7	9.8	9.7	9.8				
Meas Min		9.6	9.6	9.7	9.6	9.7				
% Loss/Ave		1	1	1	1	1				
% C.A. Lost										

Band #:	2	Top of Mid Shell					T'Nom:	9.5	T'Min:	7.9
Point#		Oct 1999	May 2002	Jun 2005	Mar 2008	Aug 2013				
1		9.8	9.9	10.1	9.9	10.0				
2		9.9	10.2	10.2	10.2	10.0				
3		10.1	9.9	9.9	9.8	10.2				
4		9.7	9.9	9.9	9.8	10.0				
5		9.9	9.9	10.0	9.9	10.0				
6		9.8	9.9	10.0	9.9	9.9				
7		9.9	10.0	9.9	9.9	10.0				
8		9.9	10.2	10.0	10.0	9.9				
Average		9.9	10.0	10.0	9.9	10.0				
Meas Min		9.7	9.9	9.9	9.8	9.9				
% Loss/Ave		2	1	1	1	1				
% C.A. Lost										

Band #:	3	Mid Shell					T'Nom:	9.5	T'Min:	7.9
Point#		Oct 1999	May 2002	Jun 2005	Mar 2008	Aug 2013				
1		9.8	9.9	9.9	9.9	9.9				
2		9.8	9.9	9.9	9.8	9.9				
3		9.8	9.8	9.9	9.8	9.9				
4		9.8	9.9	9.9	9.8	9.9				
5		9.8	9.9	9.9	9.8	9.9				
6		9.8	9.8	9.9	9.8	9.9				
7						9.9				
8						9.9				
Average		9.8	9.9	9.9	9.8	9.9				
Meas Min		9.8	9.8	9.9	9.8	9.9				
% Loss/Ave		0	1	0	0	0				
% C.A. Lost										