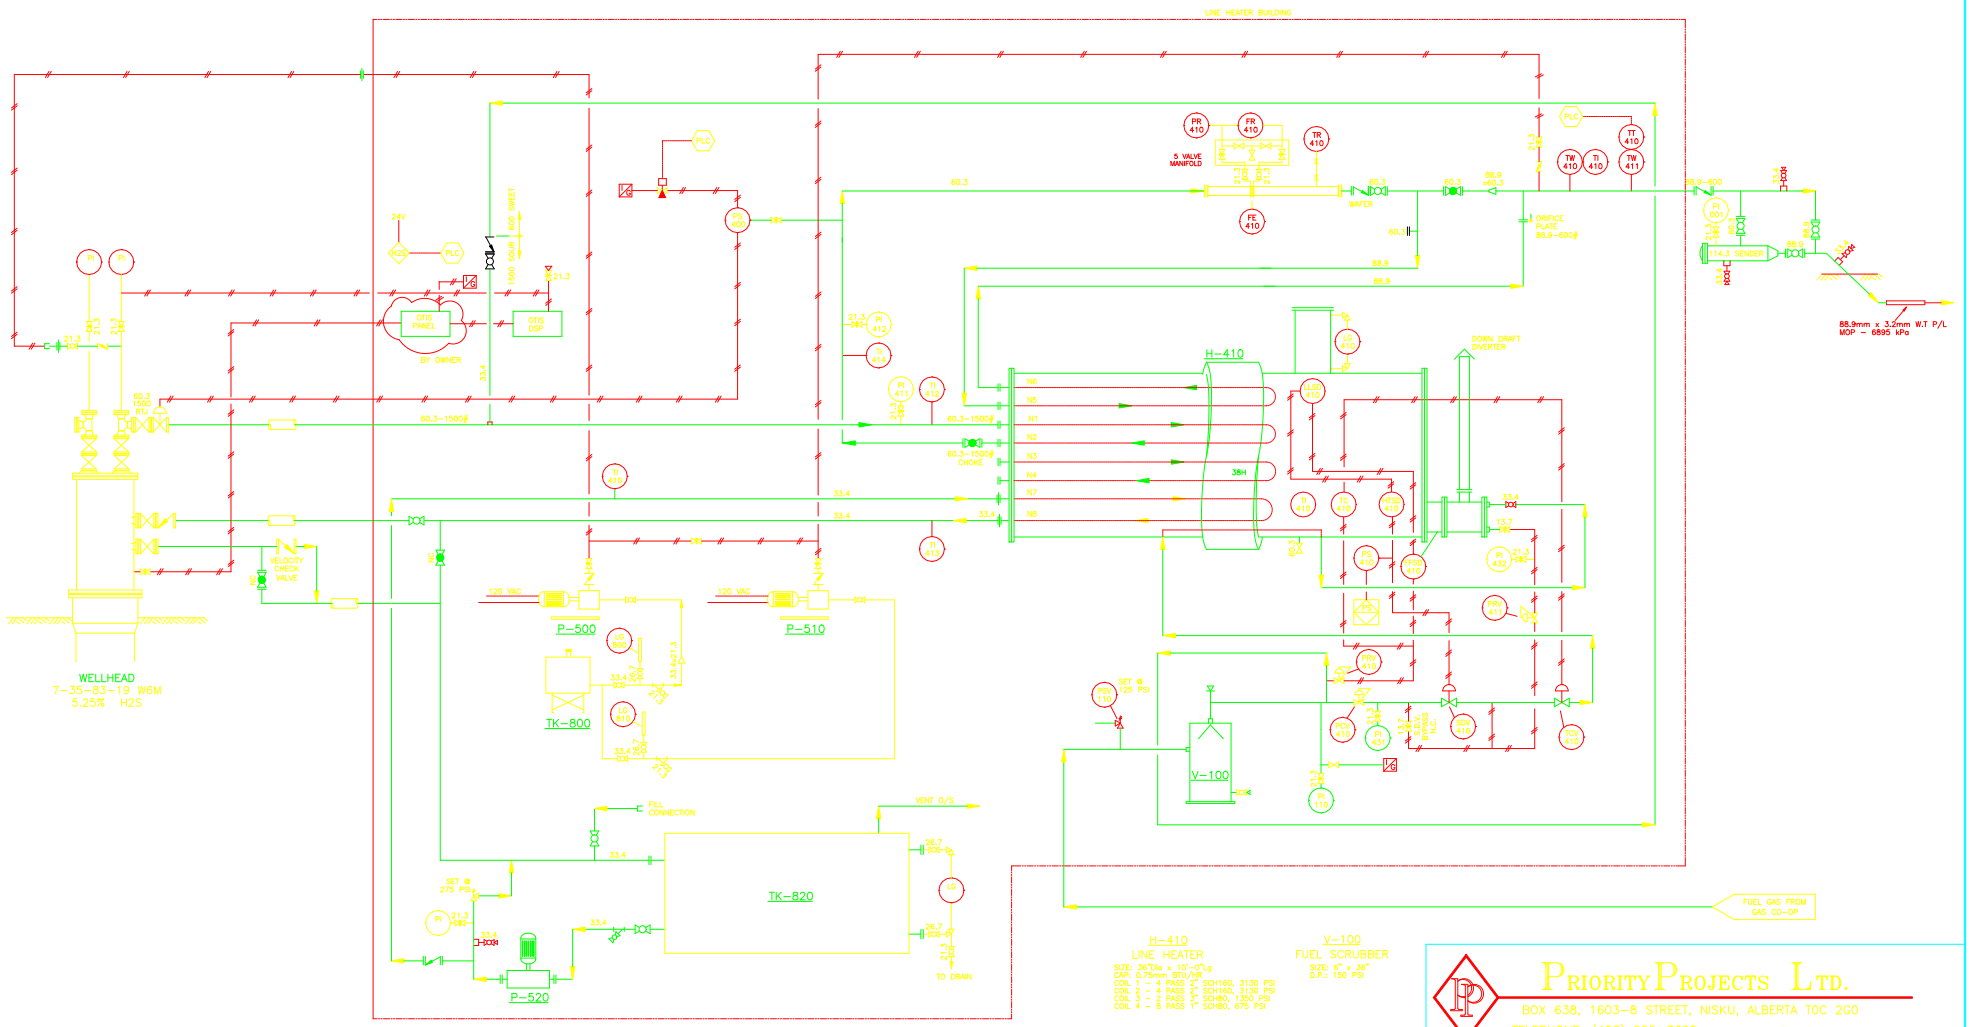

H-410
LINE HEATER
SIZE: 36"Dia x 10'-0"lg
CAP: 0.75mmm BTU/HR
COIL 1 - 4 PASS 2" SCH160, 3130 PSI
COIL 2 - 4 PASS 2" SCH160, 3130 PSI
COIL 3 - 2 PASS 3" SCH80, 1395 PSI
COIL 4 - 8 PASS 1" SCH80, 675 PSI

V-100
FUEL SCRUBBER
SIZE: 8" x 36"
D.P.: 150 PSI

P-500
METHANOL INJ PUMP
MODEL: ELECTRIC

P-510
METHANOL INJ PUMP
MODEL: ELECTRIC

P-520
HOT OIL CIRC PUMP
MODEL: VIKING 190 QG
STYLE: 1" NPT 10 USG/M

TK-800
METHANOL TANK
CAP: 500 GAL
MATL: PLASTIC

TK-820
HOT OIL TANK
CAP: 500 US GAL.

PRIORITY PROJECTS LTD.
BOX 638, 1603-8 STREET, NISKU, ALBERTA T0C 2G0
TELEPHONE: (403) 955-3320 FAX: (403) 955-25561

NO.	DATE	REVISIONS	DRAWN	CHECK	DESIGN	APPR.
1	99 12 10	AS BUILT	SPB			
0	99 11 05	FOR FABRICATION	SPB			
			DRAFTING		ENGINEERING	

WELLHEAD LINEHEATER
Ft. ST. JOHN
FLOW DIAGRAM

CUSTOMER NAME	SCALE	DRAWING NUMBER	REV.
KAISER ENERGY LTD	NTS	5295-100	1
CUSTOMER DWG NUMBER: 7-35-83-19 W6M			