


E-444
SAMPLE LINE COOLER
 A/C MODEL : PW2047
 316SS TUBES (18 SQ. FT.)
 TUBE SIDE : 1310 KPa. @ 200° C
 SHELL SIDE : 1500 KPa. @ 200° C

P-586
SAMPLE BOX PUMP
 WARREN RUPP
 SANDPIPER
 S15B

V-113
FREE WATER KNOCKOUT
 SIZE: 3048 O.D. X 15240 S/S
 DESIGN: 1309 kPag @ 200° C

E-445
SAMPLE LINE COOLER
 A/C MODEL : PW2047
 316SS TUBES (18 SQ. FT.)
 TUBE SIDE : 1310 KPa. @ 200° C
 SHELL SIDE : 1500 KPa. @ 200° C

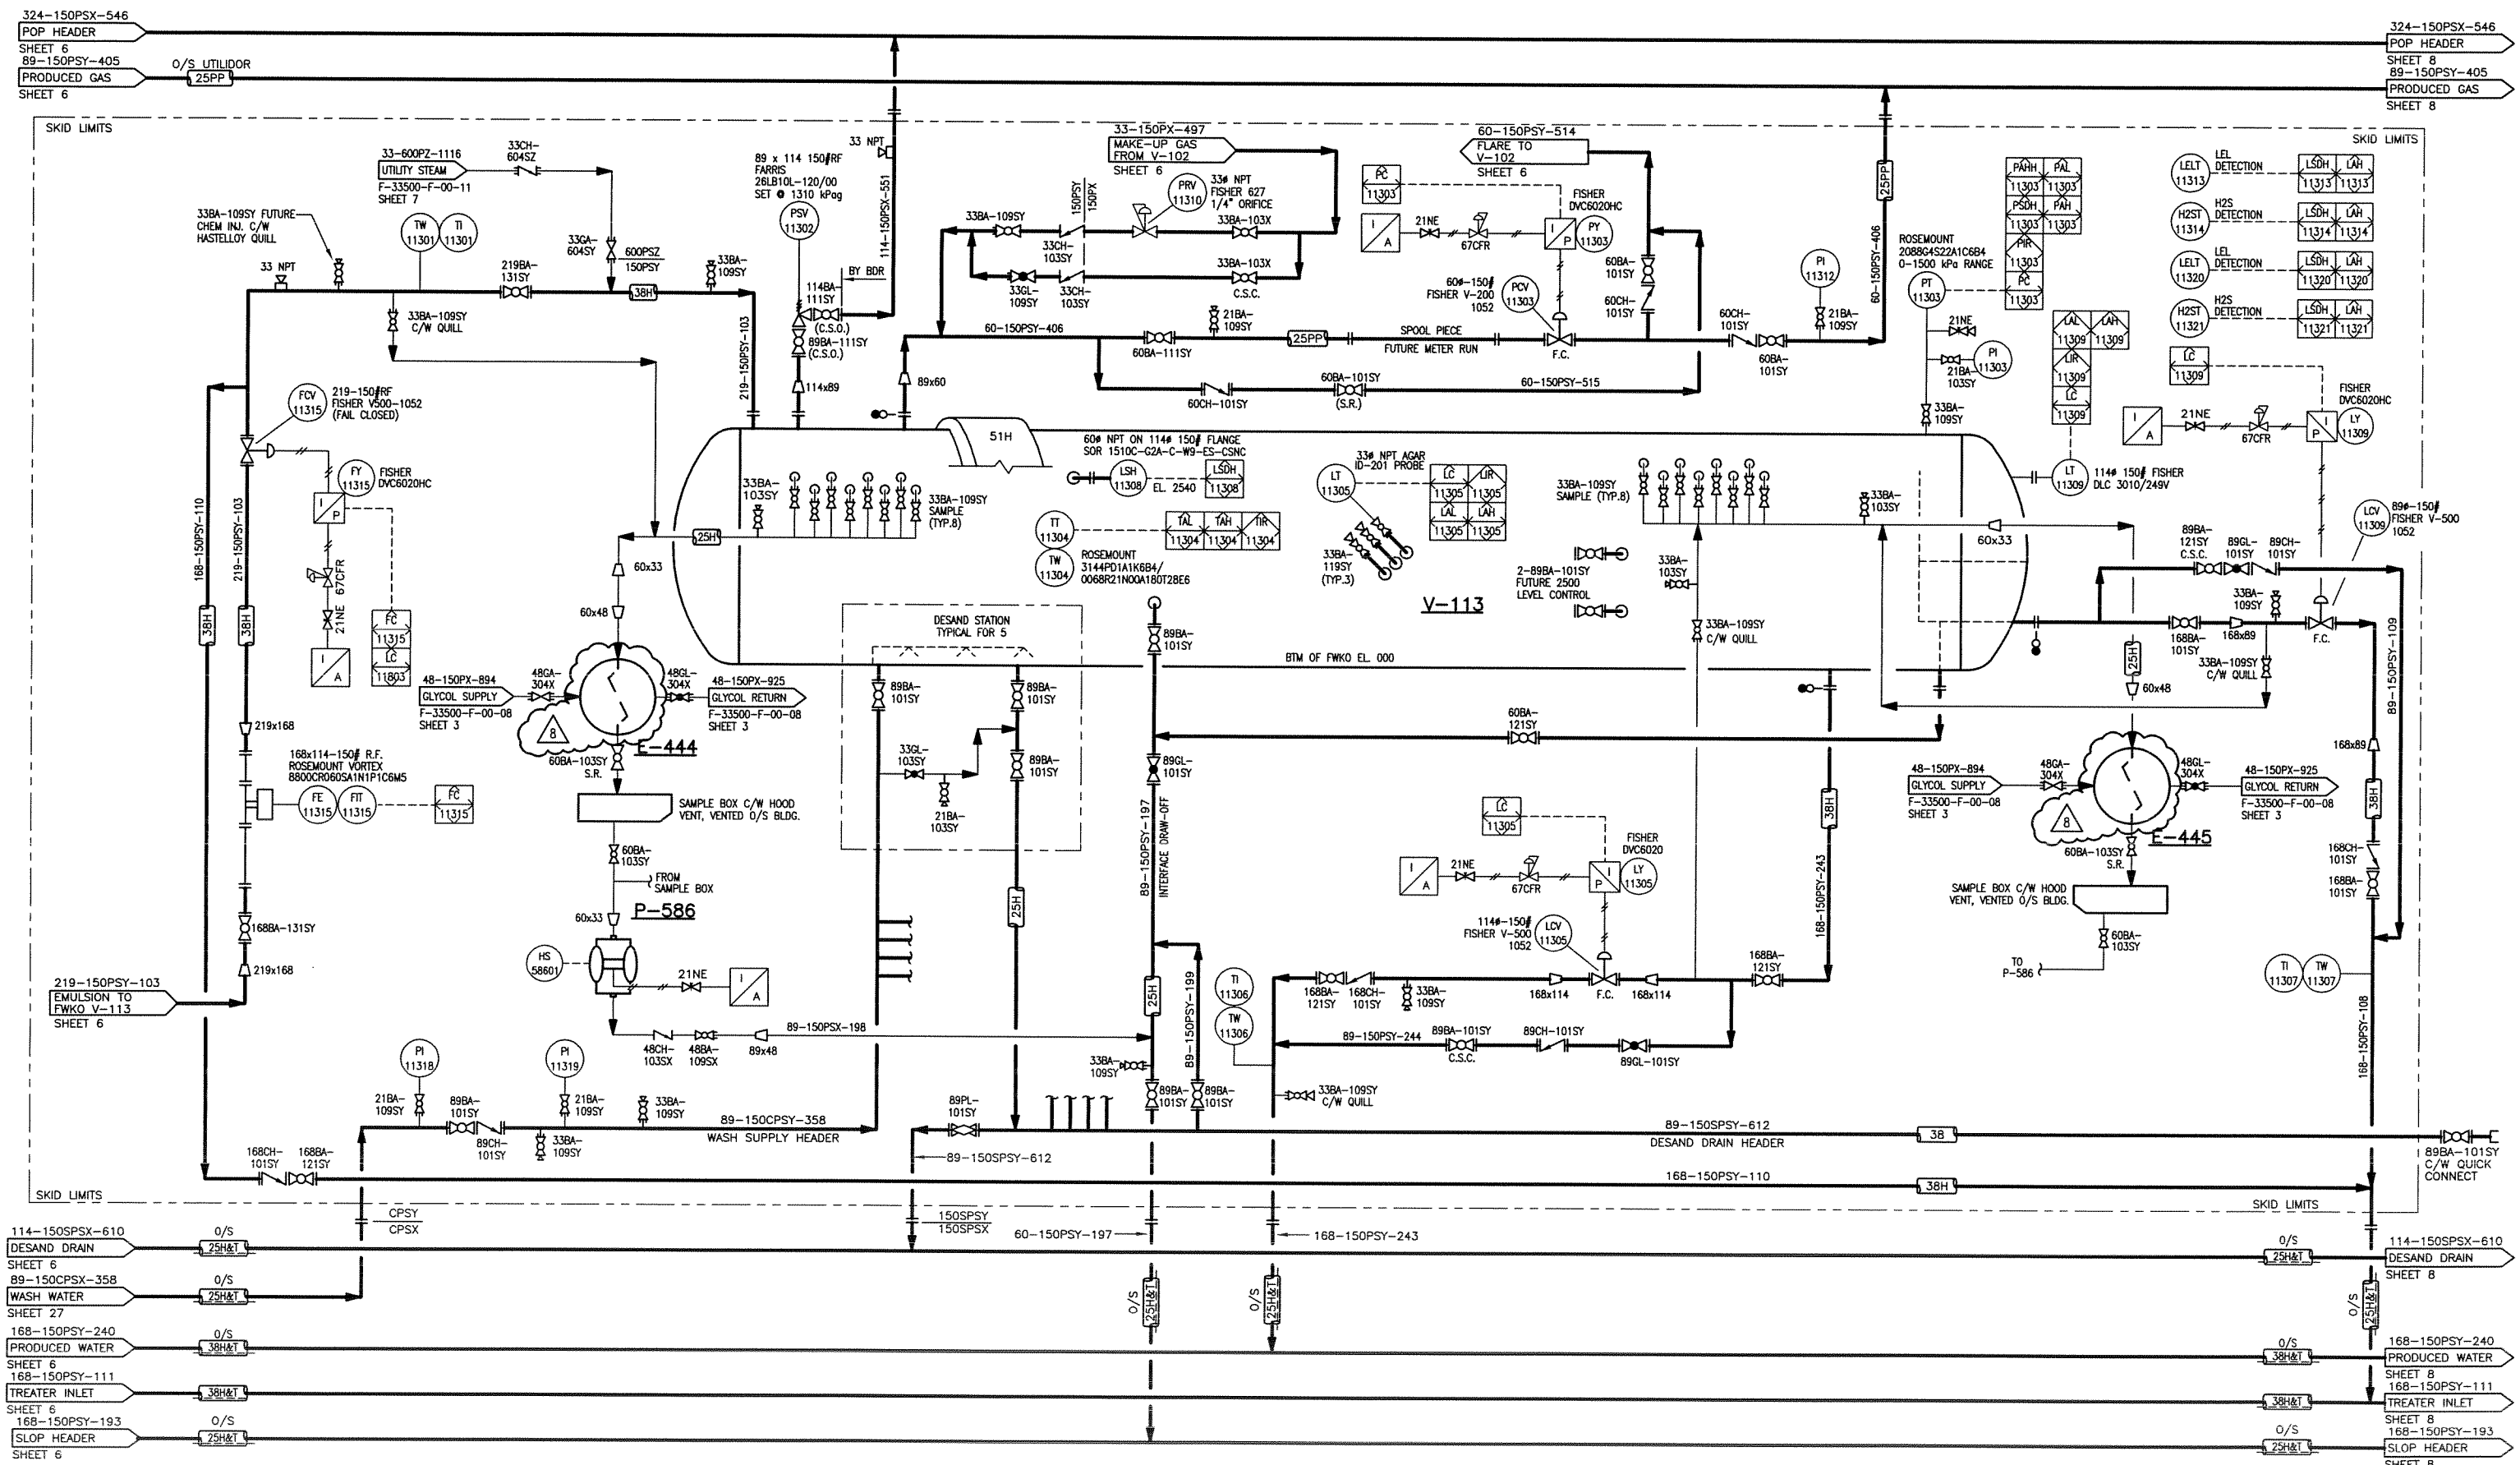

| SHEET NUMBER | DRAWING NUMBER | REV |
|--------------|-----------------|-----|
| 7 OF 36 | F-33500-F-00-06 | 8 |