


THIS DRAWING IS THE EXCLUSIVE PROPERTY OF NEXT COMPRESSION, AND CANNOT BE REPRODUCED OR DISTRIBUTED WITHOUT THE EXPRESS WRITTEN PERMISSION OF NEXT COMPRESSION.

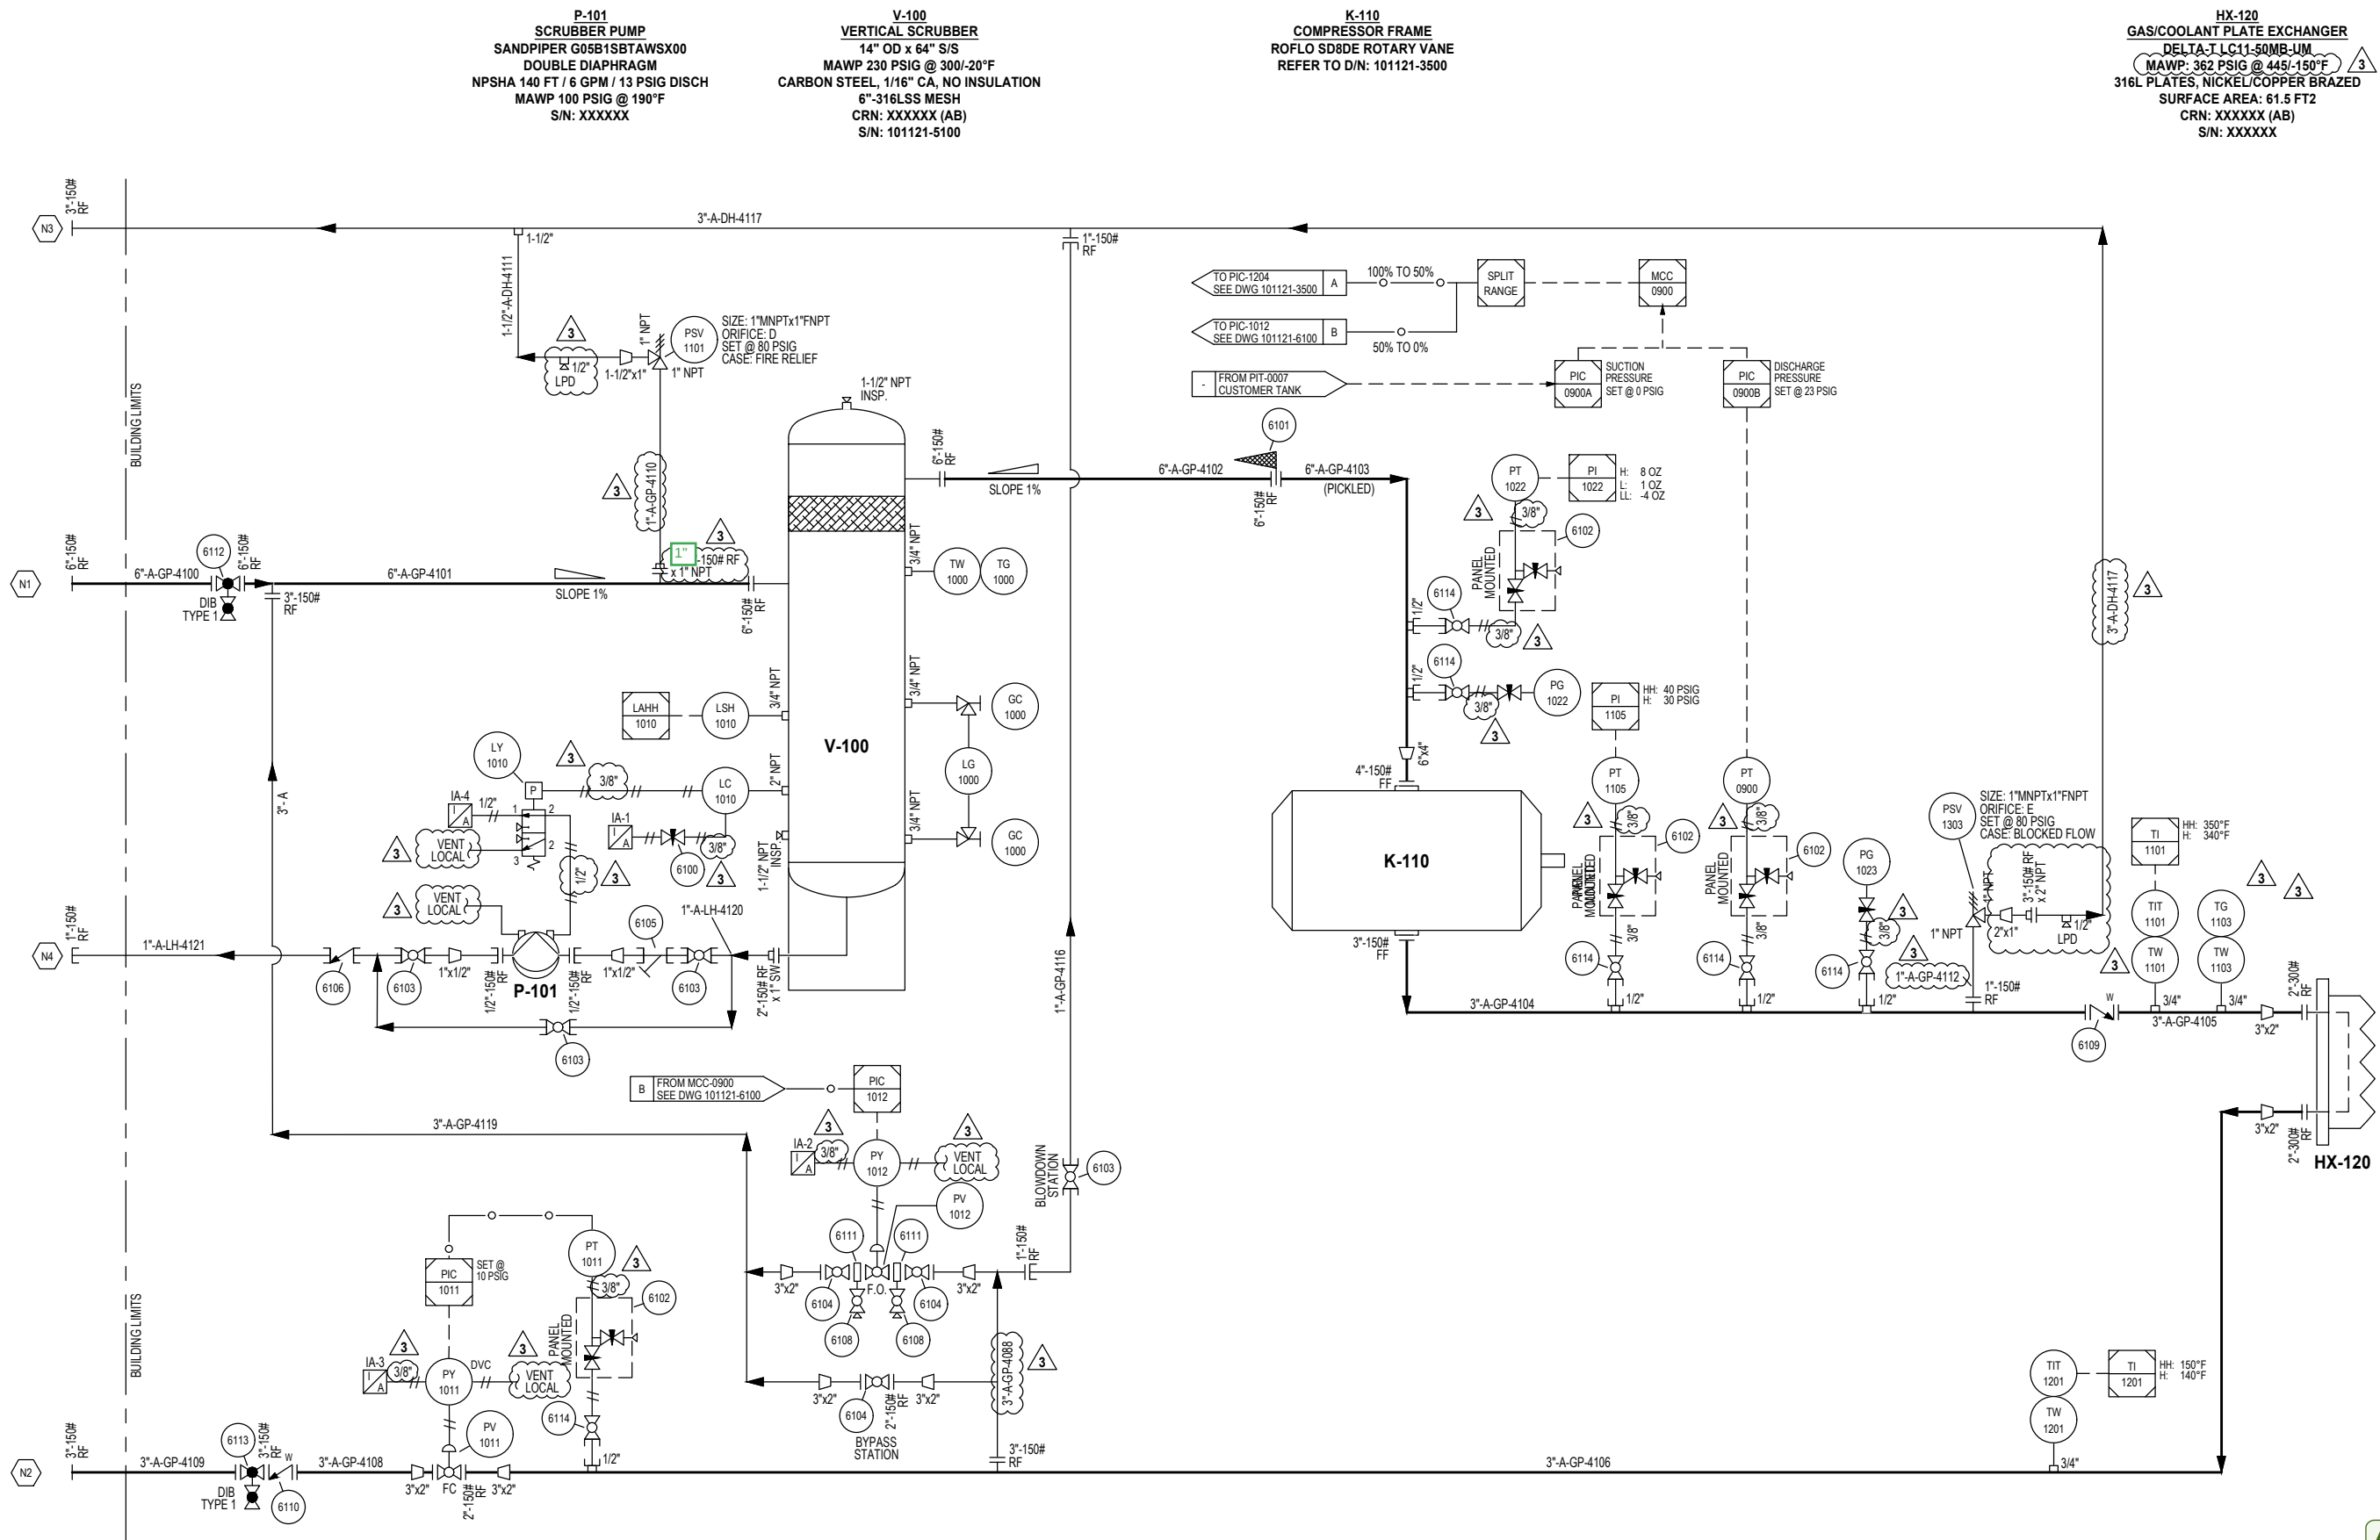

APPROVED
By Kevin Huartson at 9:44 am, Nov 24, 2023

SKID EDGE CONNECTIONS		
TAG	DESCRIPTION	RATING
N1	VENT GAS INLET	6"-150# RF
N2	PROCESS OUTLET	4"-150# RF
N3	OPEN TO ATMOSPHERE	3"-150# RF
N4	RECOVERED LIQUIDS	1"-150# RF

- NOTES:**
- ALL PRESSURE PIPING SYSTEMS WELDED OR THREADED AND TUBING TO COMPLY WITH B31.3 EDITION (2022).
 - REFER TO CNRL PIPING SPEC. FOR RADIOGRAPHY REQ'S & MATERIALS.
 - ELECTRICAL CLASSIFICATION: CSA CLASS 1, ZONE 2, GROUP IIA.
 - REFER TO PROJECT SPOOL DRAWINGS FOR WPS AND WELD DETAILS.

REVISIONS				
REV	DESCRIPTION	DATE	BY	APPR
A	ISSUED FOR HAZOP	3/8/23	RR	KH
B	ISSUED FOR APPROVAL	3/30/23	RR	KH
0	ISSUED FOR CONSTRUCTION	5/26/23	RR	KH
1	REM V-130, DISCH. SIZE WAS 4, PSV HEADER SIZE WAS 2-1/2"	6/21/23	RR	KH
2	REMOVED VESSEL TAG	8/11/23	RR	KH
3	ADDED TUBE SIZING, UPDATED PSV TAKE-OFFS, LINES & EQUIP.	11/20/23	RR	KH

NEXT
COMPRESSION

261122 WAGON WHEEL CRESCENT, ROCKY VIEW COUNTY
ALBERTA, CANADA. T4A-0E2. 1(800) 256-1598
WWW.NEXTCOMP.CA

LABOUR CODES:	MATERIAL CODES:
F6100 -	F6101 -
- -	- -

TITLE: PROCESS DIAGRAM			
PROJECT: CANADIAN NATURAL RESOURCES LTD			
VRU ROFLO 60 HP ELECTRIC SMITH, ALBERTA-LSD: TBA			
ENG. BY: K.HUARTSON	PROJECT NO: 101121/2/3/4/5/6/7		
DRAWN BY: R.ROVETO	CLIENT REF. NO: -		
DRAWN DATE (MM/DD/YY): 02/07/23	SHEET: 1 OF 1	DRAWING NO: 101121-6100	REV: 3