


PSV DATA
 MFG: FARRIS
 MODEL: 26EA13-12015615
 SERIAL: CE-38328-A10
 SET PRES: 9929 kPa
 CAPACITY: 5650 SCFM
 SERVICED BY: UNIFIED
 SERVICE DATE: 03/14/05
 SIZE: 1" x 2"
 CODE STAMP: UV
 BLOCK VALVE: NO
 CRN: N/S
 LOCATION: LOWER SHELL
 TAG: 1346F

PSV DATA
 MFG: FARRIS
 MODEL: 26DA13-120
 SERIAL: CE-407214-2-A10
 SET PRES: 9929 kPa
 CAPACITY: 3770 SCFM
 SERVICED BY: UNIFIED
 SERVICE DATE: 03/14/05
 SIZE: 1" x 2"
 CODE STAMP: UV
 BLOCK VALVE: NO
 CRN: 0G0269.5C
 LOCATION: INLET PIPING
 TAG: 1345F

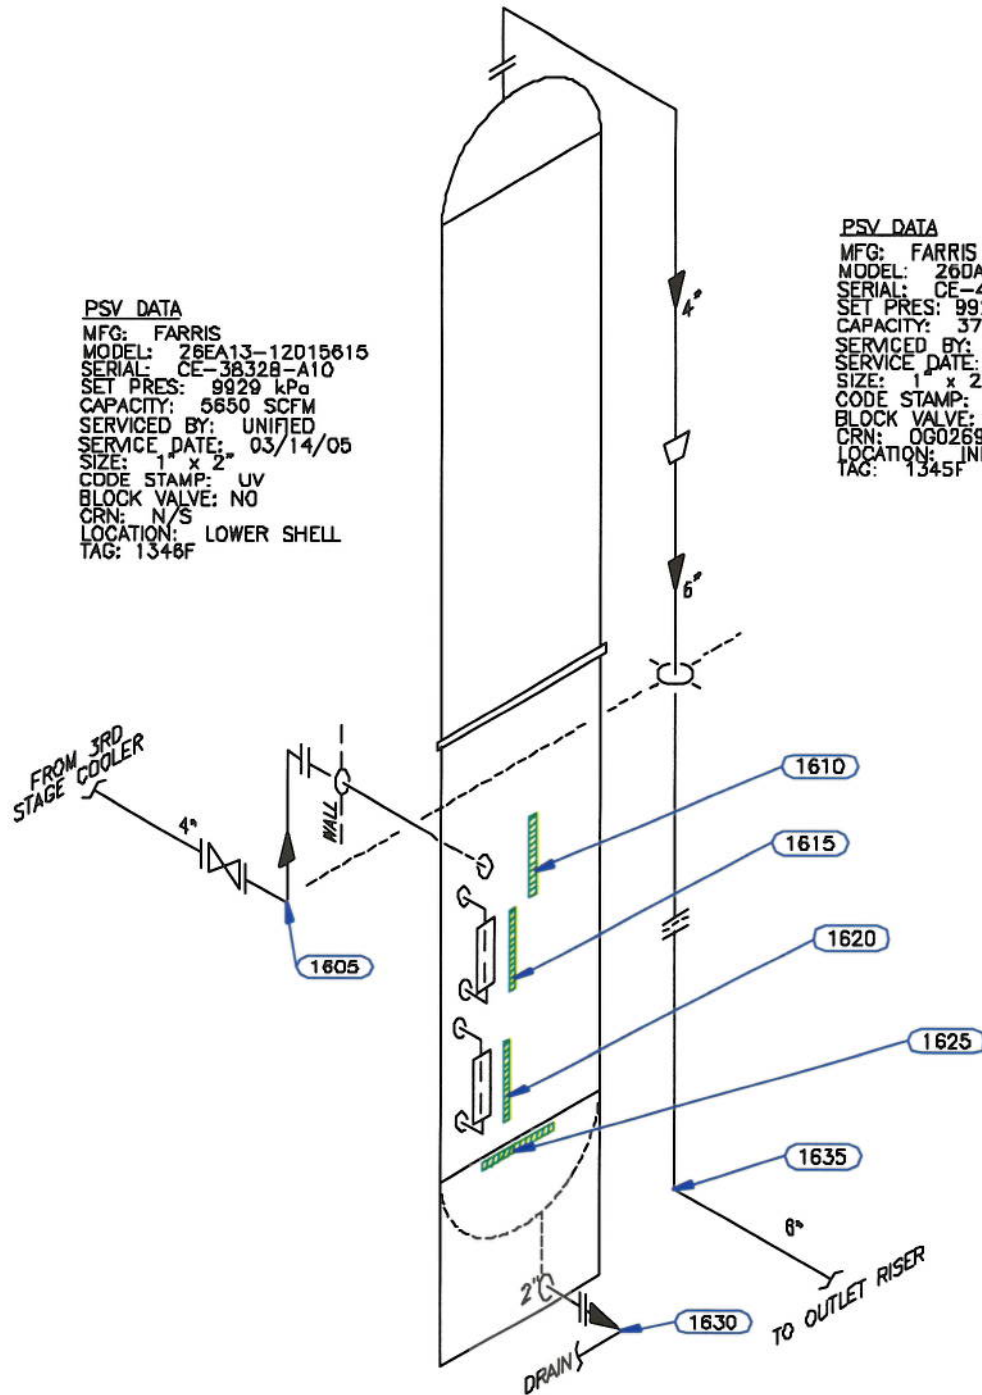

Equip. No. _____ Prov. Reg. No. **2944410** C.R.N. **H-5277.1** Serial No. **930-5055-01** Yr. Inst. _____
 Code/Div. **ASME VIII DIV 1** Size: **24 in OD x 28 ft** Manufacturer: **ALCO GAS & OIL** Yr. Btl. **1994**
 C. Stamp: **U** Service: **SOUR** PWHT: **YES** Radiography: **RT-1** Insulated: **NO**

Design & Materials Data

HEAD:
 Top Mat'l. **SA 516 70 N** Top Nom. **27.7 mm** Top C.A. _____
 Btm. Mat'l. _____ Btm. Nom. _____ Btm. C.A. _____
CHANNEL:
 Material: _____ Nominal: _____ C.A. _____
BOOT
 Head Mat'l. _____ Head Nom. _____ Head C.A. _____
 Shell Mat'l. _____ Shell Nom. _____ Shell C.A. _____
SHELL
 Material: **SA 516 70 N** Nominal: **28.6 mm** C.A. _____
 MAWP Shell Side: **9929 kPa** @ Temp. **52°C**
 MAWP Tube Side: _____ @ Temp. _____

CLIENT	CANADIAN NATURAL RESOURCES	
FACILITY	CLEARHILLS COMPRESSOR STATION LSD 01-14-87-13 W6M	
ITEM	3 PHASE GLYCOL CONTRACTOR	
BY: LL	DATE: 11/2005	DWG.# 16

UTS DATA

CLIENT: CANADIAN NATURAL RESOURCES
EQUIPMENT: 3 PHASE CLYCOL CONTRACTOR
CRN#: H-5277.1
PROV REG: A 2944440

FACILITY: CLEAR HILLS COMPRESSOR STATON
SERVICE: SOUR
LOCATION: 1-14-87-13 W6M
RTD JOB #: 2321461

TESTED ON STREAM

REFER TO DRAWING: 16

Test Point	THICKNESS DATA		Flag	Crit	C.A.	Nom.	Short Term	Long Term	Ave. mm/py	Flag Date
1610										
Description: MID SHELL										
2005 9										
Min. Thick.	30.1		28.6			28.6				L
Average:	30.3						0	0		L
Analysis:										
1615										
Description: MID SHELL										
2005 9										
Min. Thick.	30.4		28.6			28.6				L
Average:	30.5						0	0		L
Analysis:										
1620										
Description: LOWER SHELL										
2005 9										
Min. Thick.	30.1		28.6			28.6				L
Average:	30.3						0	0		L
Analysis:										
1625										
Description: BOTTOM HEAD										
2005 9										
Min. Thick.	31		27.7			27.7				L
Average:	31.6						0	0		L
Analysis: 2005/09 MIN SCAN AT SKIRT WELD										

UTS DATA

CLIENT: CANADIAN NATURAL RESOURCES
EQUIPMENT: 3 PHASE GLYCOL CONTRACTOR PIPING
CRN#:
PROV REG:
TESTED ON STREAM

FACILITY: CLEAR HILLS COMPRESSOR STATON
SERVICE: SOUR
LOCATION: 1-14-87-13 W6M
RTD JOB #: 2321461
REFER TO DRAWING: 16

Test Point	THICKNESS DATA				Flag	Crit	C.A.	Nom.	Short Term	Long Term	Ave. mm/py	Flag Date
<hr/>												
1605												
Description:	4" 90° ELBOW											
	2005 9											
Min. Thick.	7.7				7.53		1.1	8.6				L
Average:	7.9								0	0		L
Analysis:												
<hr/>												
1630												
Description:	2" 90° ELBOW											
	2005 9											
Min. Thick.	9				9.71		1.4	11.1				L 2005
Average:	9.3								0	0		L 2005
Analysis:												
<hr/>												
1635												
Description:	6" 90° ELBOW											
	2205 9											
Min. Thick.	8.5				9.63		1.4	11				L
Average:	8.8								0	0		L
Analysis:												
<hr/>												
<hr/>												
<hr/>												