


**PSV DATA**

MFG: MERCER  
 MODEL: 8114421117R  
 SERIAL: 21843  
 SET PRES: 9929 kPa  
 CAPACITY: 4956 scfm  
 SERVICED BY: UVL  
 SERVICE DATE: 07/2005  
 SIZE: 1in x 1in  
 CODE STAMP: UV/NB  
 BLOCK VALVE: NO  
 CRN: OG8841.5C  
 LOCATION: SHELL  
 TAG: UVL 20307G

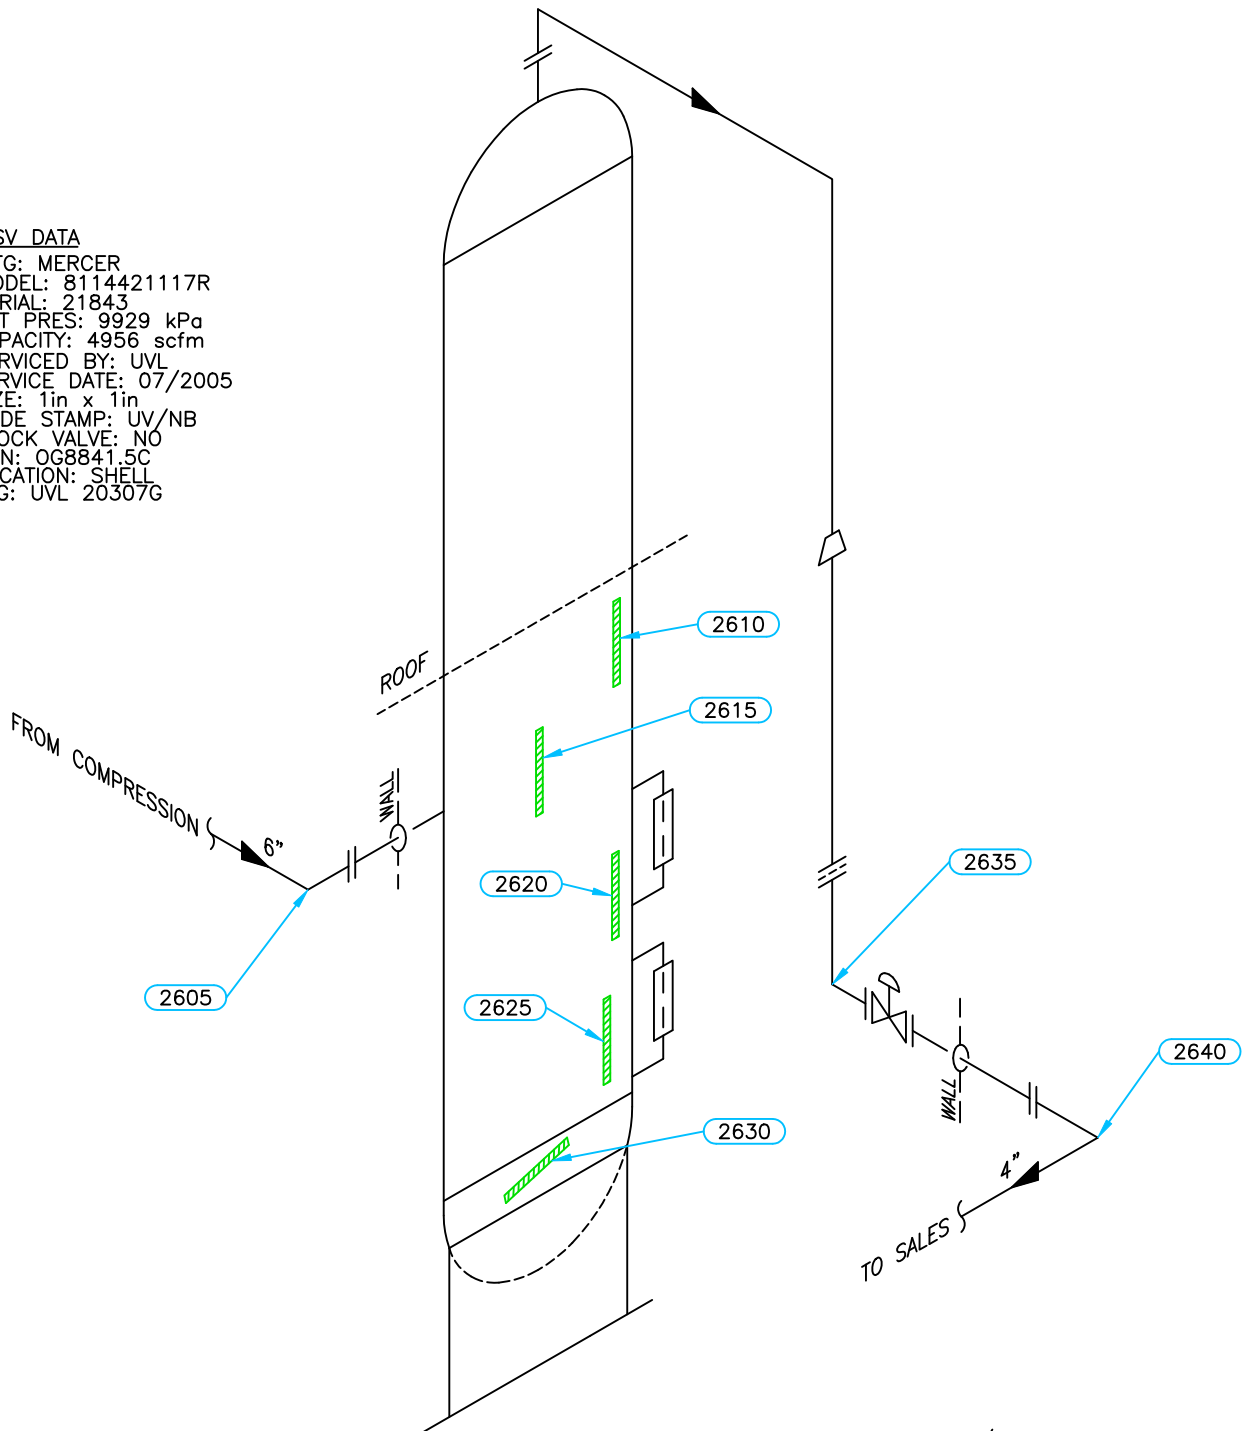

2014/05 NOTE: NOT IN SERVICE

Equip. No. \_\_\_\_\_ Prov. Reg. No. **A 3027767** C.R.N. **M-6214.2** Serial No. **94C519607** Yr. Inst. \_\_\_\_\_  
 Code/Div. **ASME VIII, DIV1** Size: **21.5in x 28ft** Manufacturer: **ALCO GAS & OIL** Yr. Bld. \_\_\_\_\_  
 C. Stamp: **U** Service: **SWEET** PWHT: **NIL** Radiography: **RT-2** Insulated: **NO**

**Design & Materials Data**

**HEAD:**  
 Top Mat'l. **SA 516 70N** Top Nom. **29.7mm** Top C.A. **1.6mm**  
 Btm. Mat'l. **SA 516 70N** Btm. Nom. **29.7mm** Btm. C.A. **1.6mm**  
**CHANNEL:**  
 Material: \_\_\_\_\_ Nominal: \_\_\_\_\_ C.A. \_\_\_\_\_  
**BOOT**  
 Head Mat'l. \_\_\_\_\_ Head Nom. \_\_\_\_\_ Head C.A. \_\_\_\_\_  
 Shell Mat'l. \_\_\_\_\_ Shell Nom. \_\_\_\_\_ Shell C.A. \_\_\_\_\_  
**SHELL**  
 Material: **SA 516 70N** Nominal: **31.8mm** C.A. **1.6mm**  
 MAWP Shell Side: **9929 kPa** @ Temp. **38°C**  
 MAWP Tube Side: \_\_\_\_\_ @ Temp. \_\_\_\_\_

CLIENT	CANADIAN NATURAL RESOURCES LTD	
FACILITY	GOLD CREEK COMPRESSOR STATION LSD 09-20-67-05 W6M	
ITEM	GLYCOL CONTACTOR	
BY: CM	DATE: 06/2010	DWG.# 26

# UTS DATA

**CLIENT** CANADIAN NATURAL RESOURCES  
**EQUIPMENT** GLYCOL CONTACTOR  
**CRN#** M-6214.2  
**PROV REG** A 3027767  
**TESTEI** ON STREAM

**FACILITY** GOLD CREEK COMPRESSOR STATION  
**SERVICE** SWEET  
**LOCATION** 09-20-67-05 W6M  
**RTD JOB #** 10.114550  
**REFER TO DRAWING** 26

Test Point	THICKNESS DATA				Flag	T-Min	C.A.	Nom.	Short Term	Long Term	Ave. mm/py	Retirement Date
2610												
Description: MID SHELL												
2010 6												
Min. Thick.	32.5				30.20		1.6	31.80			0	0
Average:	32.6											
Analysis:												
2615												
Description: MID SHELL												
2010 6												
Min. Thick.	32.5				30.20		1.6	31.80			0	0
Average:	32.7											
Analysis:												
2620												
Description: MID SHELL												
2010 6												
Min. Thick.	32.7				30.20		1.6	31.80			0	0
Average:	32.8											
Analysis:												
2625												
Description: LOWER SHELL												
2010 6												
Min. Thick.	32.7				30.20		1.6	31.80			0	0
Average:	32.8											
Analysis:												
2630												
Description: BOTTOM HEAD												
2010 6												
Min. Thick.	30.4				28.10		1.6	29.70			0	0
Average:	31											
Analysis:												

# UTS DATA

**CLIENT** CANADIAN NATURAL RESOURCES  
**EQUIPMENT** GLYCOL CONTACTOR PIPING  
**CRN#**  
**PROV REG**  
**TESTEI** ON STREAM

**FACILITY** GOLD CREEK COMPRESSOR STATION  
**SERVICE** SWEET  
**LOCATION** 09-20-67-05 W6M  
**RTD JOB #** 10.114550  
**REFER TO DRAWING** 26

Test Point	THICKNESS DATA				Flag	T-Min	C.A.	Nom.	Short Term	Long Term	Ave. mm/py	Retirement Date
<b>2605</b>												
Description: <b>6" 90° ELBOW</b>												
2010 6												
Min. Thick.	8.1				9.63	6.1	1.4	11.00				
Average:	8.2								0	0		
Analysis:												
<b>2635</b>												
Description: <b>4" 90° ELBOW</b>												
2010 6												
Min. Thick.	7.4				7.53	4.7	1.1	8.60				
Average:	7.7								0	0		
Analysis:												
<b>2640</b>												
Description: <b>4" 90° ELBOW</b>												
2010 6												
Min. Thick.	8				7.53		1.1	8.60				
Average:	8.2								0	0		
Analysis:												