




CORROSION INSPECTION SERVICES

Page _____ of _____

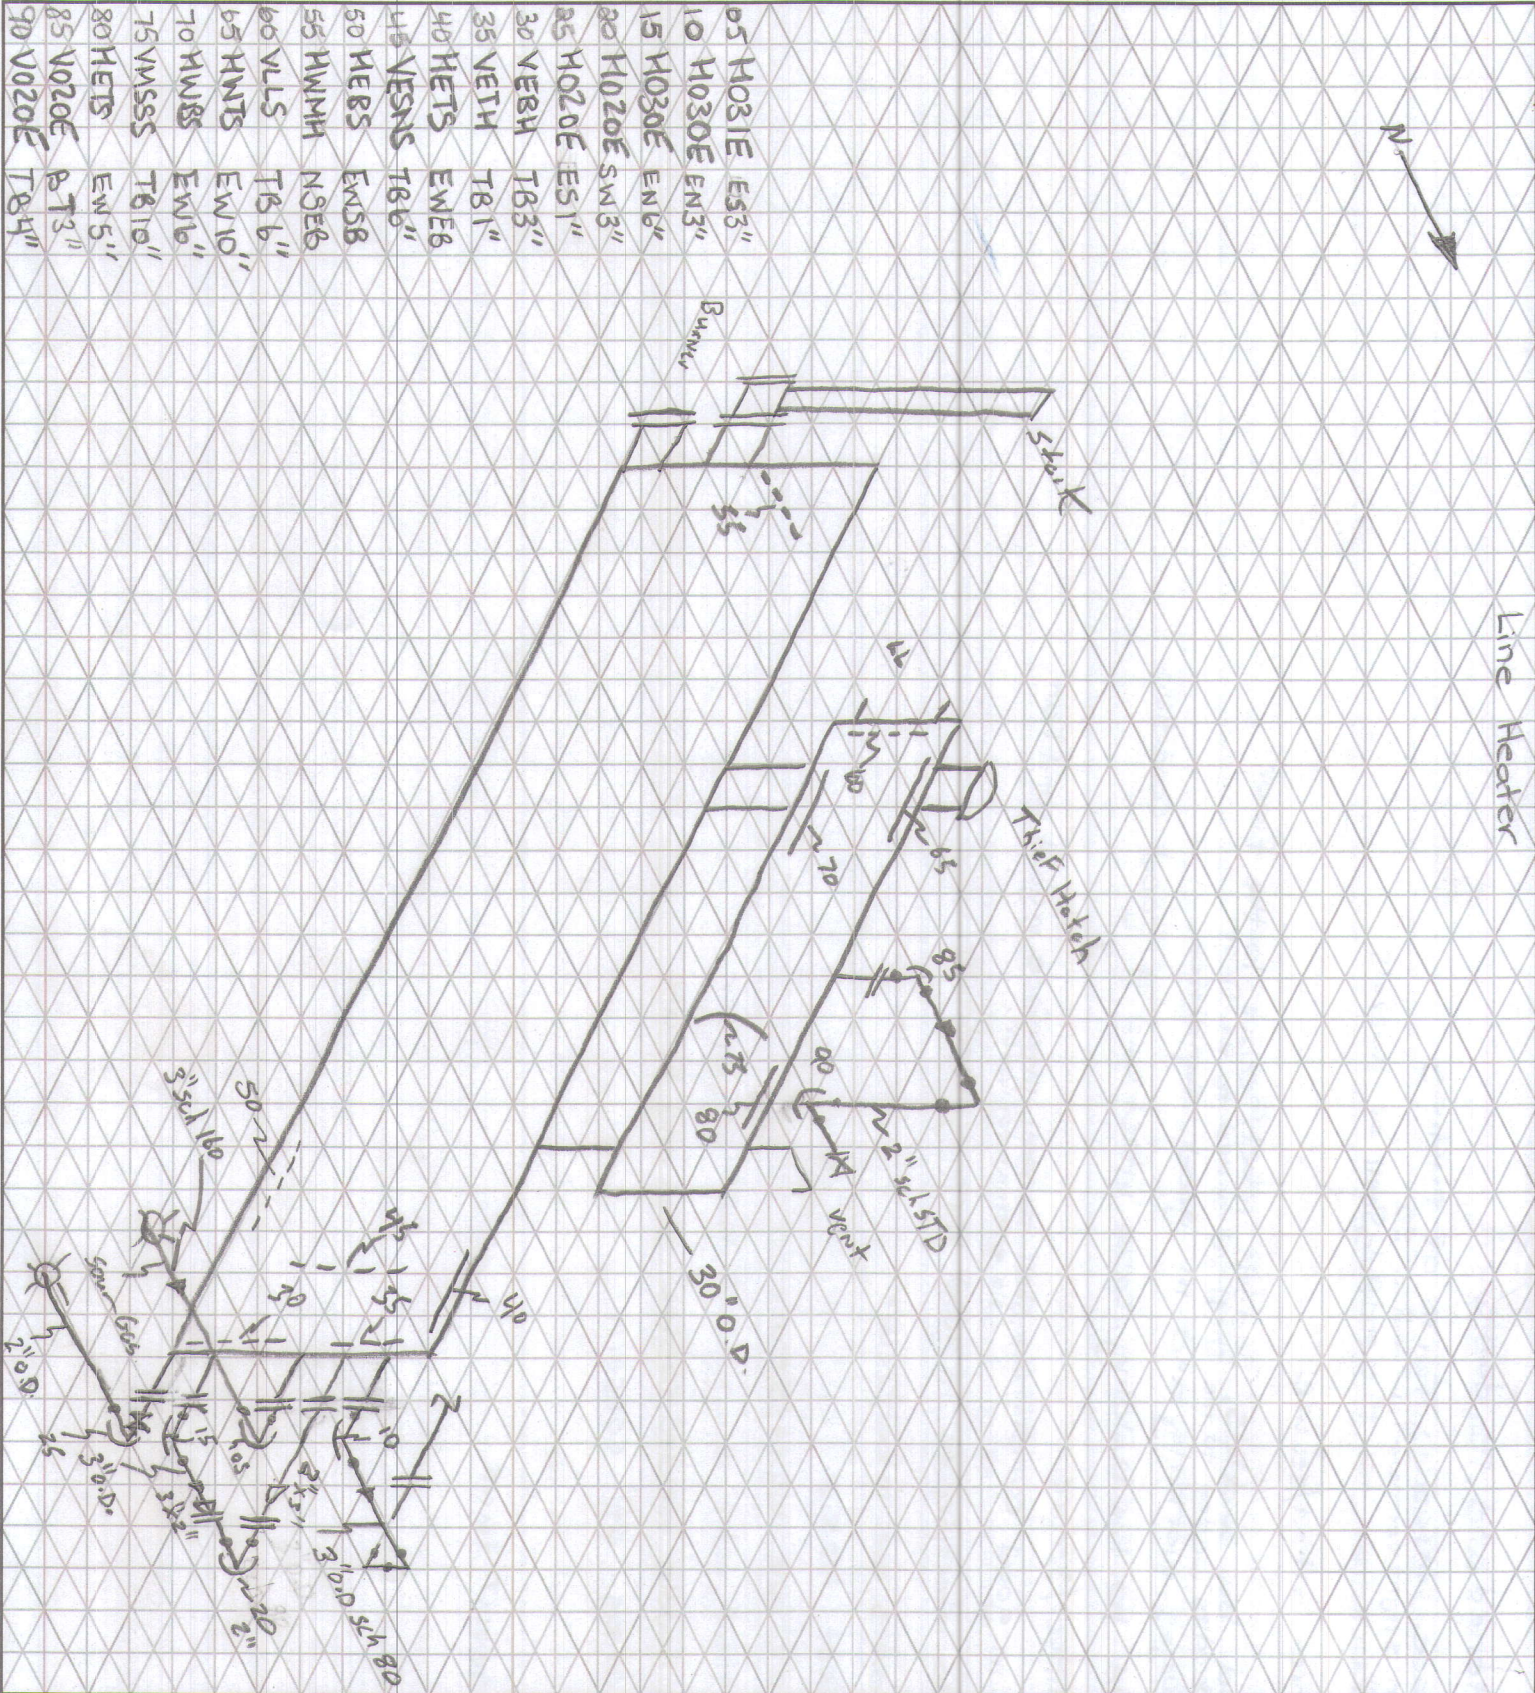

CUSTOMER: CNRL FACILITY: _____ LSD: 05-21-12-14W4M
 P & ID: _____ DRAWN BY: B. Verge DATE: Mar. 28/12 DRAWING NO. _____

VESSEL INFORMATION:
 Equip. No. _____ Pro. Reg. No. (A) A0438939 C.R.N. N9595,213 Serial No. 2133CB3 Yr. Inst. _____
 Code/Div. _____ Size: 60" ID / O.D.X: _____ Manufacturer: Pains oil LTD. Yr. Blt. 1998
 C. Stamp: no Service: Sour PWHT: HT J.E.: _____ Radiography: RT-100% Insulated: _____

HEAD: 30" C.D on 50/50 **SHELL:**
 Top Mat'l. SA106-B Top Nom: _____ Top C.A. _____ Material: SA106-B Nominal: _____ C.A. 1.6mm
 Btm Mat'l. _____ Btm Norm: _____ Btm C.A. _____

BOOT: **CHANNEL:**
 Head Mat'l: _____ Head Nom. _____ Head C.A. _____ Top Mat'l. _____ Top Nom. _____ Top C.A. _____
 Shell Mat'l: _____ Shell Nom. _____ Shell C.A. _____ Btm Mat'l. _____ Btm Norm. _____ Btm C.A. _____

MAWP Shell Side: PRE 21057 KPa @ Temp. 93°C ^{post} MAWP Tube Side: _____ @ Temp. _____
PIPING INFORMATION: PRE 13500 K.P.a @ 93°C
 Circuit. No. _____ Line No. (s) **(PLEASE PUT LINE NUMBERS ON APPLICABLE LINES ON THE DRAWING)**
 Piping Class: _____ Service: _____ Yr. Blt. _____
 MAWP: _____ @ Temp. _____ Size & Schedule of Piping **(PLEASE PUT APPROPRIATE SIZES AND SCHEDULES OF PIPING ON DRAWING)**