


ITEM:

LINE HEATER

A 2825892

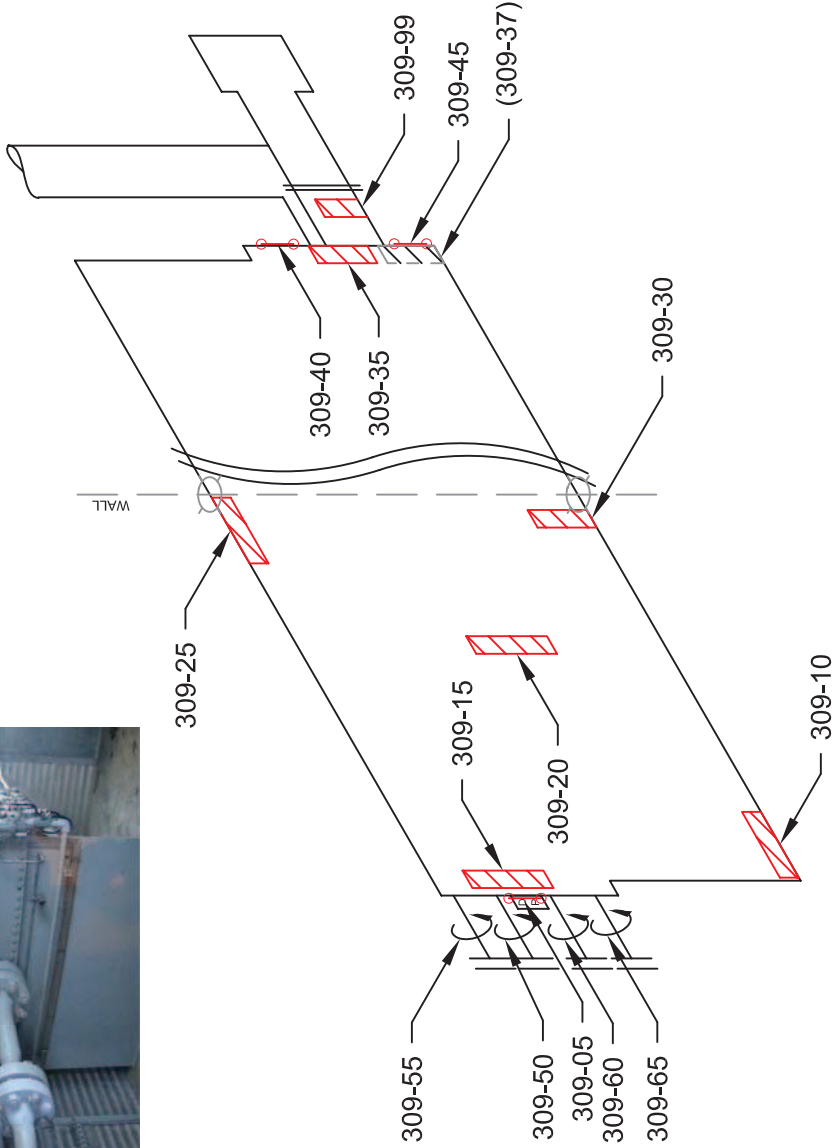

TECHNICIAN:

STEPHEN KEELEY
SNT LEVEL II
CGSB 48.9712
LEVEL II # 12288

DATE: 01/31/10

DWG # 309

CLIENT:

BARRICK ENERGY INC.

LSB:

06-08-069-21-W5M

INSPECTOR:

MWS

LOCATION:

STURGEON LAKE SOUTH

DISTRICT UNIT:

FIELD

BLDG/SKID:

PKG 55539

PROCESS:

SWEET

CODE:

ASME SEC VIII DIV 1

SPECIFICATION:

AS PER ASME SE 797

TECHNIQUE:

UT 1-1, REV. 1

METHOD:

UT CONTINUOUS / A SCAN

SURFACE COND:

PAINTED

SURFACE TEMP:

AMBIENT

VESSEL INFORMATION

VESSEL #:

A 2825892

CRN #:

2102.2

SERIAL #:

1216 H1

MANUFACTURER:

PLAINS OIL LTD.

DATE BUILT:

1994

CLIENT ID / TAG:

-

M.A.W.P.:

5 PSI/ COIL 1 & 2 5000 PSI

M.A.W.T.:

200 °F

JOINT EFFICIENCY/RT:

100%

STRESS RELIEVED:

YES

INSULATED:

YES (OUTSIDE, PART)

MANWAY:

YES

VESSEL SPECIFICATIONS

	OD	NOMINAL	MATERIAL	CA
VESSEL HEAD	72"	.375"	SA-516-70	.125"
VESSEL SHELL	72"	.250"	SA-516-70	.125"
BOOT HEAD	-	-	-	-
BOOT SHELL	-	-	-	-

COMMENTS:

PROJECT:

C40290