


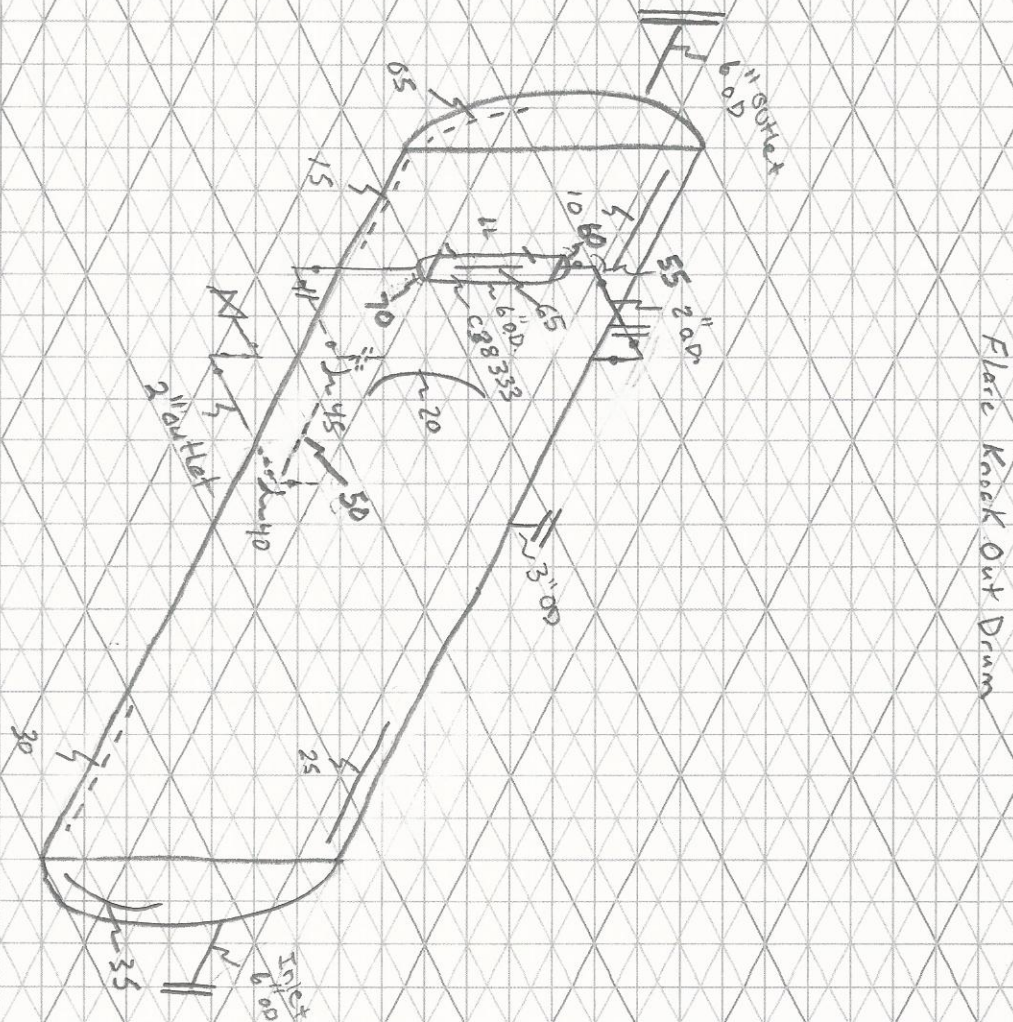

CORROSION INSPECTION SERVICES

Page of

- 05 VSRBH TB 3"
- 10 HSTS NS EB
- 15 HSBS NS EB
- 30 VLLS TB 10"
- 35 HNTS NS SB
- 30 HNS NS SB
- 35 VNBH TB 2"
- 40 VOROE TB EB
- 45 VOROE TB 3"
- 50 HMB5 NS 7"
- 55 VOROE TB 5"
- 60 VTEH TB 2"
- 65 VLLS TB 10"
- 70 VBEH TB 2"



CUSTOMER: CNRL FACILITY: Grand Forks Gas Plant LSD: 04-01-013-13-w4m
 P & ID: _____ DRAWN BY: B. Verge DATE: Mar 18/13 DRAWING NO. _____

VESSEL INFORMATION:
 Equip. No. _____ Pro. Reg. No. (A) C38332 C.R.N. _____ Serial No. 80243 Yr. Inst. _____
 Code/Div. _____ Size: 5' ID / 10' ID X _____ Manufacturer: TORNADO Technologies inc Yr. Blt. 2006
 C. Stamp: NO Service: out of service PWHT: _____ J.E.: _____ Radiography: _____ Insulated: NO

HEAD: Top Mat'l. _____ Top Nom: _____ Top C.A. _____ Material: _____ Nominal: _____ C.A. _____
 Btm Mat'l. _____ Btm Norm: _____ Btm C.A. _____

BOOT: Head Mat'l. _____ Head Nom. _____ Head C.A. _____ Top Mat'l. _____ Top Nom. _____ Top C.A. _____
 Shell Mat'l. _____ Shell Nom. _____ Shell C.A. _____ Btm Mat'l. _____ Btm Nom. _____ Btm C.A. _____
 MAWP Shell Side: _____ @ Temp. _____ MAWP Tube Side: _____ @ Temp. _____

PIPING INFORMATION:
 Circuit No. _____ Line No. (s) **(PLEASE PUT LINE NUMBERS ON APPLICABLE LINES ON THE DRAWING)**
 Piping Class: _____ Service: _____ Yr. Blt. _____
 MAWP: _____ @ Temp. _____ Size & Schedule of Piping **(PLEASE PUT APPROPRIATE SIZES AND SCHEDULES OF PIPING ON DRAWING)**