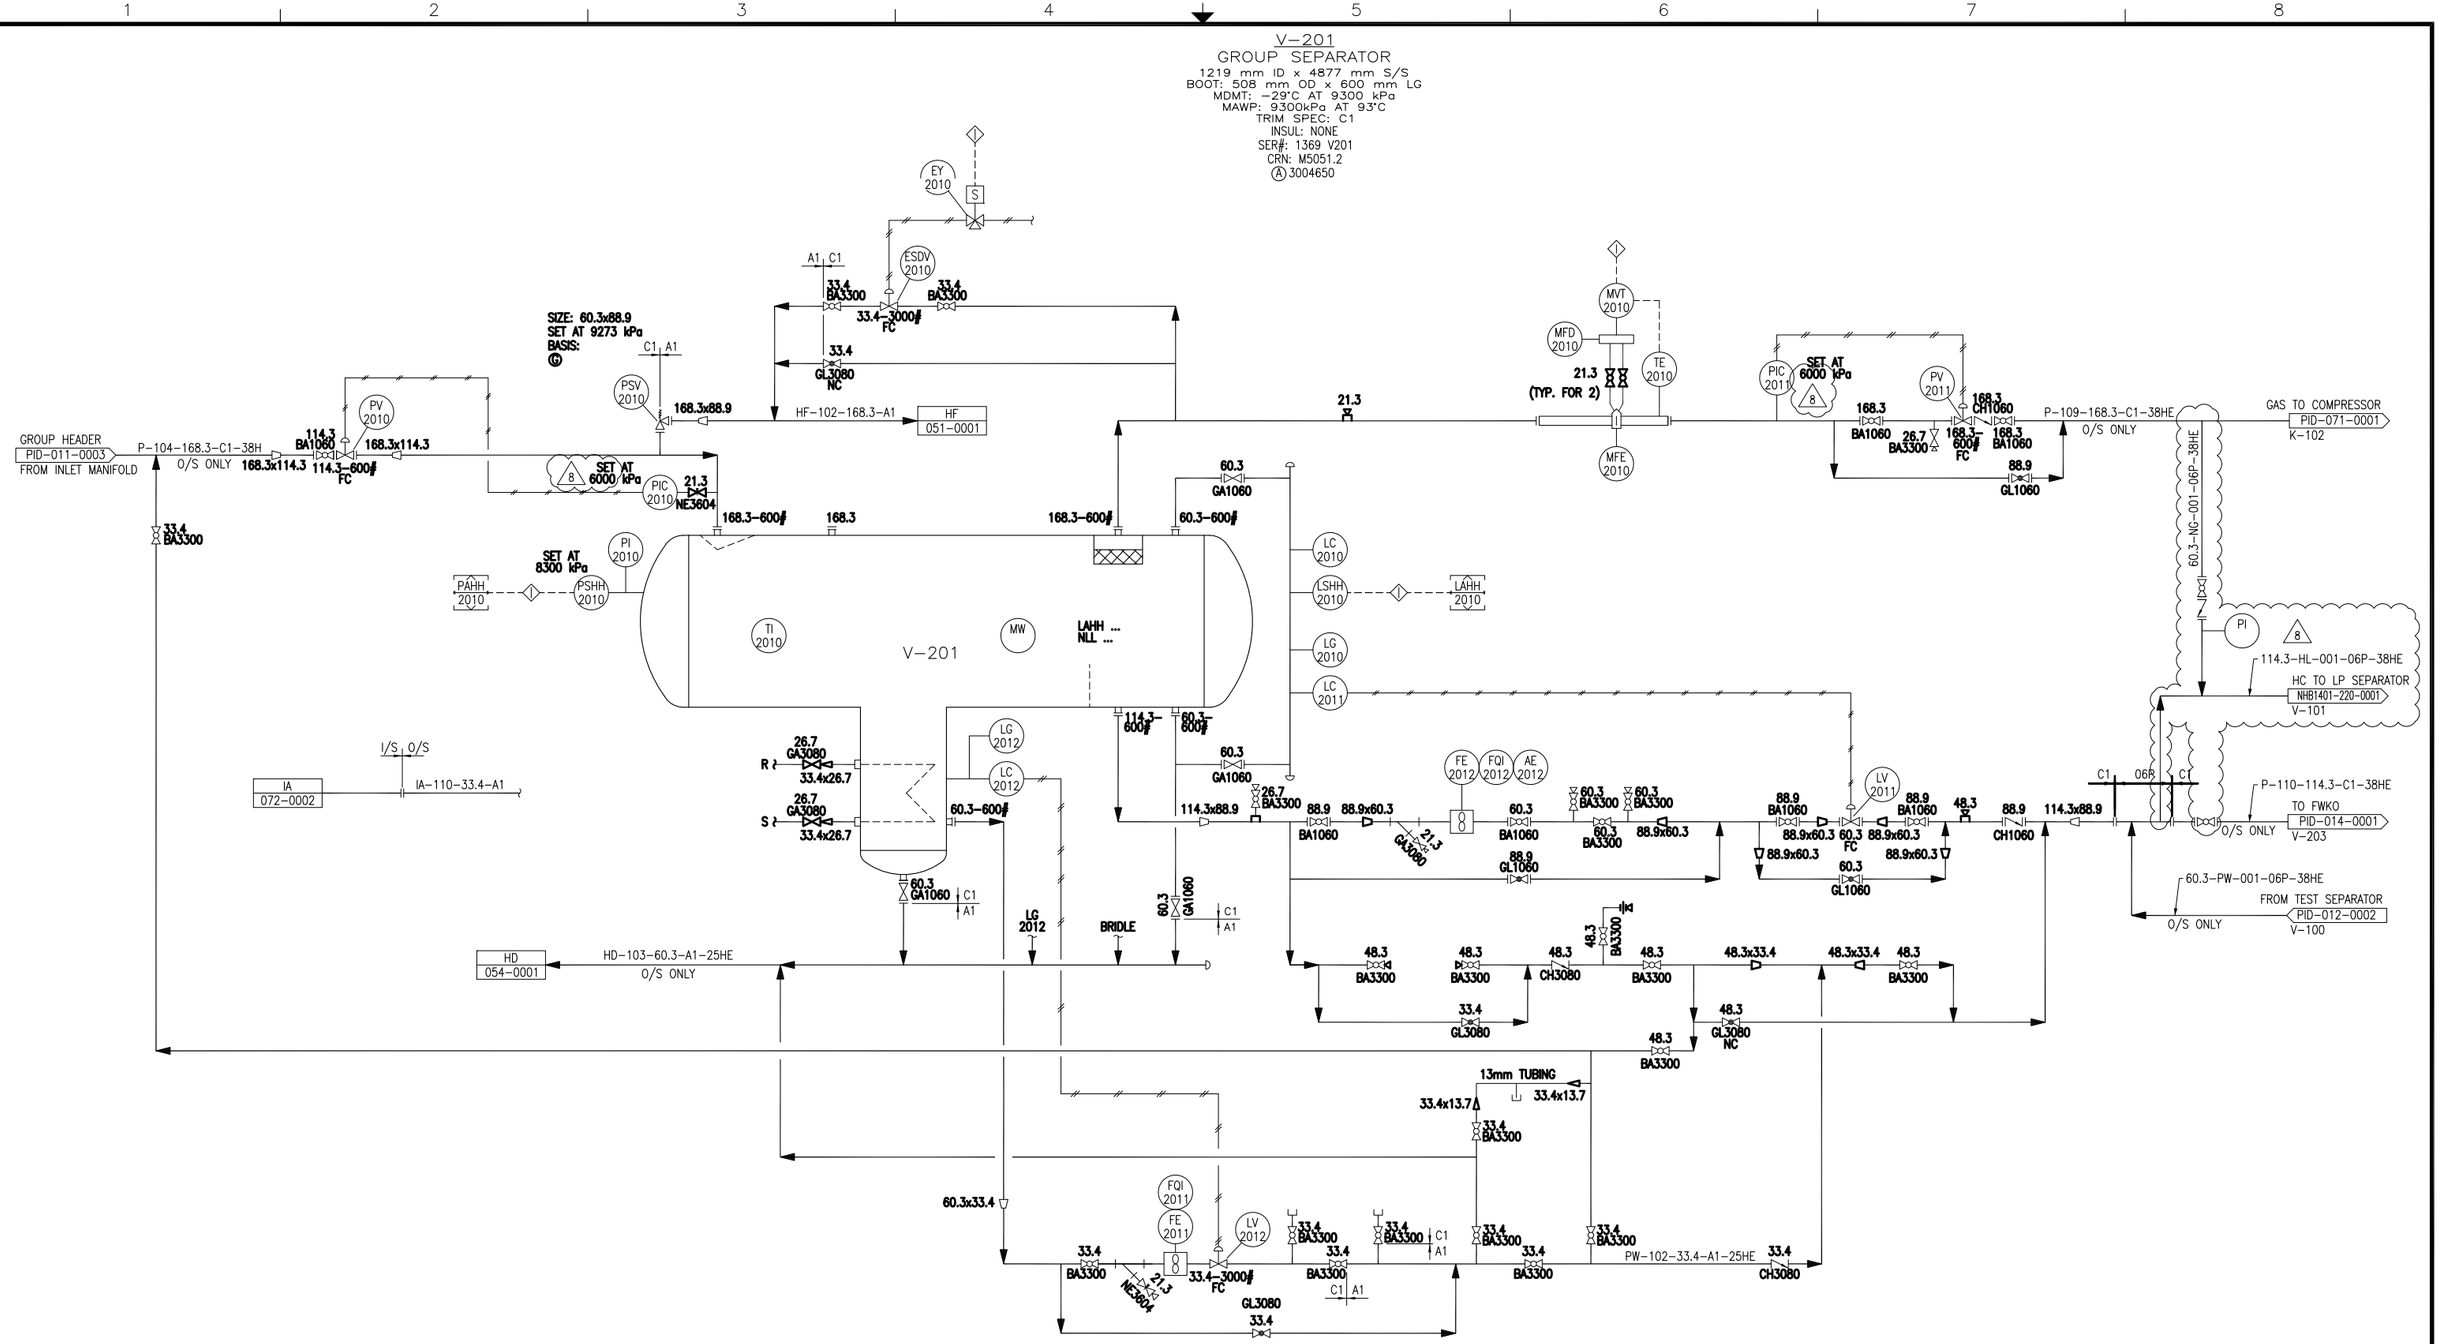

DRAWING NO.	REFERENCE DRAWINGS	DRAWINGS PREPARED BY: CNRL

REV.	DESCRIPTION	BY	DATE	CHK	APP.	CLIENT
8	ISSUED FOR CONSTRUCTION	KK	2011-12-20	JR		
7	AS-BUILT - DPH FOCUS JOB# 10117	PDC	2008-09-02			
6	AS-BUILT - DPH FOCUS JOB# 10117	GS	2008-04-29			
5	RE-ISSUED FOR CONSTRUCTION - DPH FOCUS JOB# 10117	GS	2008-03-20			
4	ISSUED FOR CONSTRUCTION - DPH FOCUS JOB# 10117	GS	2008-03-07			
3	ISSUED HAZOP - DPH FOCUS JOB# 10117	GS	2008-02-01			

DRAWN BY: TVB	DATE 1997-11-20		
DESIGNED BY: J. BELL	DATE	Canadian Natural	
CHECKED BY: D. LEITCH	DATE	TITLE NORTH HAMBURG (1265) 14-01-098-08W6 GROUP SEPARATOR PIPING & INSTRUMENTATION DIAGRAM	
APPROVED BY: J. BELL	DATE		
CLIENT BY:	DATE	SCALE NTS / JOB NO. - / DRAWING NO. PID-012-001	REV. 8