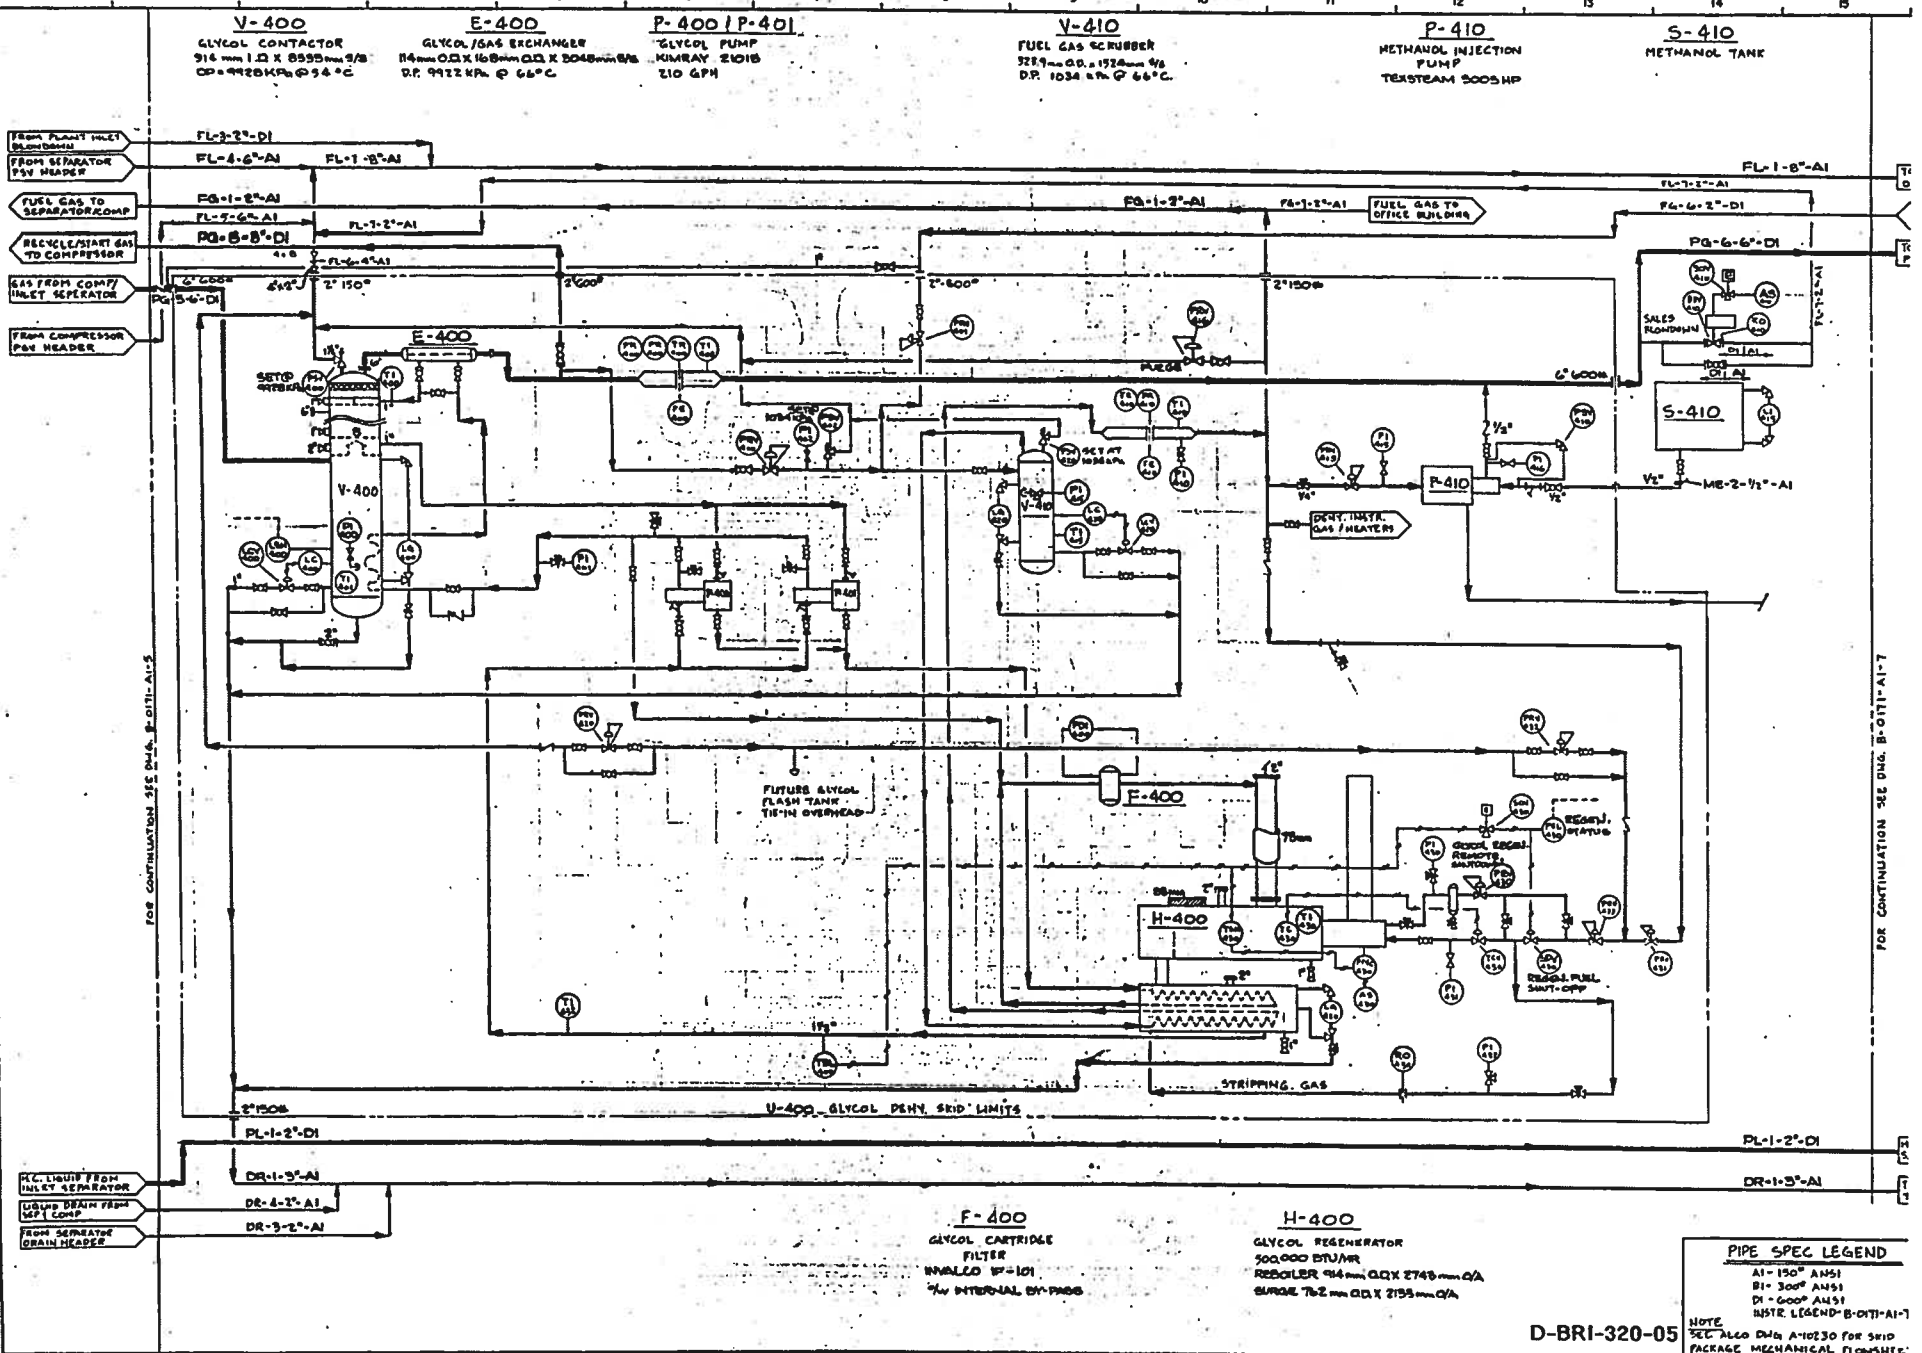

F-400
GLYCOL CARTRIDGE FILTER
INVALCO 18"-101
3/4" INTERNAL BY-PASS

H-400
GLYCOL REGENERATOR
500,000 BTU/HR
REBOILER 914 mm O.D. X 2743 mm O/A
SURGE 762 mm O.D. X 2135 mm O/A

D-BRI-320-05

PIPE SPEC LEGEND
A1 - 150# ANSI
B1 - 300# ANSI
D1 - 600# ANSI
INSTR. LEGEND B-0171-A1-7

NOTE
SEE ALSO DWG A-10230 FOR SKID PACKAGE MECHANICAL FLOWSHEET

NUMBER	REFERENCE DRAWING
A-10230	ALLO SKID PKG MECHANICAL FLOWSHEET
B-0171-A1-5	GAS COMPRESSION MECHANICAL FLOW DIAGRAM
B-0171-A1-7	FLARE, DRAIN & SALES MECHANICAL FLOW DIAGRAM

NO.	REVISION	DATE	BY	CH'D	APP'D
1	ISSUED FOR BID				
2	ISSUED FOR REPRICING				
3	GENERAL REVISION AS NOTED				
4	ISSUED FOR CONSTRUCTION				
5	LINE SIZE REVISED FL-1-2"-A1 WAS FL-1-4"-A1				
6	REVISED AS SHOWN				
7	AS-BUILT				

PERMIT TO PRACTICE
SAGE ENGINEERING LTD.
PERMIT NUMBER: P 4198
The Association of Professional Engineers, Geologists and Geophysicists of Alberta

SAGE ENGINEERING LTD.
CONSULTING ENGINEERS
CALGARY ALBERTA

SOQUIP ALBERTA
BRIGHTVIEW GAS COMPRESS
I-11-46-27 W4
GLYCOL DEHYDRATIO
MECHANICAL FLOW
PROJECT No. 017-001
DRAWING No. B-0171-A