


Mat'l	Description	Direction	Mat'l
05	V04IE	R-T	4"
10	VT5H	B-T	N/A
15	VMS5	T-B	1"
20	VULL	T-B	3"
25	VLLI	T-B	E08
30	VRSWH	T-B	E08
35	V040E	T-B	S05

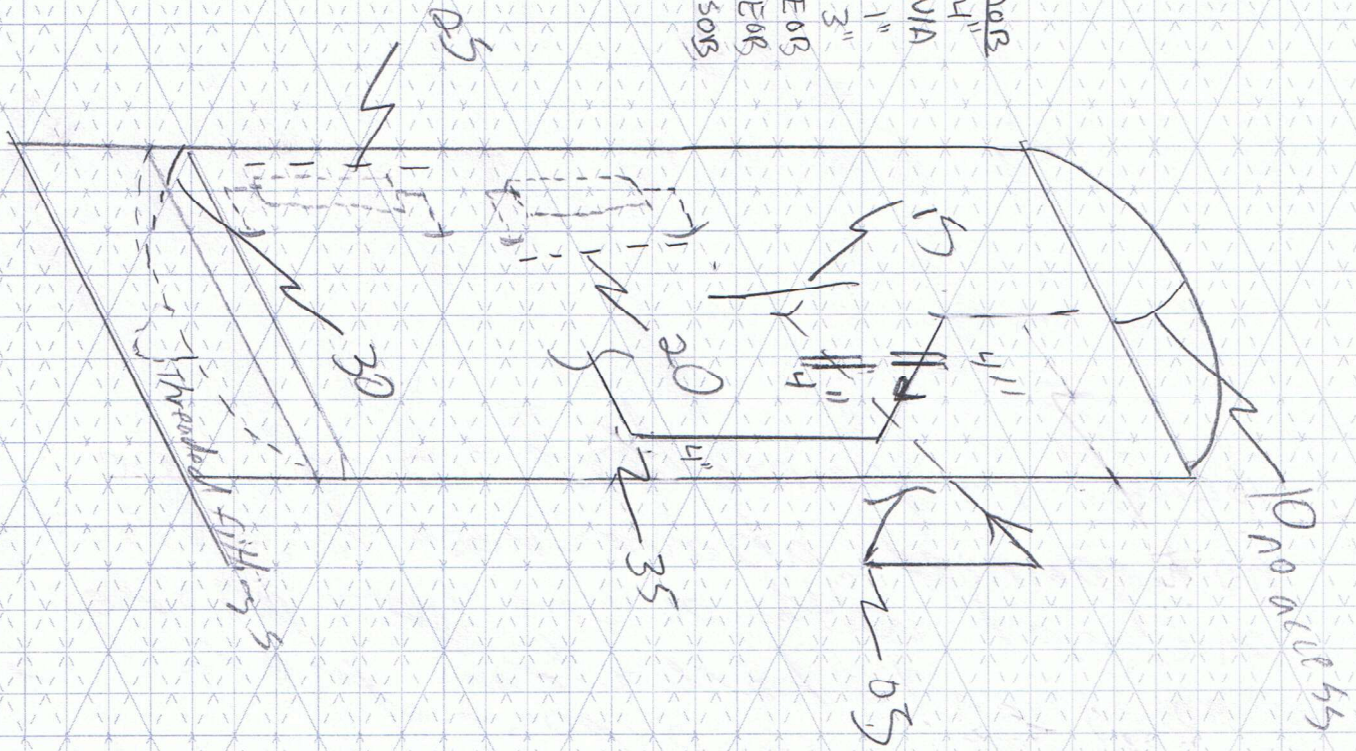

3 PHASE SEPARATOR

CUSTOMER: LNRL FACILITY: FENDIANG LSD: 06-28-034-15W4
 P & ID: _____ DRAWN BY: P. MAZE DATE: 02-03-10 DRAWING NO. 16

VESSEL INFORMATION:
 Equip. No. _____ Pro.Reg.No (A) 0209547 C.R.N. E8481.2 Serial No 716.83 Yr. Inst. _____
 Code/Div. _____ Size: 20" ID / 15' OD X _____ Manufacturer: SURE WELD IND. Yr. Blt. 1983
 C. Stamp VW Service: Sweet PWHT: NO J.E.: _____ Radiography: RT-2 Insulated: NO

HEAD: **SHELL:**
 Top Mat'l _____ Top Nom _____ Top C.A. 0.0625" Material _____ Nominal _____ C.A. 0.0625"
 Btm Mat'l _____ Btm Nom. _____ Btm C.A. _____

BOOT: **CHANNEL:**
 Head Mat'l _____ Head Nom _____ Head C.A. _____ Top Mat'l _____ Top Nom. _____ Top C.A. _____

A0209457 UT Readings

Readings in Inches

	PNT 1	PNT 2	PNT 3
LOC 5	0.230	0.241	0.224
LOC 10	Obstr	Obstr	Obstr
LOC 15	0.767	0.769	0.766
LOC 20	0.771	0.772	0.770
LOC 25	0.769	0.768	0.768
LOC 30	0.816	0.730	0.730
LOC 35	0.231	0.235	0.231