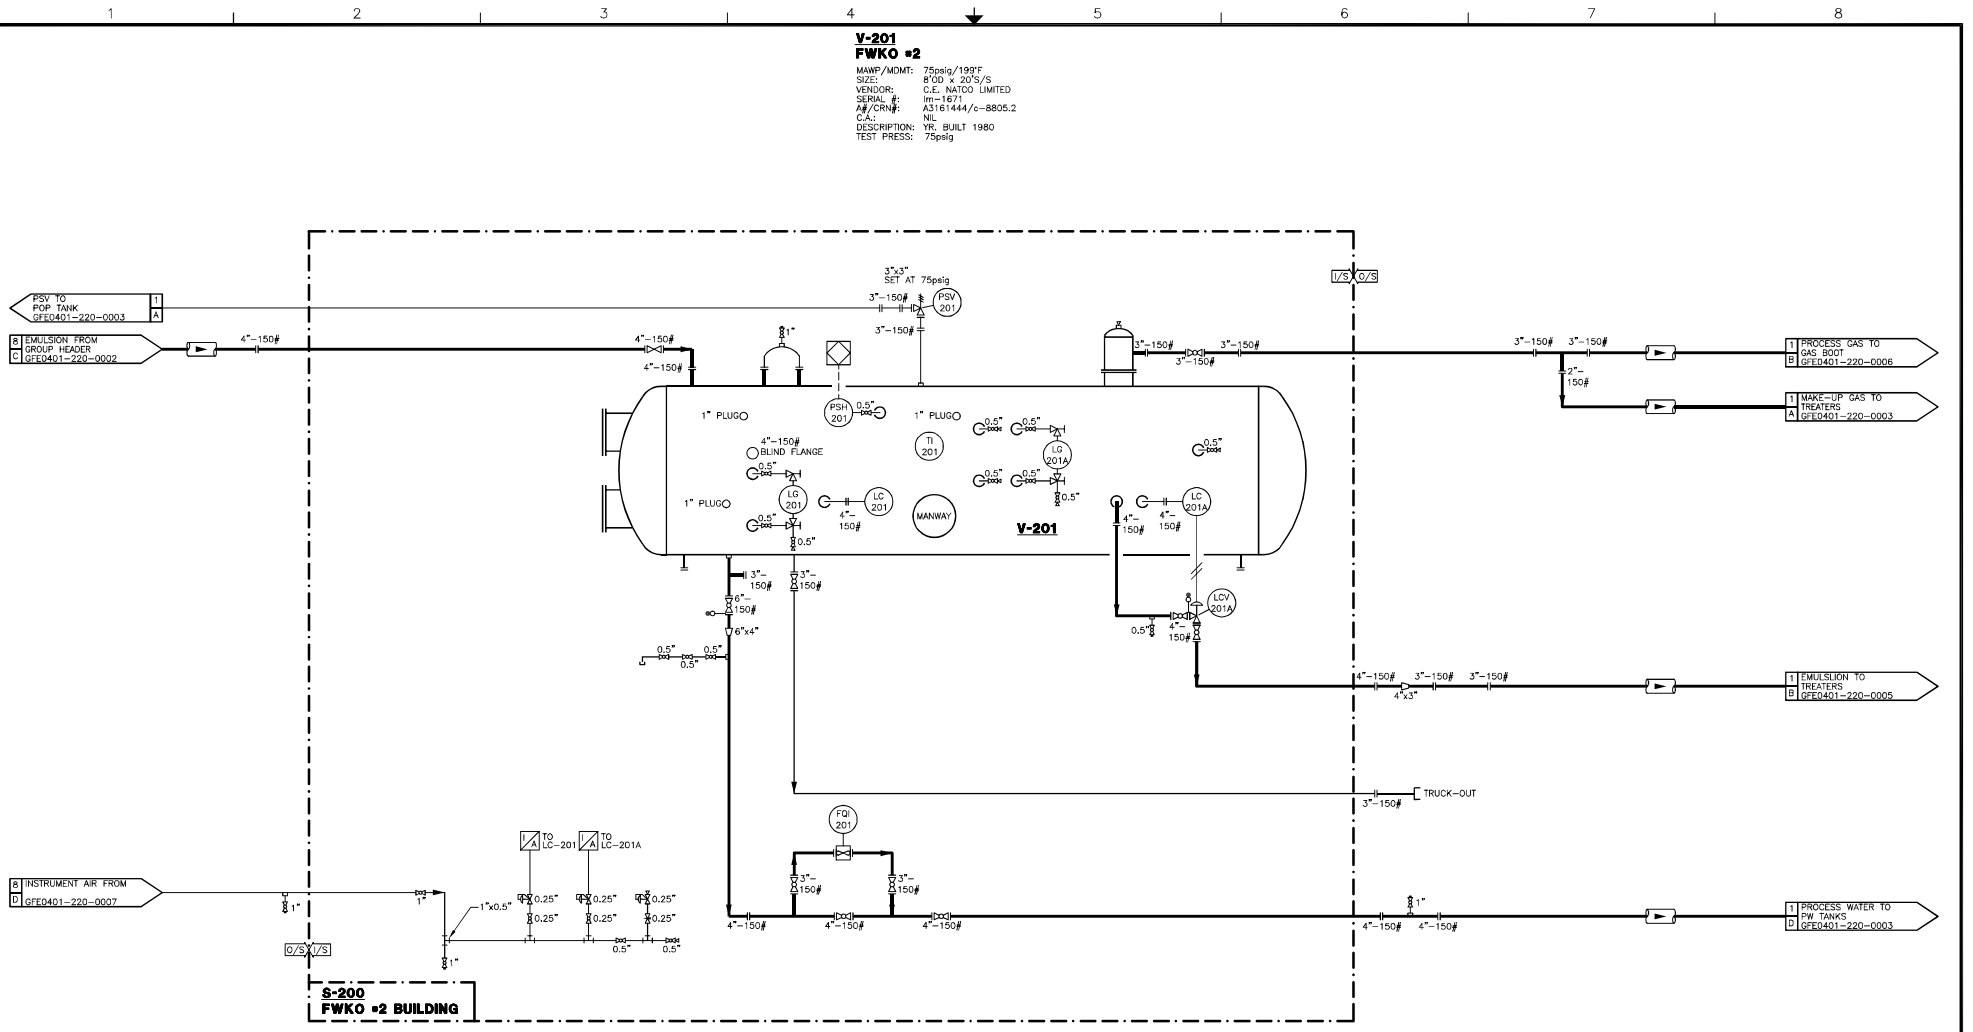

											DRAWN BY: S.ZIADEH	DATE 2012-06-10
											DESIGNED BY:	DATE
											CHECKED BY: LD	DATE
			1	AS BUILT	MG	2012-08-31	LD	GA	NO		APPROVED BY: GA	DATE
			0	AS BUILT	SZ	2012-07-27	LD	GA	NO		CLIENT BY: NO	DATE
DRAWING NO.	REFERENCE DRAWINGS	LANMARK ENGINEERING 3362	REV.	DESCRIPTION	BY	DATE	CHK	APP.	CLIENT			

Canadian Natural

LANMARK ENGINEERING

TITLE: GRAND FORKS EAST, AB
04-01-013-13 W4M
FWKO #2
P&ID

SCALE	JOB NO.	DRAWING NO.	REV.
NTS	3362	GFE0401-220-0008	1