FWKO-300
FREE WATER KNOCK OUT
2438mm x 7620mm S/S
517 kPag I.C.
1300 mmBtu/hr

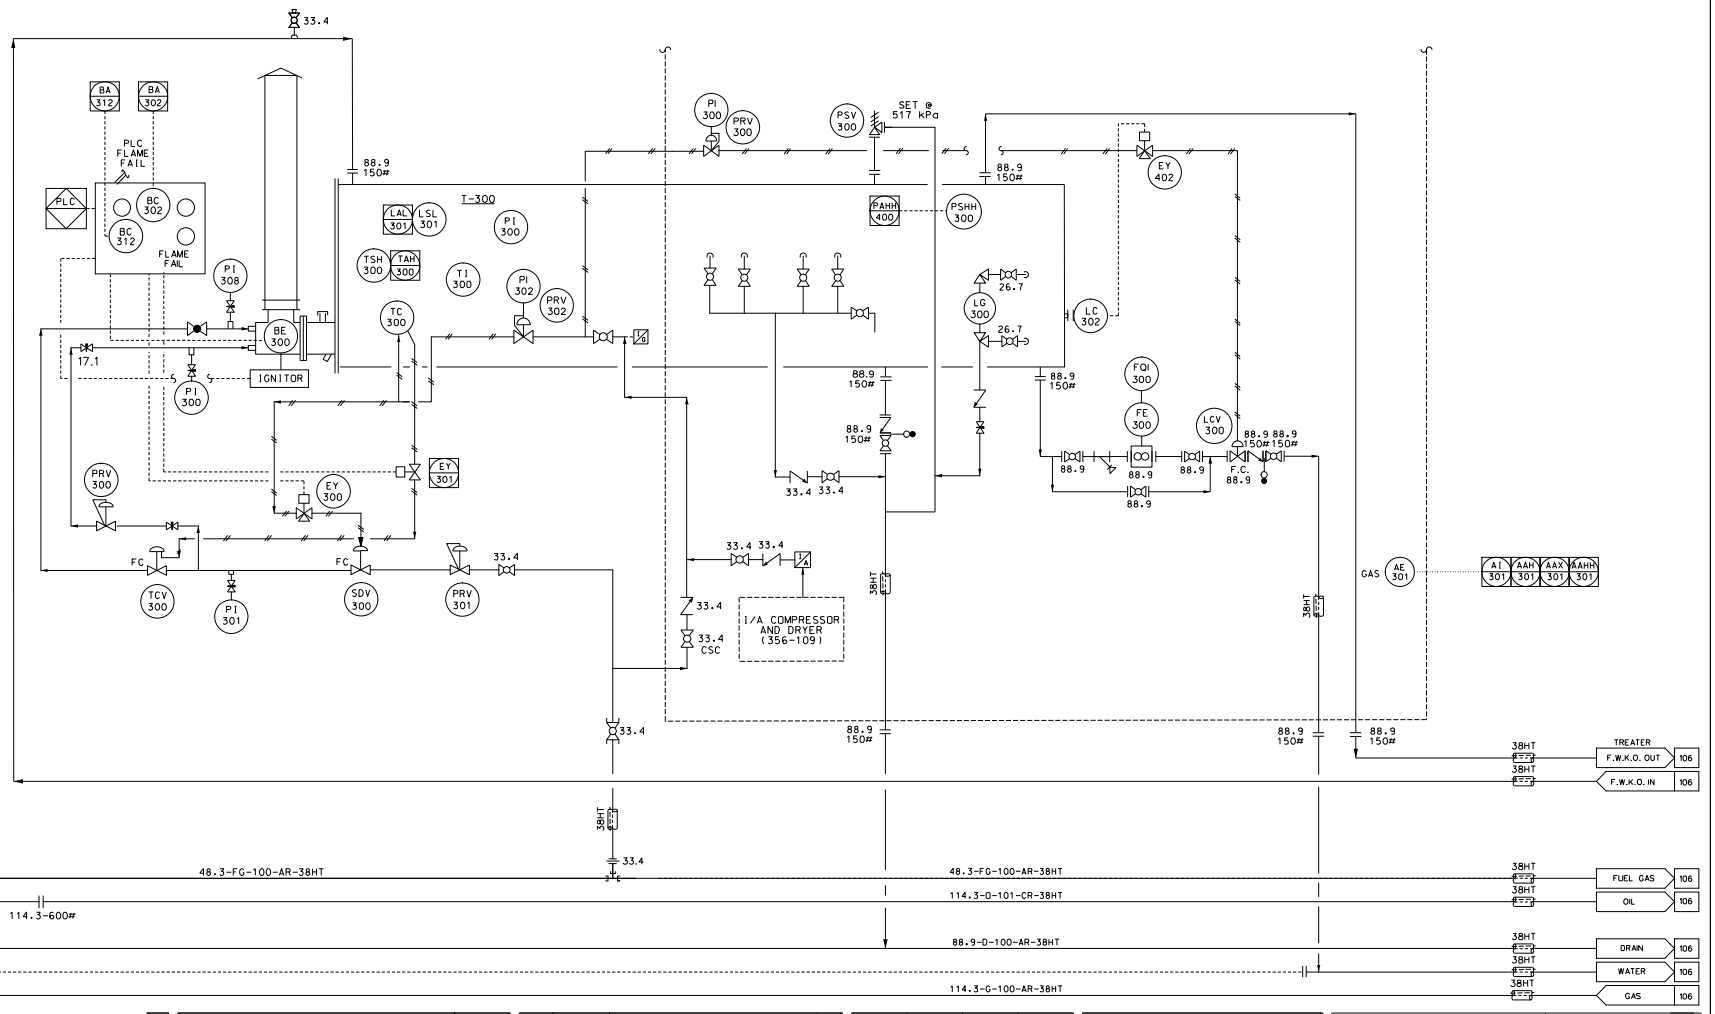

NOTES

PLOT PLAN	356-201
REFERENCE DRAWINGS	DWG No

REV	DATE	REVISION DESCRIPTION	BY
3	00/03/07	ADDED F.W.K.O.	MTM
2	99/06/08	REVISED AS BUILT	MTM
1	99/03/29	REVISED LINE SIZE	MDK
0	99/03/12	ISSUED FOR CONSTRUCTION	RWL

ENGINEER	JHL		
APPROVAL	JHL		
CHECKER			
DRAWN	RWL		
DATE	99/01/27		
SCALE:	NONE	APPROVED	DATE

LICENCE AND PERMIT

ELLERSLIE BATTERY
5-11-45-25 W4M
F.W.K.O. BUILDING
PROCESS & INSTRUMENTATION DIAGRAM
356-105

VELVE EXPLORATION LTD.
ACCUTECH LIMITED
PRODUCTION ENGINEERING SERVICES
CALGARY ALBERTA

DRAWING NUMBER	REV
NEL0511-220-0005	3

SOURCE TECHNOLOGY