

Client: CNRL PO/Job #: N/A Contact: _____
Job location: Grand Forks Tel: _____
07-32-012-13W4M Fax: _____
Procedure(s): IRISNDT 19.0 UT Thickness Corrosion Survey / Client specifications
Code(s): ASTM SE 797

Item Inspected: A2698238 Free Water Knock-Out Material: Carbon Steel
Method: Contact Immersion Other: _____ Surface Temp (C): < 5° > 5° < 60° > 60°
Type: P/E T/T Dual Automated TOFD Scanning Surface: OD ID Other: _____
Application: Laminar Shear Wave Volumetric Thickness Surface Condition: Good

Instrumentation: Manufacturer: Krautkramer Type: DMS 2 Instrument Ser. #: 01N0V4
Calibration: Date: Nov. 21, 2008 Reference Flaw Size: N/A IRISNDT #: 31088
Calibration Block(s): Type: Step Wedge - I IRISNDT #: 32983 Type: _____ IRISNDT #: _____
Type: _____ IRISNDT #: _____ Type: _____ IRISNDT #: _____
Couplant: Brand: Sonotest Type: 1451 Cable: Type: Dual Length: 36"

PROBE						SETTINGS - dB			RANGE - <input checked="" type="checkbox"/> INCHES <input type="checkbox"/> MM		
Manufacturer	Type	Serial #	Angle	Frequency	Size	Reference Level	Scanning Level	Transfer Value	Screen Size	Skip Value	Beam Travel
<u>Krautkramer</u>	<u>Dual</u>	<u>01MRC3</u>	<u>0</u>	<u>8.0 MHz</u>	<u>0.312</u>	<u>48</u>	<u>+6 dB</u>	<u>N/A</u>	<u>1.0</u>	<u>N/A</u>	<u>N/A</u>

INSPECTION DETAILS

Scope:

As per client request and specifications: an ultrasonic corrosion thickness survey was performed on A2698238 Free Water Knock-Out.

Isometric sketches were created, and are attached to this report for reference to thickness measurement locations.


Results:

All thickness values recorded were found to be acceptable at the time of the inspection.

See attached pages for complete thickness values with referencing attachments for thickness measurement location.

Assistant: _____ <input type="checkbox"/> CGSB <input type="checkbox"/> SNT UT Level: <input type="checkbox"/> I <input type="checkbox"/> II <input type="checkbox"/> III No. #: _____	Technician: <u>Kris Katryniuk</u> <input checked="" type="checkbox"/> CGSB <input type="checkbox"/> SNT UT Level: <input type="checkbox"/> I <input checked="" type="checkbox"/> II <input type="checkbox"/> III No. #: <u>12095</u> Signature: _____ <small>Digitally signed by Kris Katryniuk DN: CN = Kris Katryniuk, C = CA, O = IRISNDT Date: 2009.11.13 16:56:25 -0700</small>
Unit: _____ Km: _____ Travel Time: _____ Start: _____ Stop: _____ Work hrs: _____ <input type="checkbox"/> OT Meal <input type="checkbox"/> Subsistence required Total hrs: _____ Consumables: <u>Cold surface couplant - isometric paper</u>	Client Name: _____ Signature: _____

Edmonton (780) 437-4747	Fort McMurray (780) 743-1536	Cold Lake (780) 594-1114	Mailing Address
Calgary (403) 279-6121	Grande Prairie (780) 532-2283	Red Deer (403) 347-1742	5311 - 86 Street
Nisku (780) 955-7616	High Level (780) 841-0470	Tulsa, OK (918) 446-8773	Edmonton, Alberta
Barrhead (780) 674-3018	Lloydminster (780) 875-6455	Houston, TX (281) 476-4444	T6E 5T8

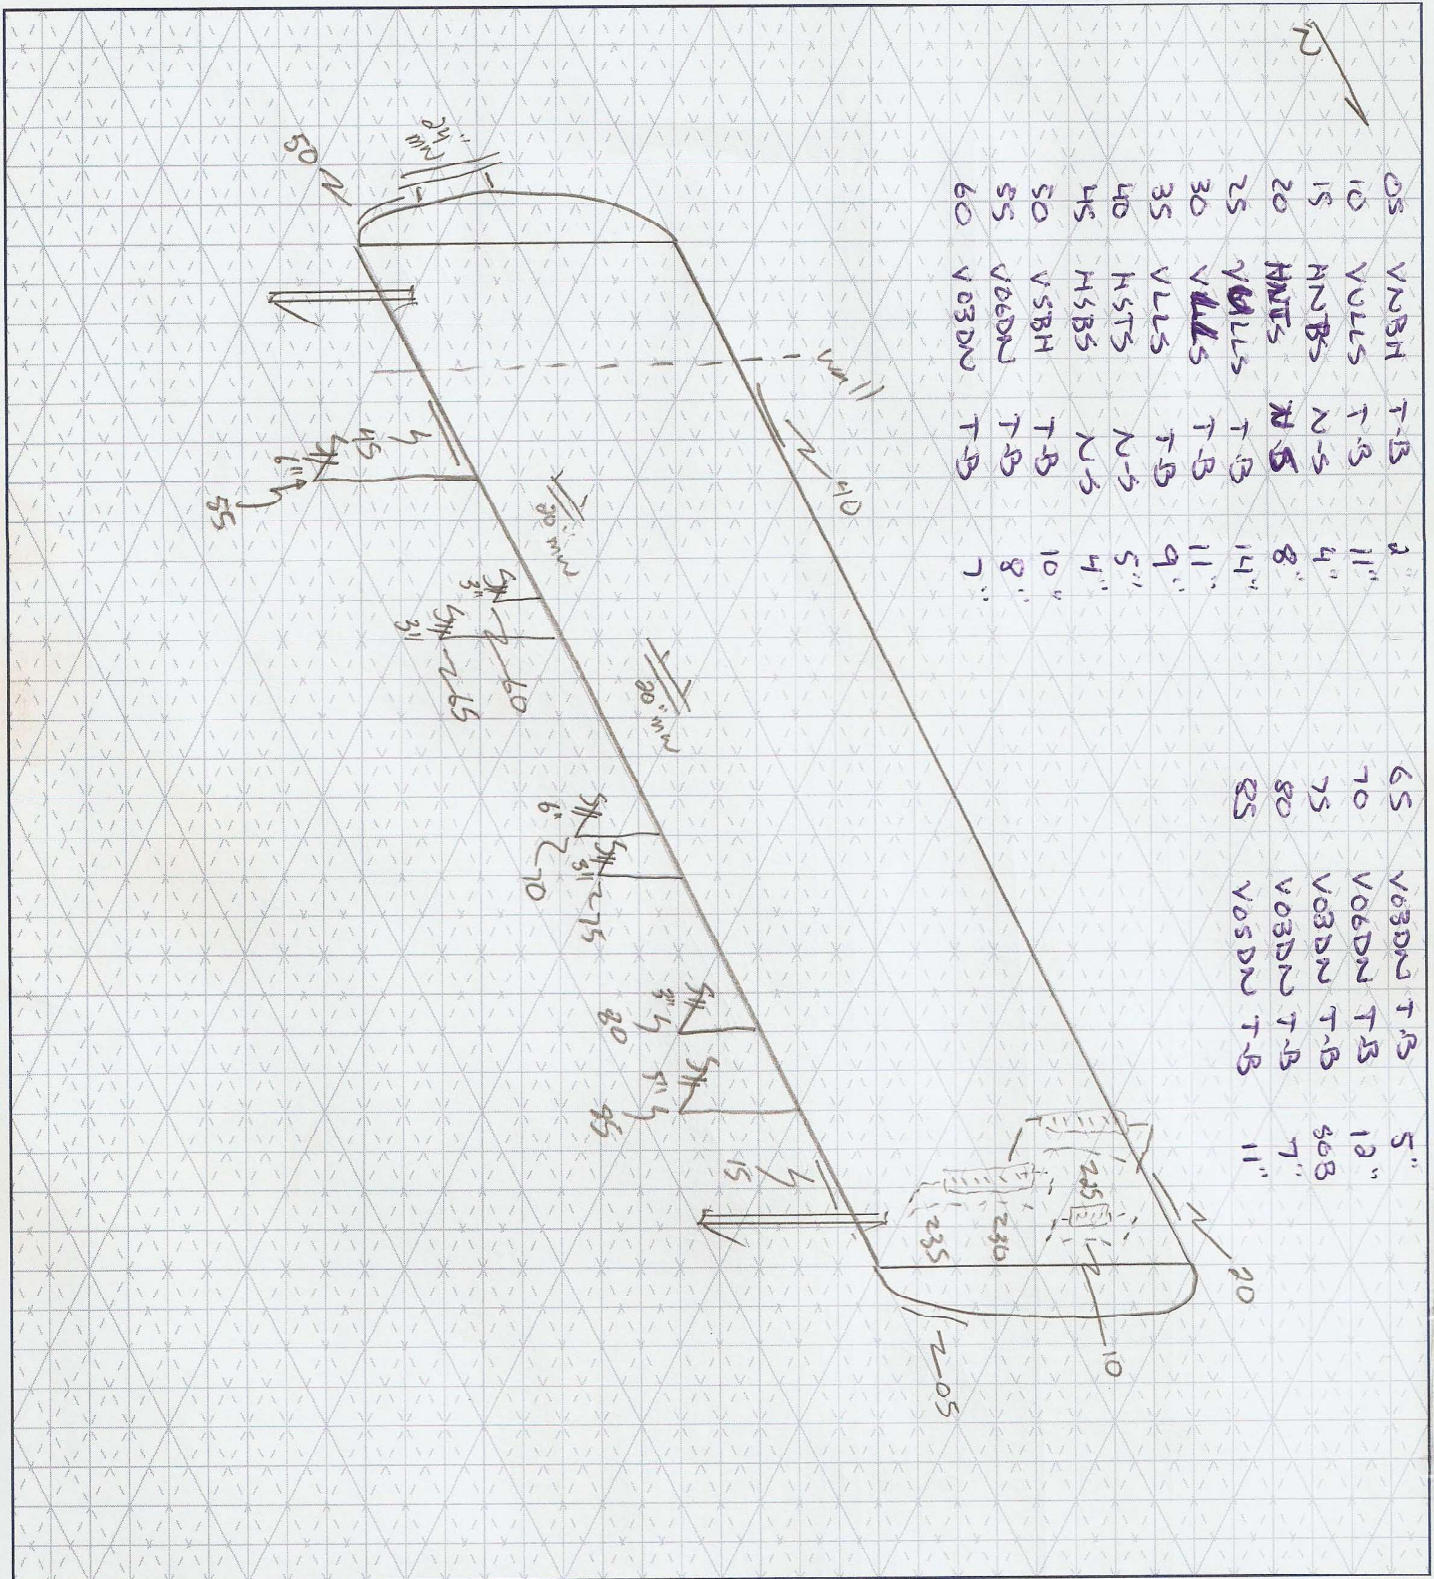

CUSTOMER: CNCL FACILITY: GRAND FORKS BATTERY LSD: 07-32-012-13W4M

P & ID: - DRAWN BY: KK DATE: 06-09-09 DRAWING NO. 137868-KK-12

VESSEL INFORMATION: FREE WATER KNOCKOUT

Equip. No. _____ Pro.Reg.No (A) A2698238 C.R.N. K3252.2 Serial No. P90-003-A Yr. Inst. _____

Code/Div. VN11A 111A5B Size: 120" ID/OD 36" Manufacturer: Process Industries Yr. Bld. 1991

C. Stamp _____ Service: _____ PWHT: NIL J.E.: _____ Radiography: 12T-2 Full/SPOT Insulated: Partial

HEAD: _____ SHELL: _____

Top Mat'l 516-70 Top Nom .607" Top C.A. .062" Material 516-70 Nominal .375" C.A. .062"

Btm Mat'l 516-70 Btm Nom. .607" Btm C.A. .062"

BOOT: _____ CHANNEL: _____