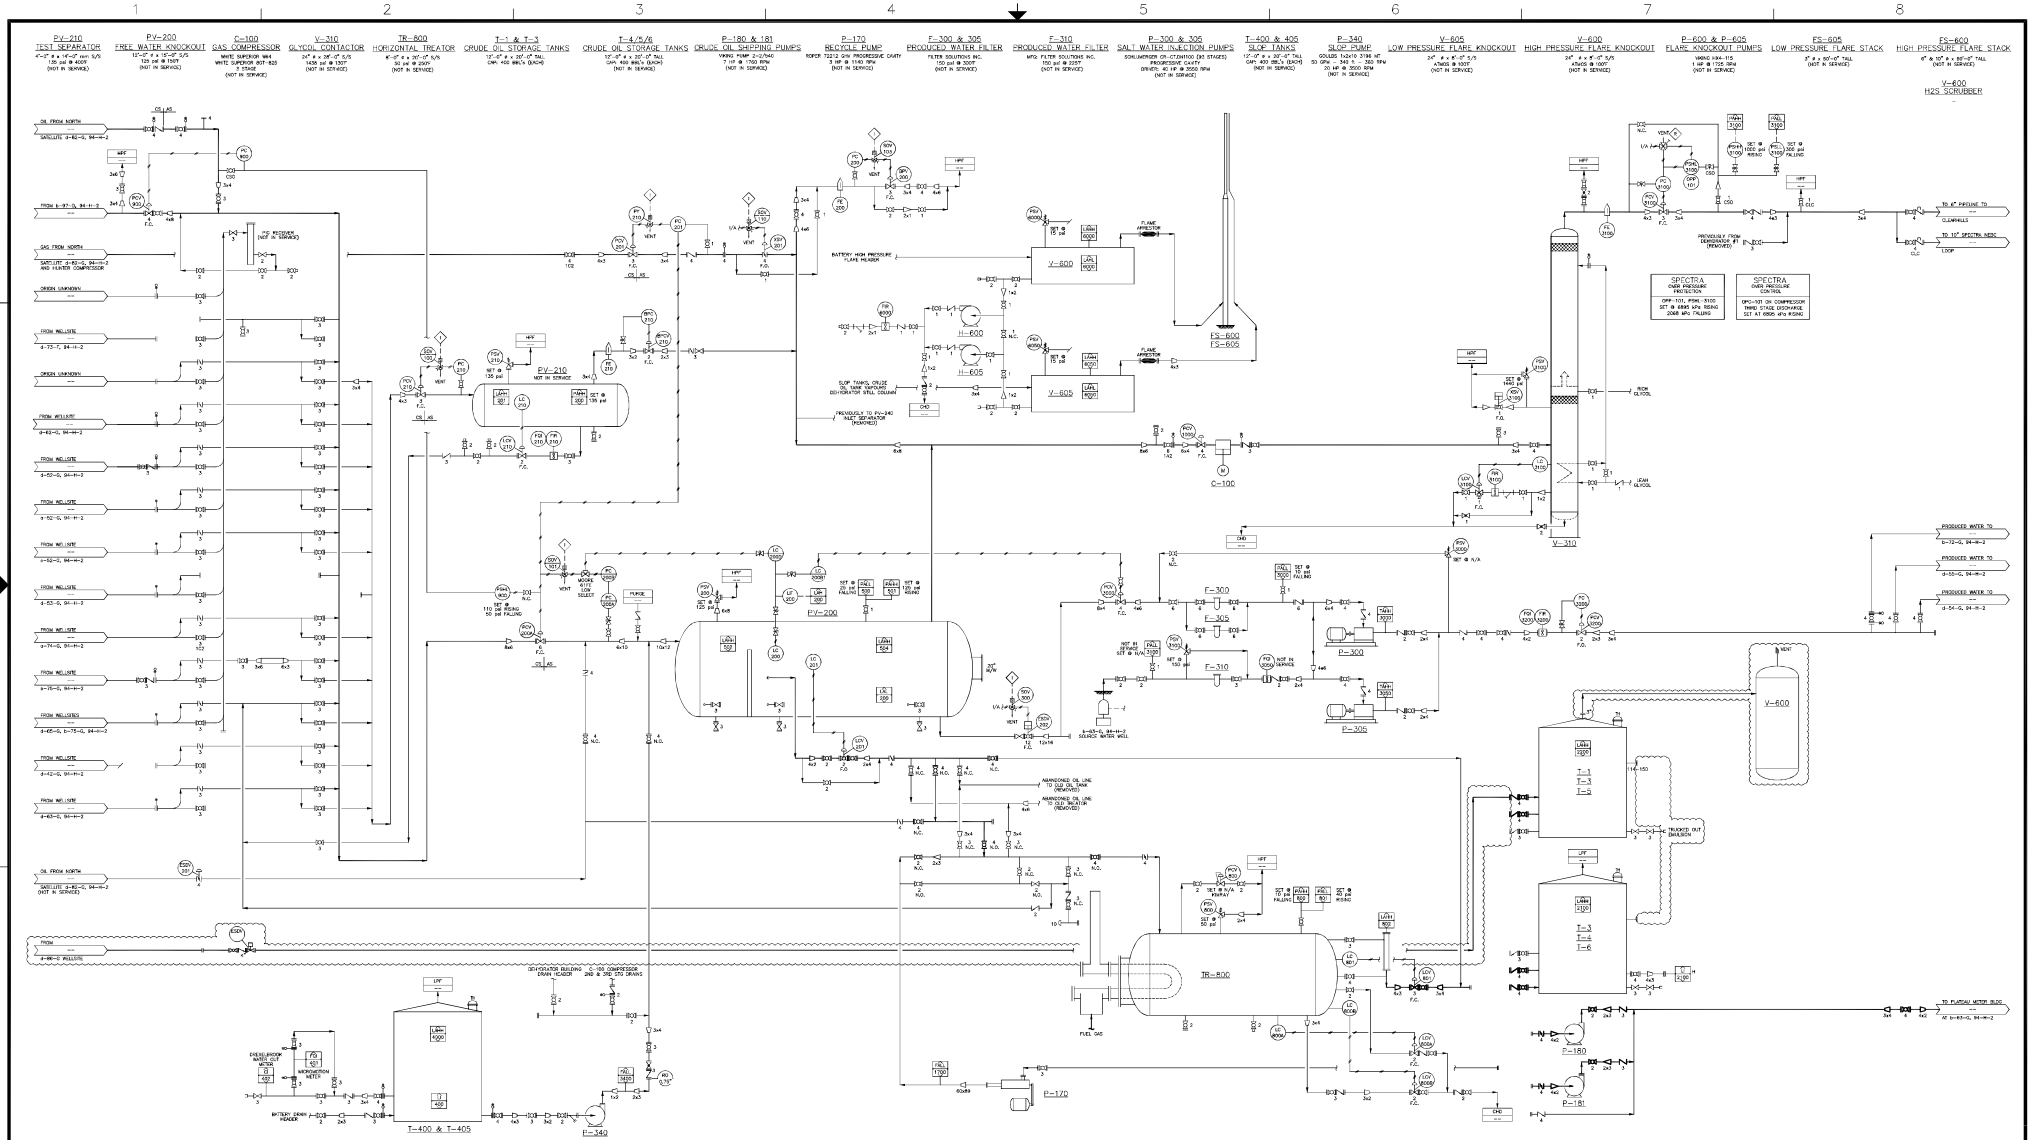

									DRAWN BY: –	DATE –
									DESIGNED BY:	DATE
									CHECKED BY:	DATE
									APPROVED BY:	DATE
			B	OGC APPLICATION	CB	2016-01-18	AD		CLIENT BY:	DATE
			A	AS-IS AS PER FIELD VIST	–	2009-01-27				
DRAWING NO.	REFERENCE DRAWINGS	DRAWING PREPARED BY: CANADIAN NATURAL	REV.	DESCRIPTION	BY	DATE	CHK	APP.	CLIENT	

Canadian Natural

TITLE: MILLIGAN SLAVE POINT (3156)
b-63-G 94-H-2

PROCESS FLOW DIAGRAM

SCALE	JOB NO.	DRAWING NO.	REV.
N.T.S.	–	MILb63G-221-0001	B