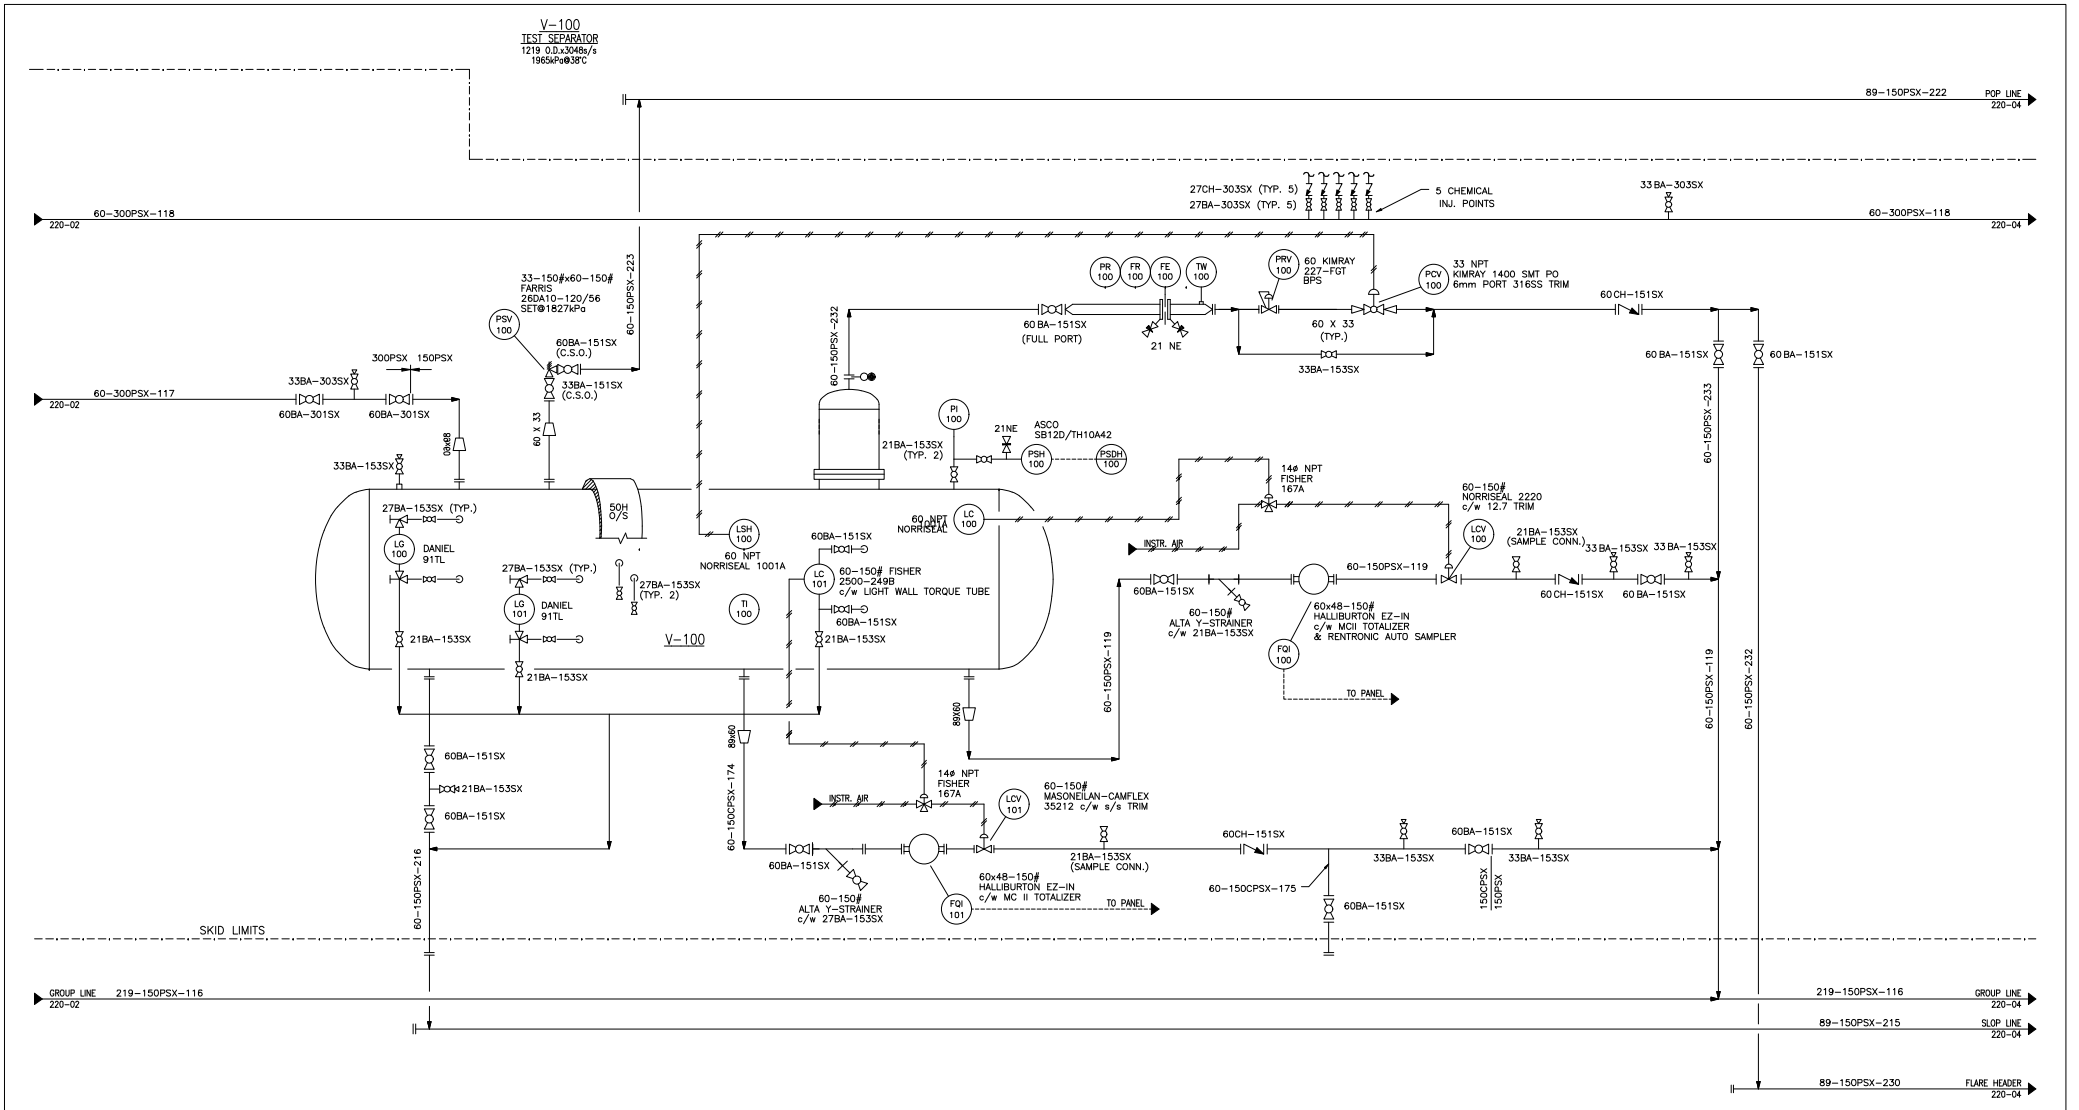

Rev.	Date	Description	By	App'd.
0	04-03-22	AS-BUILT	AZ	

Designed: | Drawn: HARDCASTLE | Checked: | Approved:
Scale: NTS | Date: 04-03-22 | Date: | Job No.:

Canadian Natural

Dwg. Title:
HORSE FLY LAKE OIL BATTERY
LSD 03-19-08-16 W4M
TEST SEPARATOR V-100
PROCESS AND INSTRUMENTATION DIAGRAM

Reference:	Drawing No.:	Revision:
04-048	HOR0319-220-0004	0