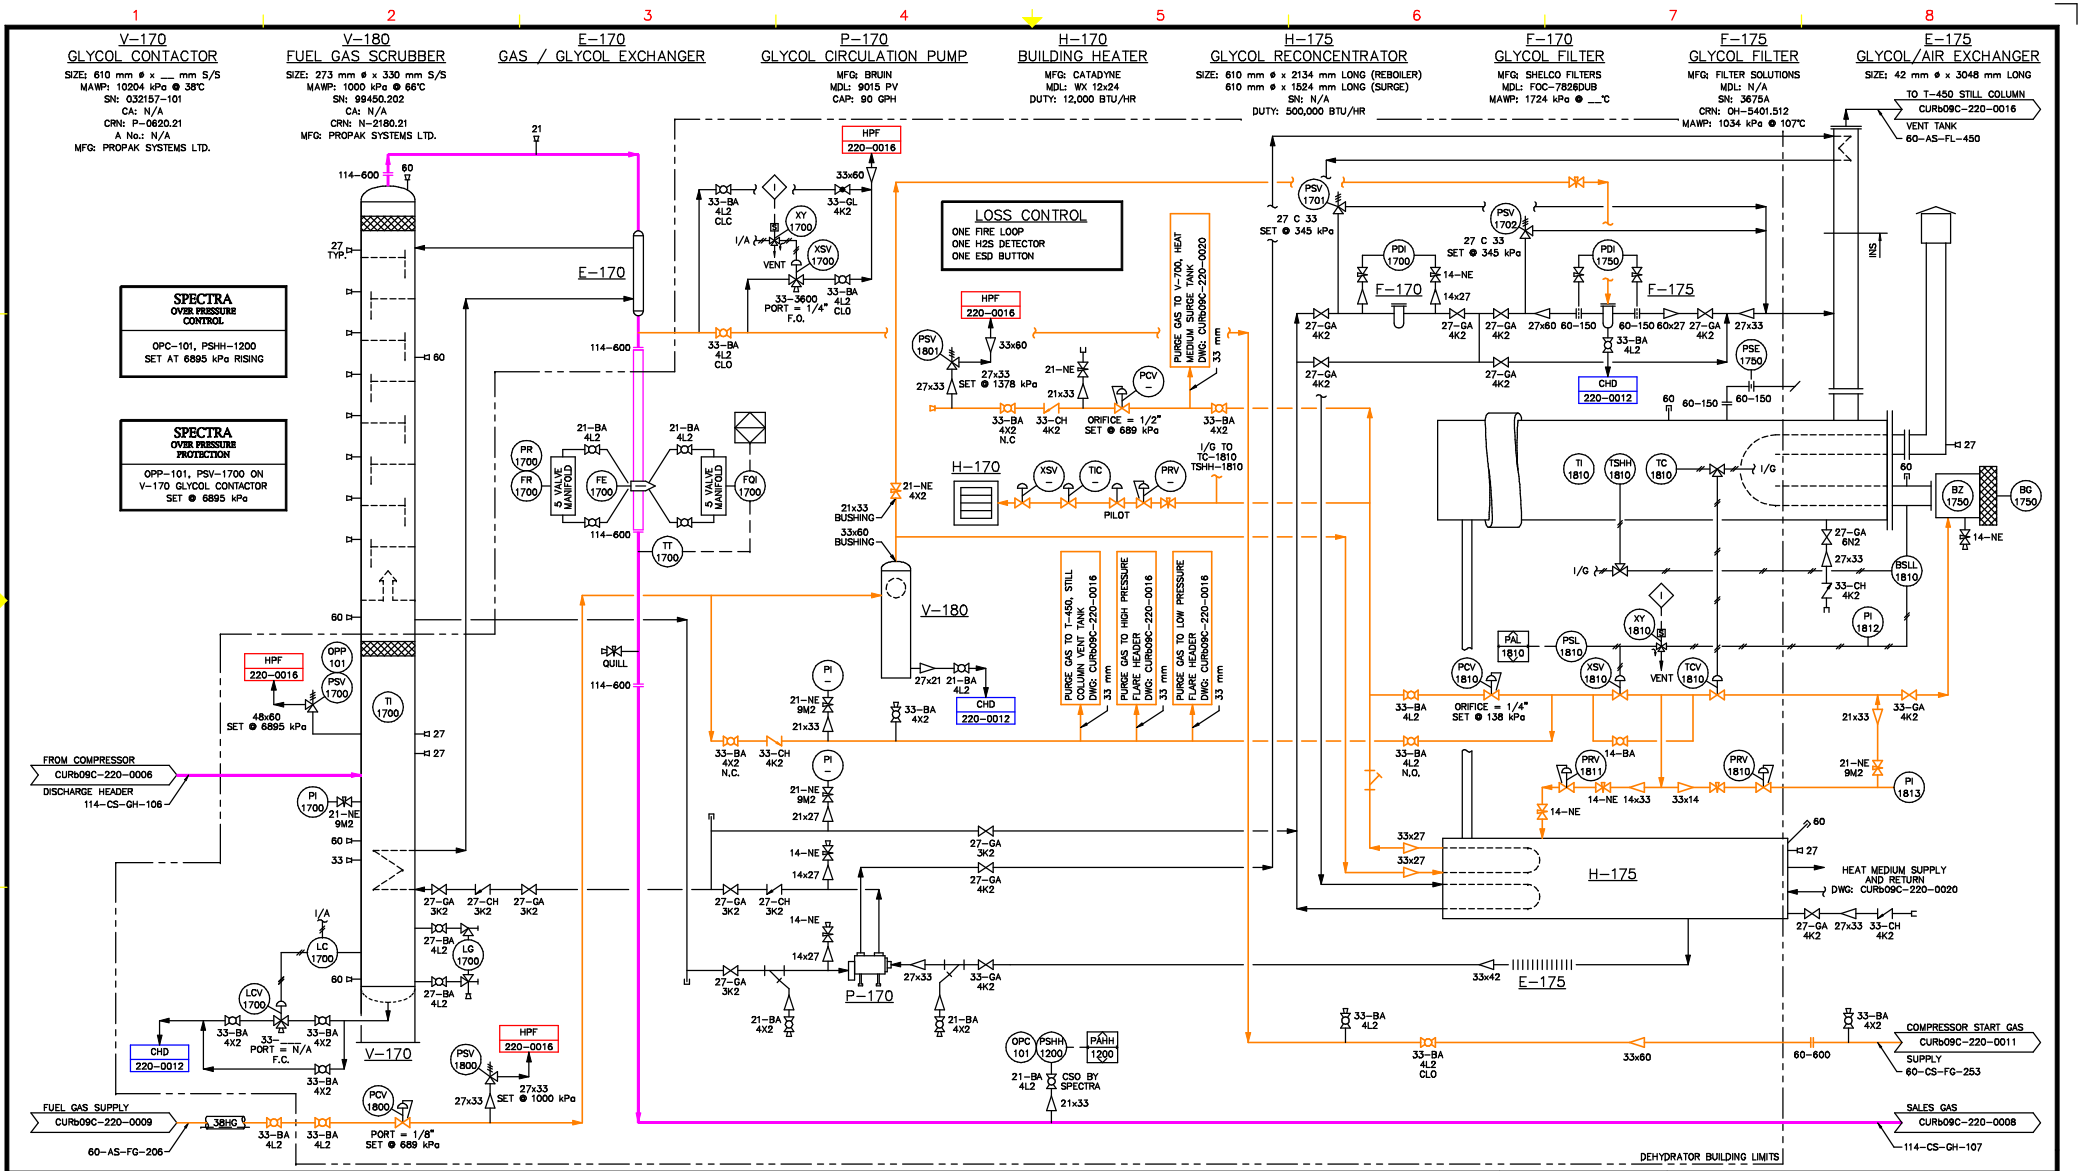

DRAWING NO.	REFERENCE DRAWINGS

NDSL

REV.	DESCRIPTION	BY	DATE	CHK	APP.	CLIENT
2	ASSET TRANSFER. AS-IS AS PER FIELD VISIT	WRM	2011-06-01	WRM		
1	AS-IS	WRM	2008-02-22	WRM		

DRAWN BY: WRM	DATE 2008-02-22	
DESIGNED BY:	DATE	
CHECKED BY:	DATE	
APPROVED BY:	DATE	
CLIENT BY:	DATE	

Canadian Natural

TITLE
CURRANT COMPRESSOR STATION
b-09-C, 94-A-16
DEHYDRATION
PROCESS AND INSTRUMENTATION DIAGRAM

SCALE	JOB NO.	DRAWING NO.	REV.
N.T.S.	–	CURb09C-220-0007	2