FE-1010	V-4000	E-4050	P-4040/4050	F-4060/4070	F-5000	V -4010	V-4020	E-4080	H-4030	H-4090
FUEL GAS METER	GLYCOL CONTACTOR	GAS/GLYCOL EXCHANGER	GLYCOL PUMP	CHARCOAL FILTER	GLYCOL FILTER	GLYCOL FLASH TANK	FUEL GAS SCRUBBER	AIR/GLYCOL EXCHANGER	GLYCOL REGENERATOR	BUILDING HEATER
60.3mm O.D xSch. 40 MAKE/MODEL TBA SPECIFICATIONS: TBA	610mm O.D. x 8534mm S/S MAWP: 9930 kPag @ 38°C CRN: H5934.21 S/N 4PE 4234	114mmx168mm O.D.x2000mm LONG MAWP: 9930kPag @ 38°C	MAKE: KIMRAY MODEL: 9015	MAKE: CUNO MODEL : 182	MAKE: PEACOCK 3000L-2	312mm O.D. x 1524mm S/S MAWP: 1562kPag @ 38°C CRN: K1190.12	219mm O.D. x 914mm S/S MAWP: 1034kPag CRN: L9476.213	31.75mm TRANE FIN TUBE	609.6mm O.D.x2362.2mm S/S 350,000 Btu/hr	MAKE/MODEL:CATADYNE STARTER: 12VDC RATED DUTY: 16,000

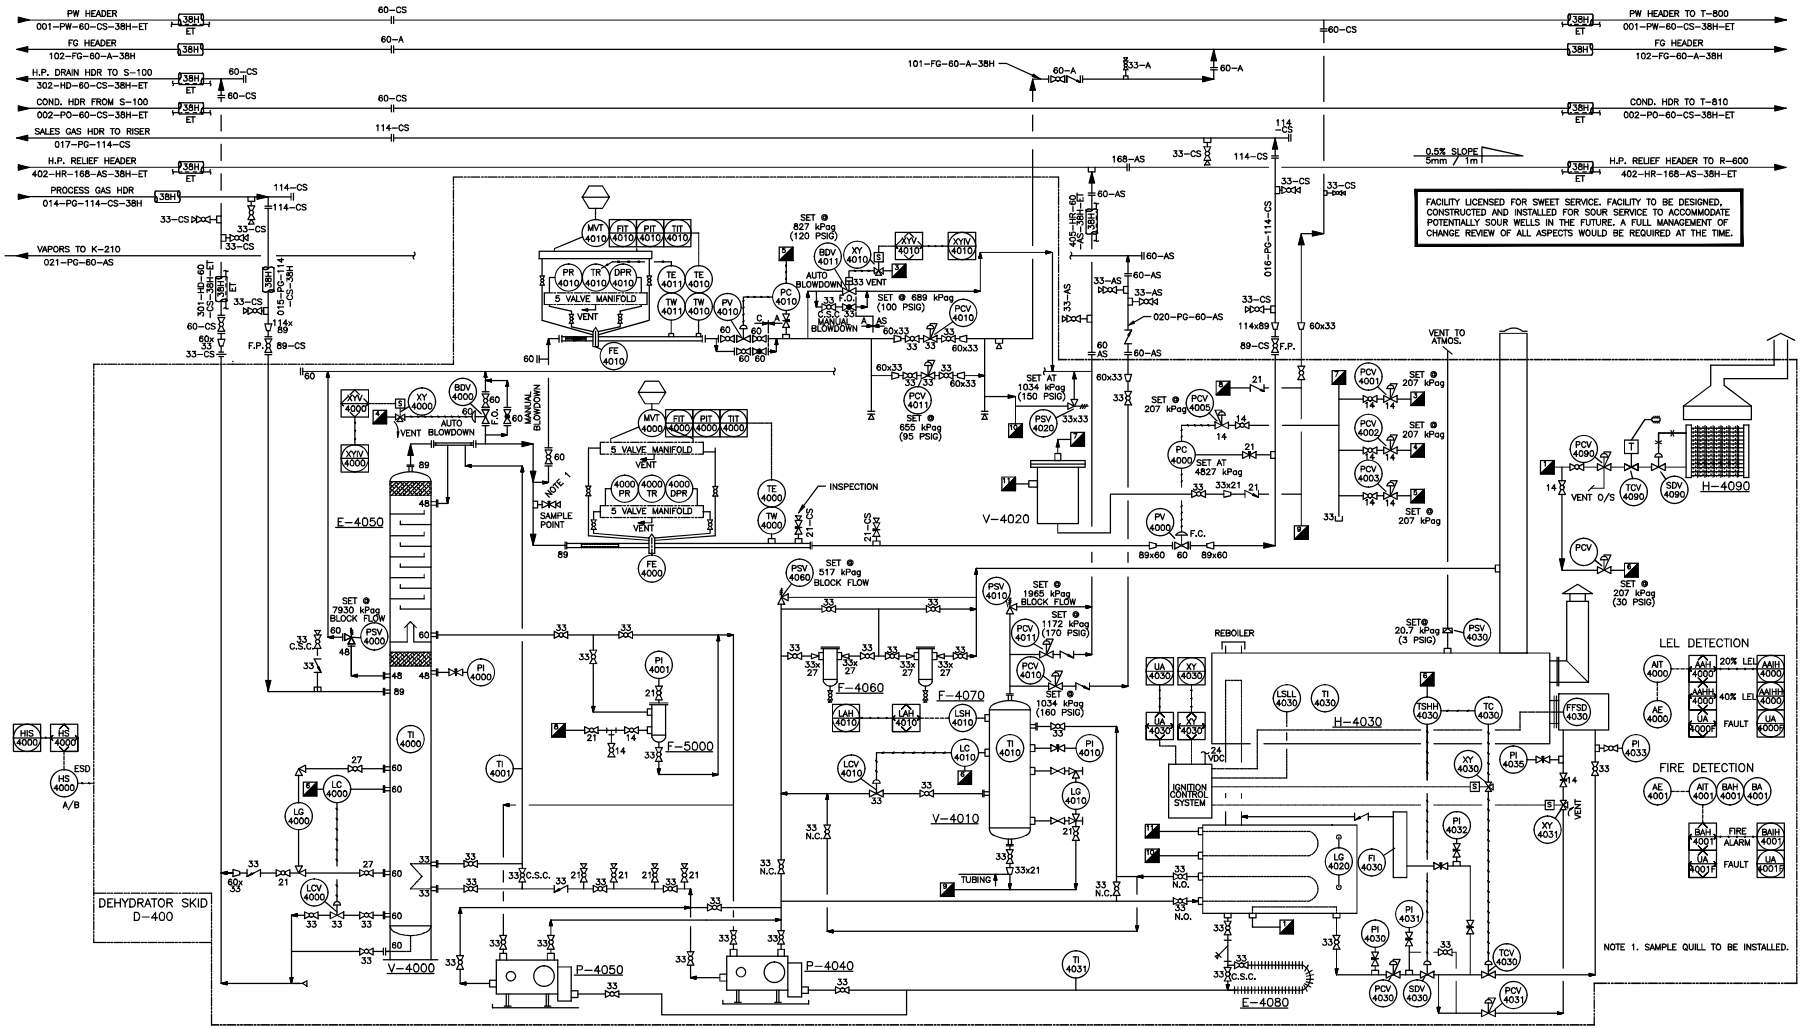

REV.	DESCRIPTION	BY	DATE	CHK	APP.	CLIENT
7	AS-BUILT	ZM	2009-03-30		NW	
6	ISSUED FOR CONSTRUCTION	EW	2009-01-09		NW	
5	ISSUED FOR OGC APPROVAL	DT	2009-01-06		NW	
4	ISSUED FOR BID	DT	2008-12-11		NW	
3	ISSUED FOR APPROVAL	DT	2008-11-27		NW	

DRAWING NO.	REFERENCE DRAWINGS
2385-01-PID-3011-D	DEHYDRATION SKID D-400
2385-01-PID-3011	PID MODEL

CNRL

DRAWN BY: K. KWAN	DATE 2011-10-11
DESIGNED BY: B. LEIDAL	DATE 2011-10-11
CHECKED BY:	DATE
APPROVED BY:	DATE
CLIENT BY:	DATE

Canadian Natural

TITLE: NIG (3102) COMPRESSOR STATION
b-97-H 94-H-4
DEHYDRATION SKID D-400
PIPING AND INSTRUMENTATION DIAGRAM

SCALE	JOB NO.	DRAWING NO.	REV.
N.T.S.	–	NIGb97H-220-0004	7