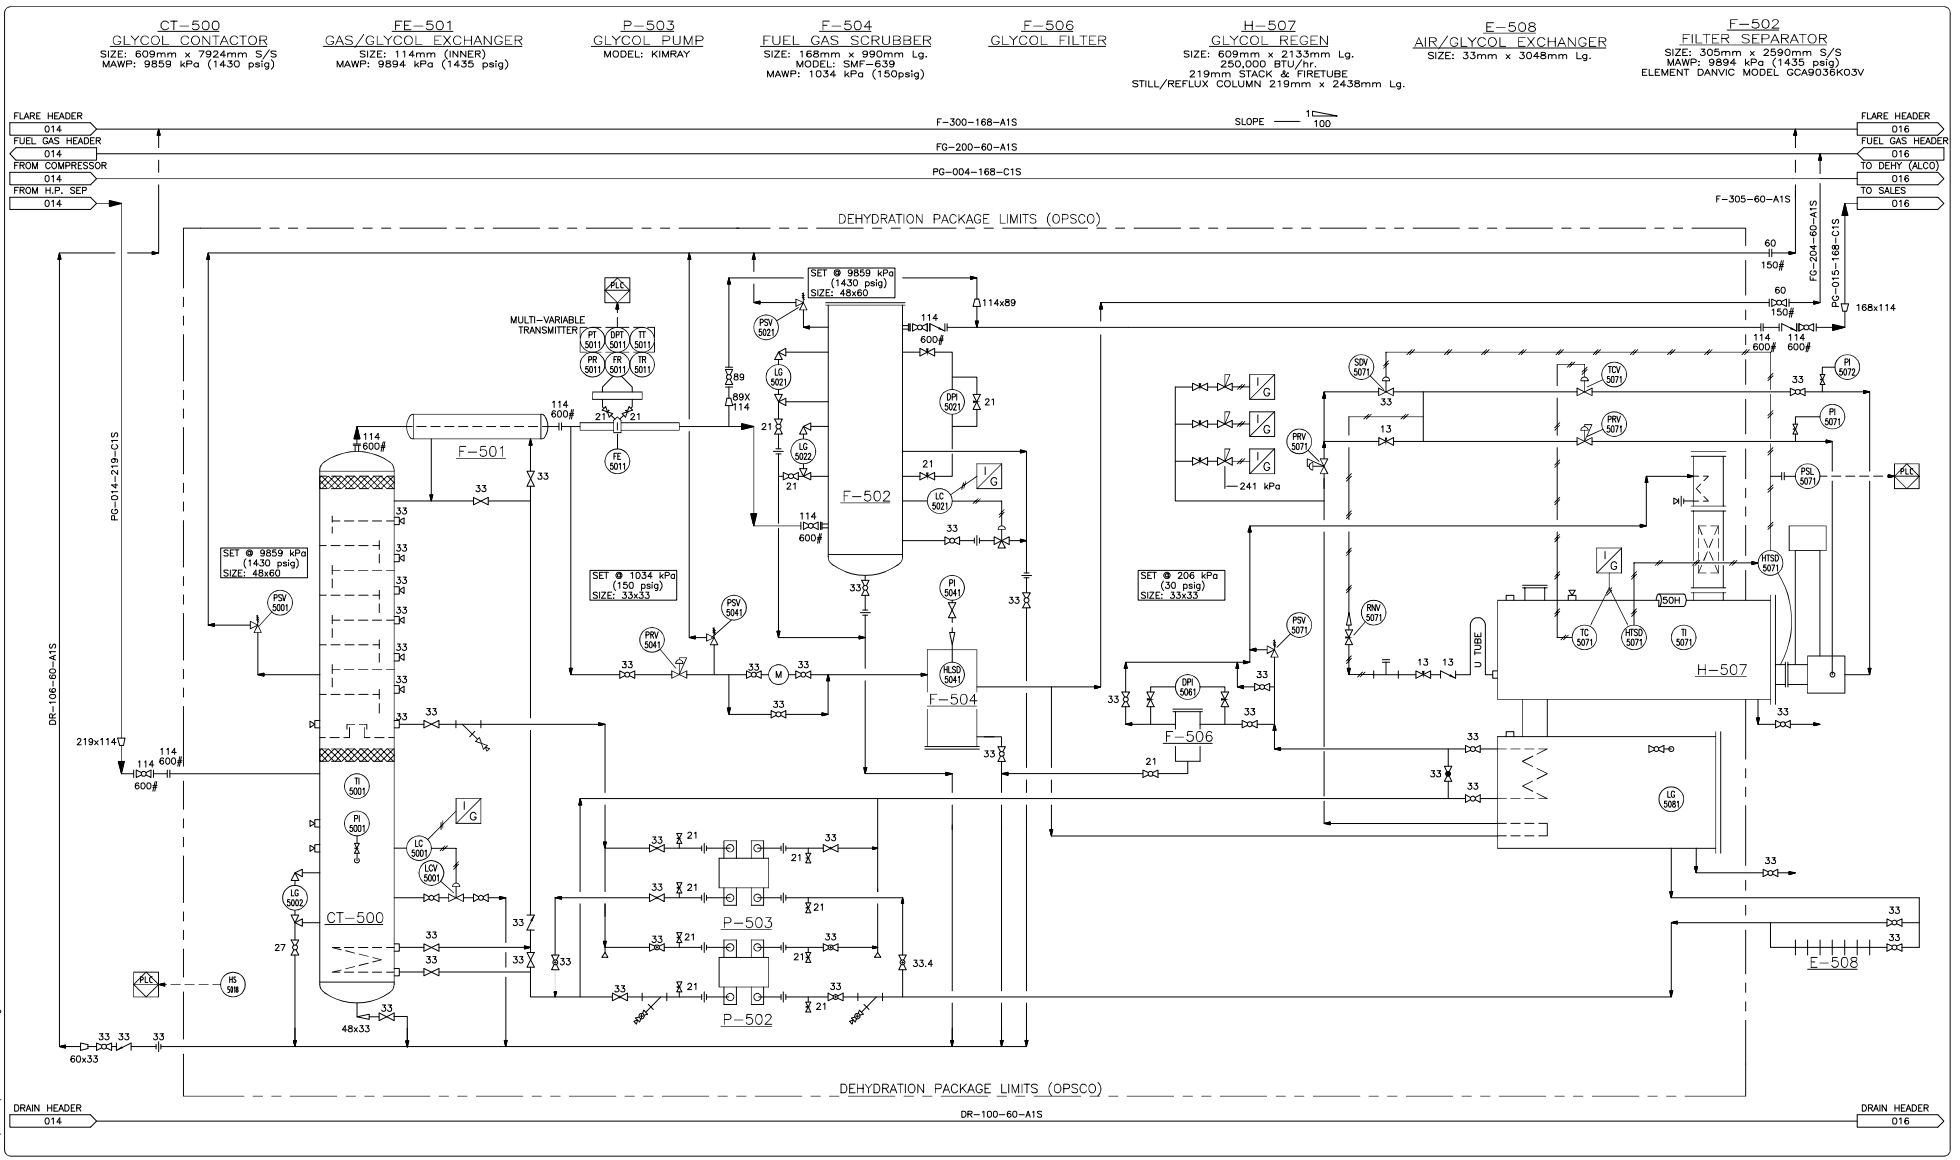

REV	DESCRIPTION	BY	DATE	CHK	APP
1	AS BUILT	DPK	01/09/19		
0	ISSUED FOR CONSTRUCTION	SJ	01/03/07		

REFERENCE DRAWING

SEAL:

PERMIT:

PREPARED FOR: GENESIS Exploration Ltd.

PREPARED BY: POLARIS ENGINEERING LTD.

SOUTH STURGEON COMPRESSOR STATION
LSD 15-16-69-22 W5M

DEHYDRATION BUILDING (OPSCO) AREA
PROCESS & INSTRUMENTATION DIAGRAM

DRAWN BY:	SCALE:	JOB NUMBER:	DRAWING NUMBER:	REV NO:
SJ	NTS	20129	015	1

X:\Project\Drawings\P&ID's\Rev1\20129-015.dwg