H-3114
BUILDING HEATER
(1) RUFFNECK MIN AH-16A-A5A1-A1-2A
GLYCOL HEATER - 84,000 BTU/HR
C/W 1/4 HP TEXP FAN MOTOR
115 VAC/1PH/60Hz, XT-212 T'STAT

T-310
GLYCOL CONTACTOR
SIZE: 914mm I.D. x 8534mm S/S
D.P.: 9756 kPa @ -26.8/55°C C.A.: 1.6mm
[c/w] STRUCTURED PACKING, 15'-0" BED (ACS)
[c/w] 2-PHASE x 1981mm INTEGRAL SCRUBBER

E-312
GAS/GLYCOL HEAT EXCHANGER
11-72 NEN SHELL & TUBE TEMA-'C'
D.P.: 11376 kPa @ -29/121°C C.A.: 1.6mm
157 032 BTU/HR. DUTY

P-316A/B
GLYCOL PUMP(S)
7.5 HP TEXP, 480 VAC/3PH/60Hz TEXP
(2) MYERS M/N MA-15M
RECIP. PUMPS
6.1 GPM @ 1650 psig

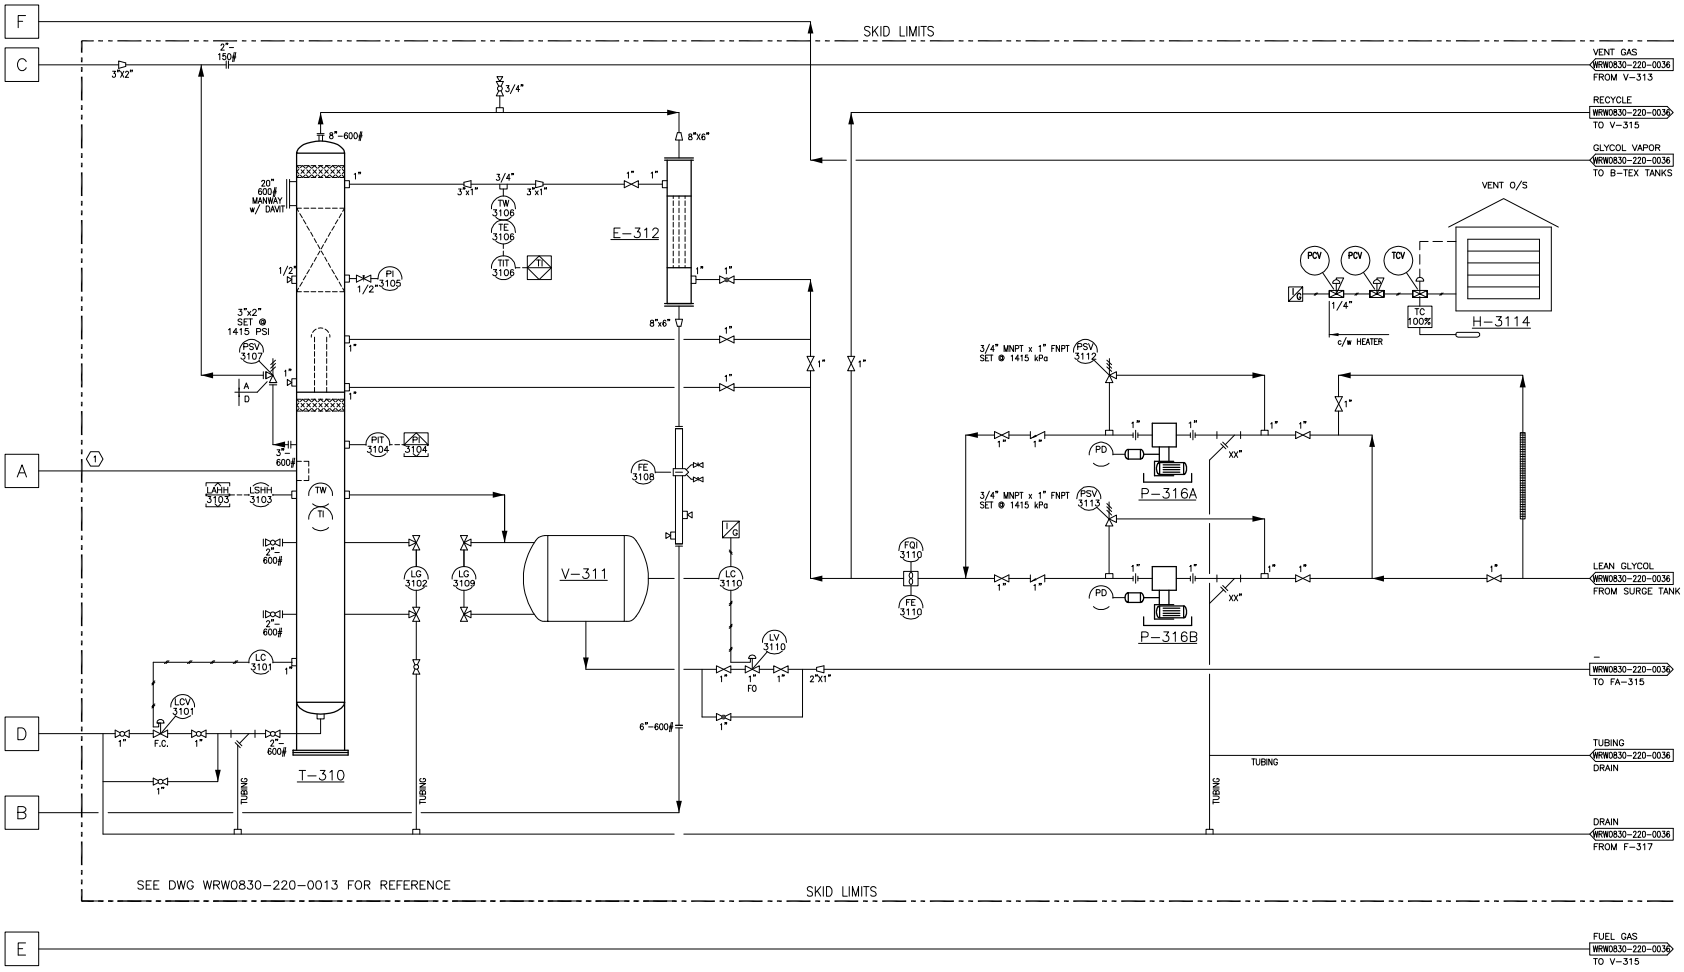

REV.	DESCRIPTION	BY	DATE	CHK	APP.	CLIENT
1	FIELD AS BUILT	MF	2015-02-26	TO	BK	
A	ISSUED FOR AS-BUILT	MH	2014-09-11			

DRAWING NO.	REFERENCE DRAWINGS
WRW0830-220-0013	DEHY BUILDING #4 P&ID

CANADIAN NATURAL

DRAWN BY: M. HUYNH	DATE 2014-09-11
DESIGNED BY:	DATE
CHECKED BY:	DATE
APPROVED BY:	DATE
CLIENT BY:	DATE

Canadian Natural

TITLE
WILD RIVER WEST (1053)
08-30-057-24W5
DEHYDRATION UNIT #4
PROCESS & INSTRUMENTATION DIAGRAM

SCALE	JOB NO.	DRAWING NO.	REV.
N.T.S.	130006	WRW0830-220-0035	1