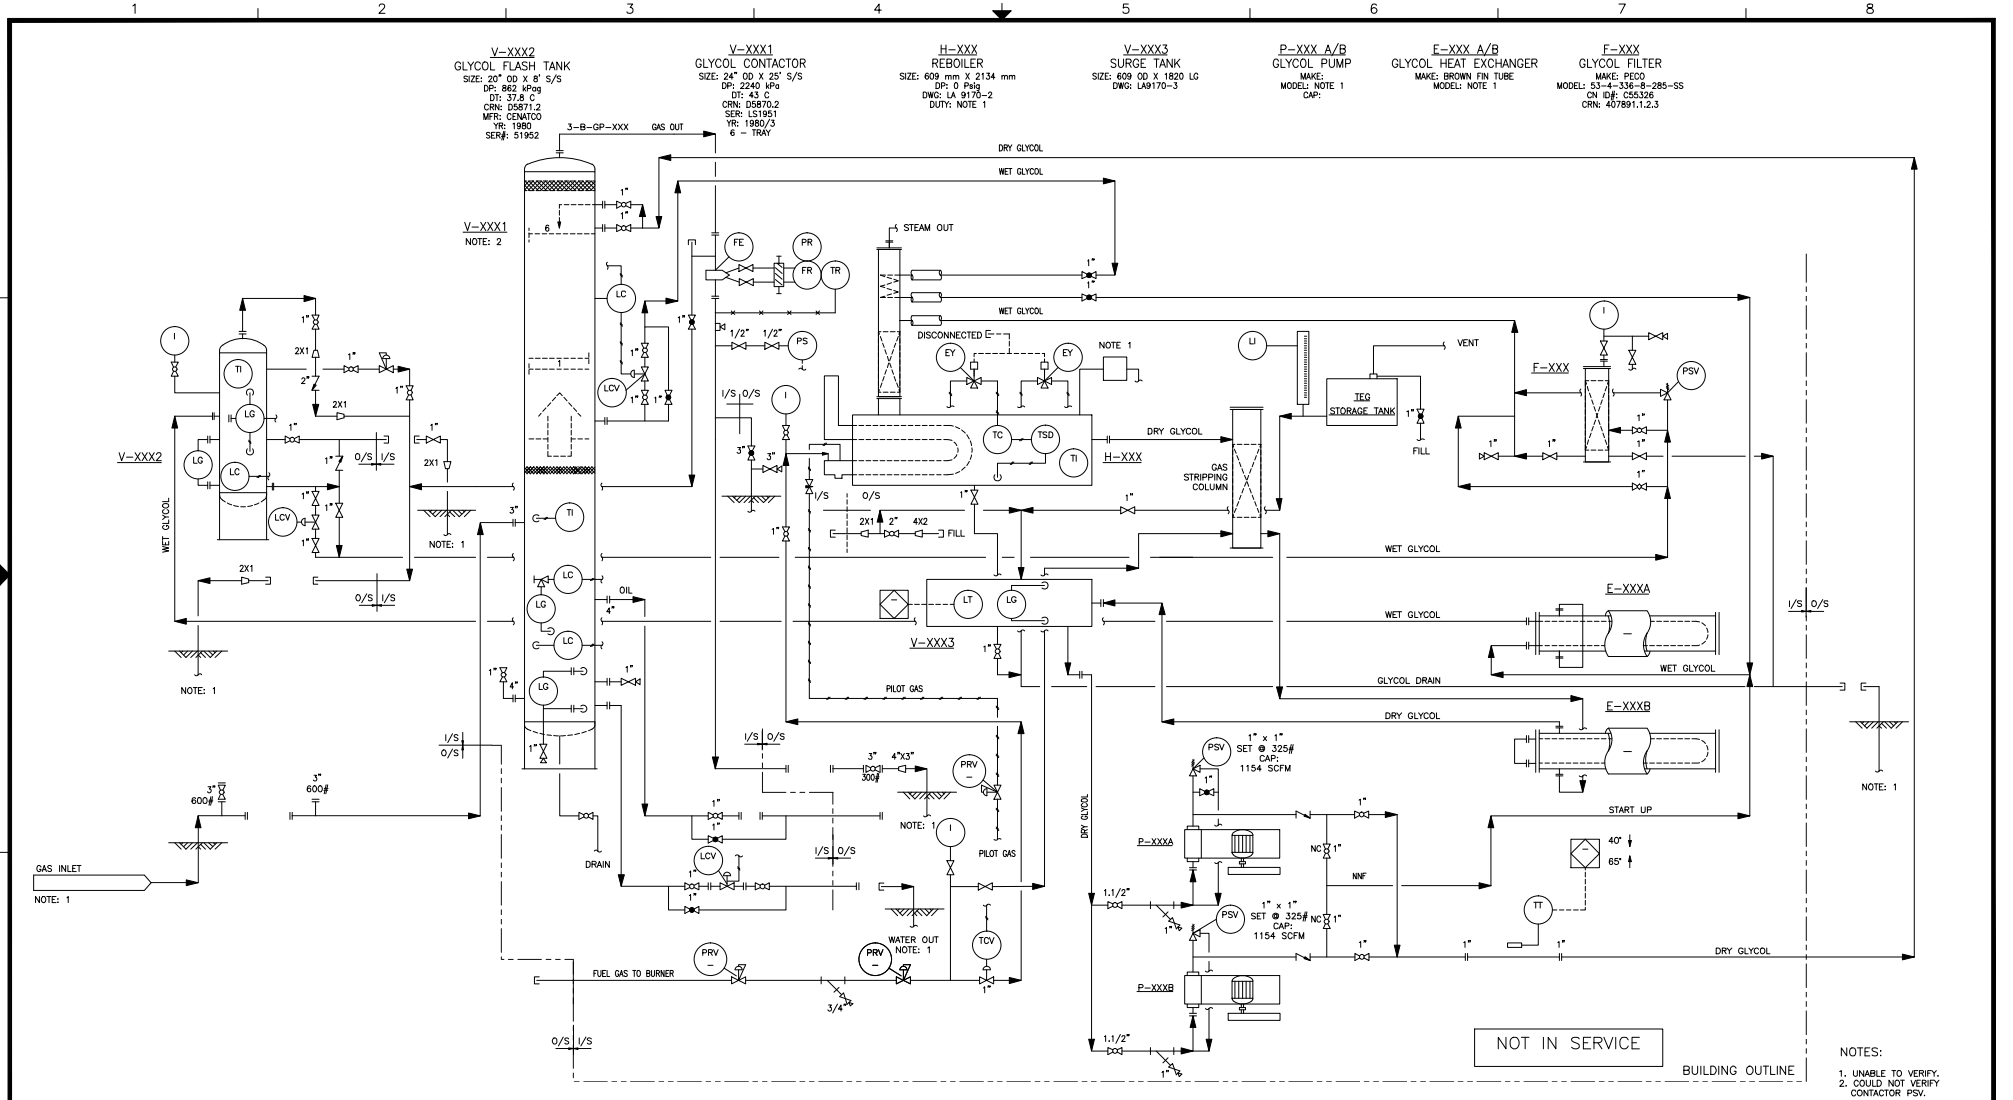

AS-BUILT W/O AUTHENTICATION

This drawing is solely prepared for AS-BUILT ITEMS RECORDED IN PLACE no assumption of liability is taken by the maker of this drawing, all items showed are to be field verified prior to any maintenance, construction or modification to the site or drawing.

REV.	DESCRIPTION	BY	DATE	CHK	APP.	CLIENT
0	AS-BUILT (REDLINE 102476)	RB	2018-04-04	JVB		

DRAWING NO. | REFERENCE DRAWINGS | CANADIAN NATURAL

DRAWN BY: | DATE
DESIGNED BY: | DATE
CHECKED BY: | DATE
APPROVED BY: | DATE
CLIENT BY: | DATE

Canadian Natural

TITLE: STURGEON LAKE CENTRAL BATTERY
10-29-71-23W5M
NATCO DEHYDRATOR
PIPING AND INSTRUMENTATION DIAGRAM

SCALE	JOB NO.	DRAWING NO.	REV.
N.T.S.	–	SNN1029-220-0004	0