

E-455  
GAS/GLYCOL HEAT EXCHANGER  
114mm O/D x 180mm I.D. x 2040 L.C.  
10250 MPa @ 0 - 25/30°C

P-461  
GLYCOL PUMP  
MURPHY #3015 PV  
30 CPM

F-453  
H.P. GLYCOL FILTER  
MORRIS 1871C  
8020 MPa USP

V-452  
FUEL GAS SCRUBBER  
ALCO #C-178  
273mm O/D x 2325mm S/Z  
153 MPa @ 0 - 25/30°C

V-451  
FUEL GAS COALESCER  
ALCO #A-22846  
210mm O/D x 2435mm S/Z  
1370 MPa @ 0 - 25/30°C


F-454  
CHARCOAL FILTER  
CUMM #182  
1207 MPa USP @ 121°C  
1/4 CONICAL ELEMENT

TK-100  
GLYCOL STORAGE TANK  
HEATED/INSULATED  
614 LITRE PORTABLE

H-460  
GLYCOL RECONCENTRATOR  
ALCO MODEL #R3000000  
110mm O/D x 1825mm L.C. REHEATER  
500mm O/D x 1440mm L.C. SURGE  
210mm O/D PICTURE  
210mm O/D x 2040mm L.C. STILL COLUMN  
WITH 16 PACKING & REFLUX COL.  
210mm O/D SURFING COLUMN  
200,000 SURFACE x 210mm O/D FLARE ASSEMBLY

E-463  
AIR/GLYCOL HEAT EXCHANGER  
ALCO #C-8748-A  
43mm x 1310mm L.C. 4-PASS  
504 MPa

DEHYDRATOR SKID BOUNDARY (REF. ALCO GAS & OIL PROD. EQUIP. LTD. DWG. #A-17731)

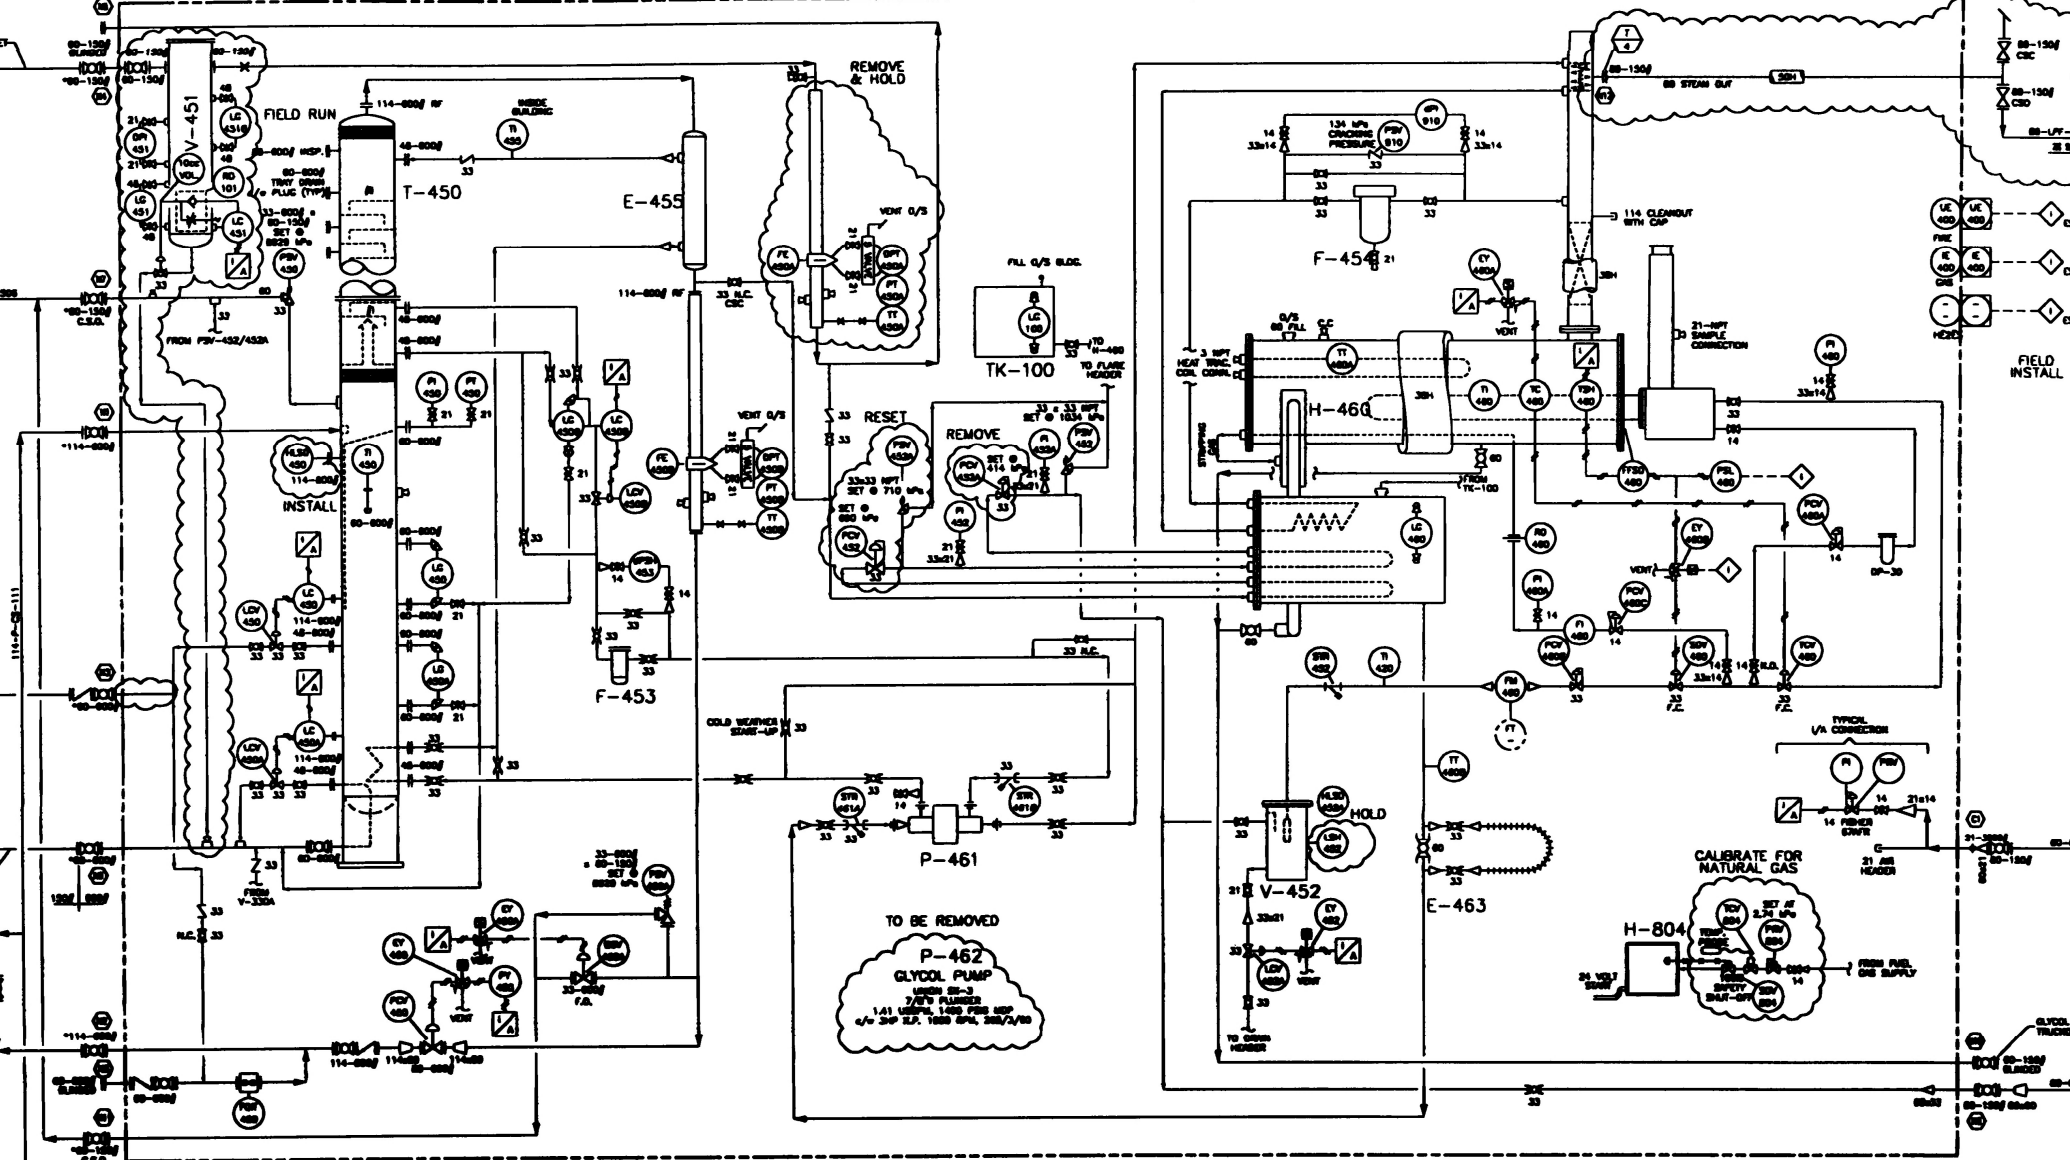

BOU0114-220-0005

1	REVISIONS APPROVED	SI	09-02-18		
2	ISSUED FOR CONSTRUCTION	CLW	09-12-23	IMP	
3	ISSUED FOR REVIEW	CLW	09-12-18		
4	ISSUED FOR APPROVAL PER HSE	CLW	09-12-08	HSE	
5	ISSUED FOR TENDER	CLW	09-10-27		
6	ISSUED FOR APPROVAL	CLW	09-10-08		
7	ISSUED FOR REVIEW	CLW	09-09-02		
8					
9					
10					

Prepared By:	Checked:	Approved:

Prepared For:

**BLUE RANGE RESOURCE CORPORATION**

• CHEMICALS  
• REFRIGERATION  
• CONDENSERS  
• DISTILLATION  
• PROCESS ENGINEERING

**SOUTH CLEAR HILLS COMPANY**

P&ID - DEHYDRATOR  
LSD. 01-14-87-

Drawn	Scale	By
CLW	NONE	D-MFS

P:\114-220\114-220-0005.DWG  
PLOTTER: PLOT 15, 1000 200 PPI