


V-440
 LOW PRESSURE FLARE KNOCKOUT DRUM
 SIZE: 1820 mm Ø x 3658 mm S/S
 CAP: 50 BBL'S

FL-430
 HIGH PRESSURE FLARE STACK
 SIZE: 219 mm Ø x 324 mm Ø x 13726 mm TALL (STACK)
 FREE STANDING
 KNOCKOUT: 1500 mm TALL
 CONTINUOUS ELECTRIC PILOT

FL-450
 LOW PRESSURE FLARE STACK
 SIZE: 89 mm Ø x 16200 mm TALL

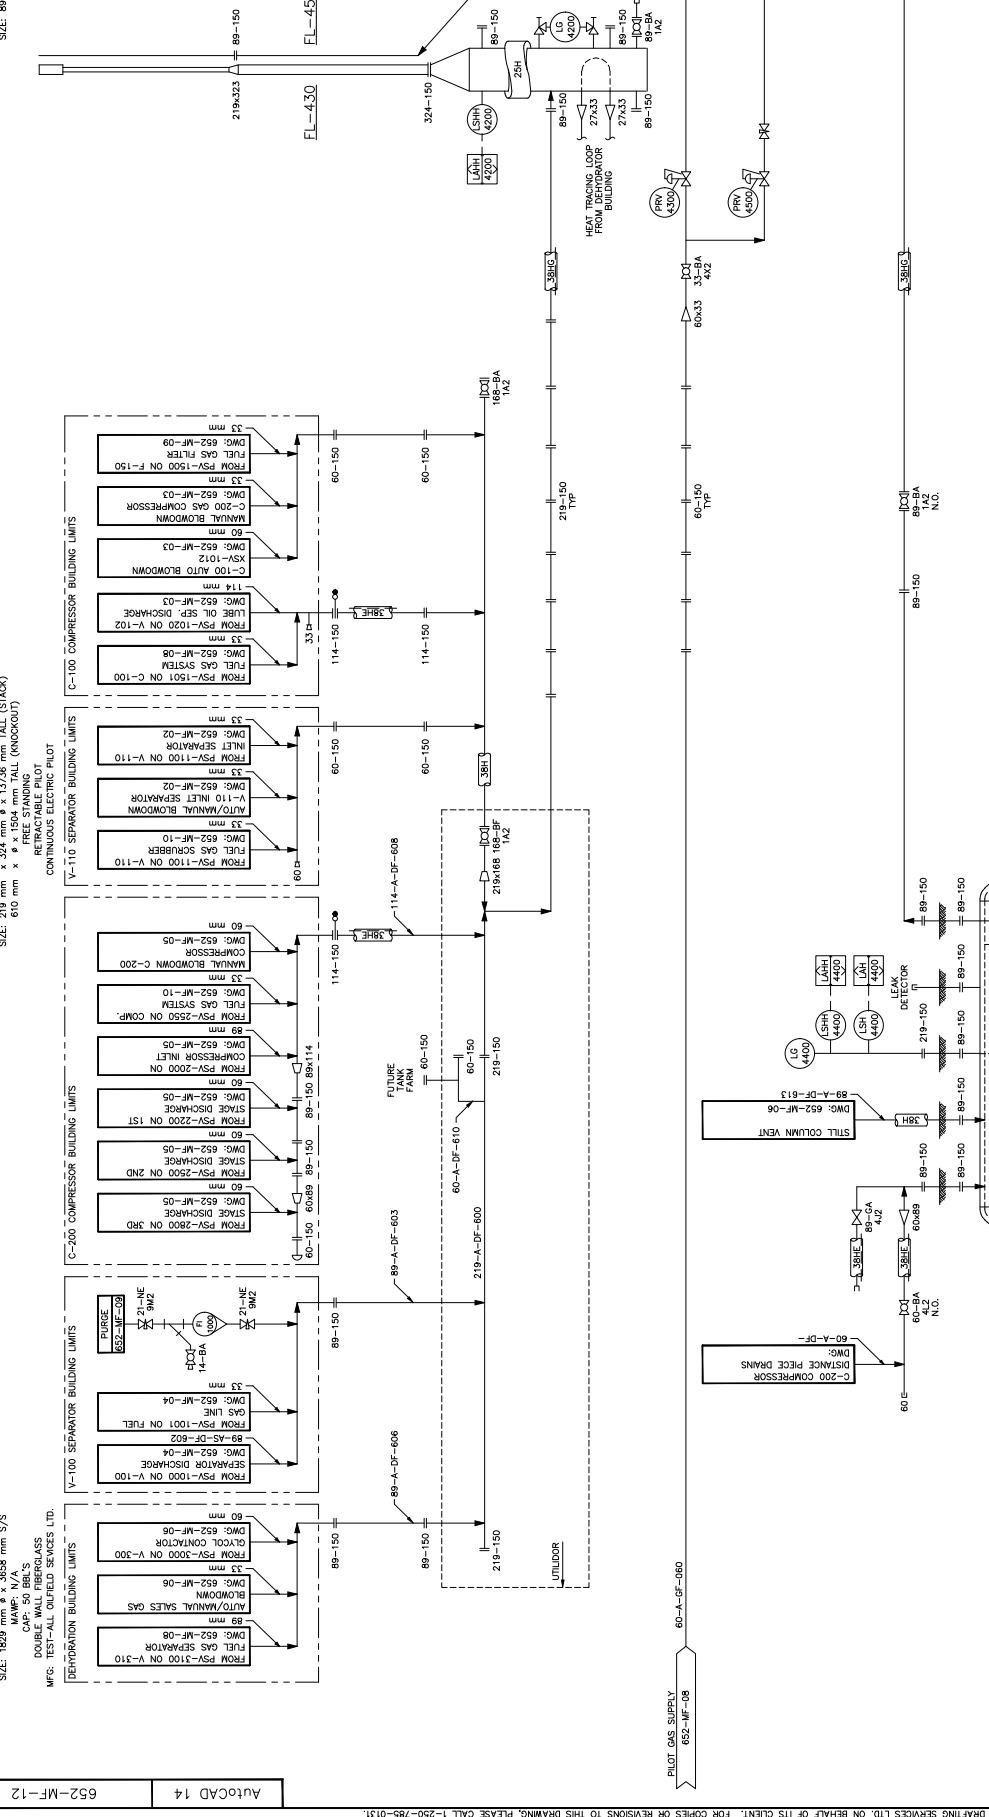

AutoCAD 14

NO.	DATE	REVISIONS
1	23.05.05	AS-IS
0	05.06.96	ISSUED FOR CONSTRUCTION




NORTHERN DRAFTING SERVICES LTD.
 OFFICE DESIGN AND DOCUMENTATION
 1-245-795-0311

APPROVED FOR CONSTRUCTION
 BY: _____ DATE: YY MM DD
 BY: _____ DATE: YY MM DD

Canadian Natural

d-39-E, 94-A-16 PEELAY COMPRESSOR STATION
 HIGH AND LOW PRESSURE FLARE SYSTEMS
 MECHANICAL FLOW DIAGRAM

CLIENT FILE NO. _____ SCALE: NORTHERN DRAWING NUMBER
 CLIENT DWG NUMBER _____ NIS
 1

PROFESSIONAL AND PERMIT STAMPS AFFIXED HEREUNDER SHALL APPLY ONLY TO REVISION(S) X




