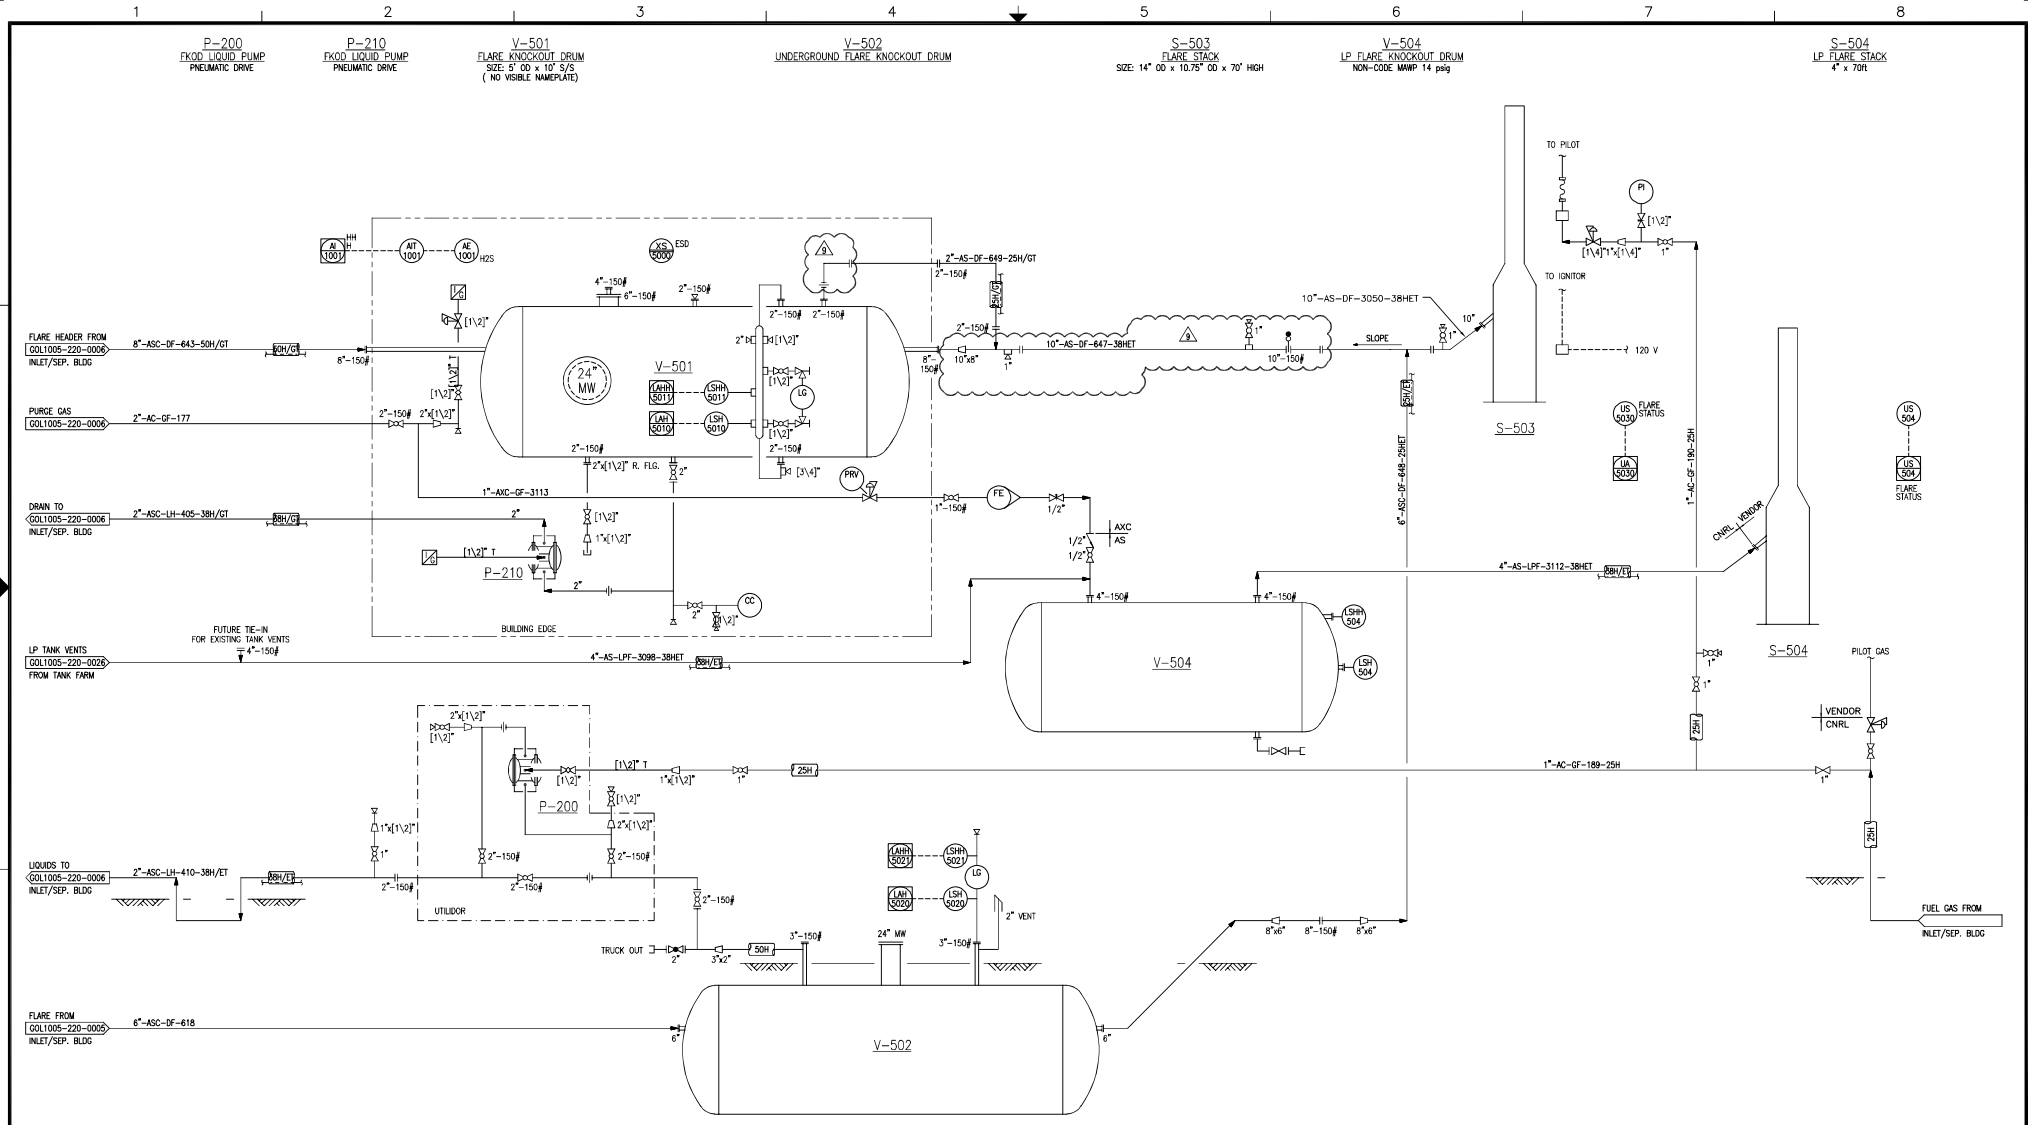

DRAWING NO.	REFERENCE DRAWINGS

CANADIAN NATURAL

REV.	DESCRIPTION	BY	DATE	CHK	APP.	CLIENT
7	AS-BUILT	VC	2018-11-27	AD		
6	ISSUED FOR CONSTRUCTION	VC	2017-07-11	AD		
5	AS-BUILT	VC	2017-06-29	AD		
4	ISSUED FOR CONSTRUCTION	VC	2017-02-21	AD		
3	AS-BUILT	VC	2017-02-21	AD		
2	ISSUED FOR CONSTRUCTION	MF	2015-07-07	AD		
9	AS BUILT - MOC-2020-1642-021 - FC200295	MF	2021-07-06	GT	GT	
8	IFC - VELVET COMPRESSION RECONFIG - MOC-2020-1642-021 - FC200295	MF	2021-03-30	SL	SL	

DRAWN BY: GZX	DATE 2005-04-11	
DESIGNED BY:	DATE	
CHECKED BY:	DATE	
APPROVED BY:	DATE	
CLIENT BY:	DATE	

Canadian Natural

TITLE
GOLD CREEK COMPRESSOR STATION
LSD: 10-05-068-04W6
FLARE KNOCK OUT DRUMS & FLARE STACK AREA
PIPING & INSTRUMENTATION DIAGRAM

SCALE	JOB NO.	DRAWING NO.	REV.
N.T.S.		GOL1005-220-0010	9