T-600
FLARE K.O. DRUM
SIZE: 5 ft x 10 ft – CAPACITY: xxx
VENDOR: TORNADO – S/N: 8024B
WALL: SINGLE/DOUBLE – TESTED 75PSI
DESIGN PRESSURE: xxx oz./ xxx oz. (vac)
DESIGN CODE: API 650/API 12F/NON-CODE
DESCRIPTION: (NO EQUIPMENT TAG)
FLOAT CHAMBER C38333
INTERNALLY COATED – C38332

R-610
FLARE STACK
SIZE: 4" O.D. x 30' HIGH
STACK WAS REPLACED
BY OPERATIONS

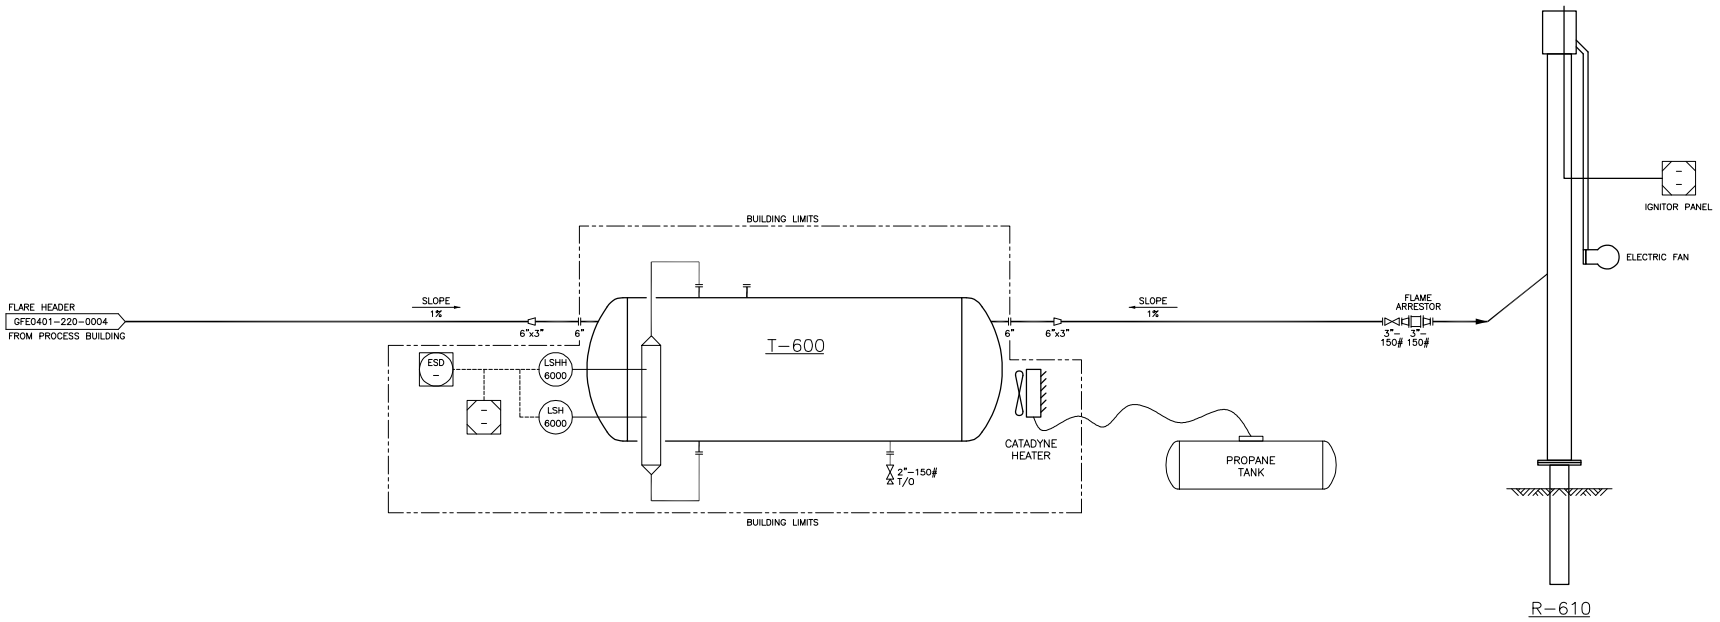

REV.	DESCRIPTION	BY	DATE	CHK	APP.	CLIENT
1	POST CONSTRUCTION AS BUILT (FCR# 12050)	MF	2013-08-22	NO		
0	AS BUILT	SZ	2012-07-27	LD	GA	NO

DRAWING NO. | REFERENCE DRAWINGS | CANADIAN NATURAL

DRAWN BY: S.ZIADEH	DATE 2012-06-10
DESIGNED BY:	DATE
CHECKED BY: LD	DATE
APPROVED BY: GA	DATE
CLIENT BY: NO	DATE

Canadian Natural

TITLE
GRAND FORKS EAST, AB
04-01-013-13 W4M
FLARE K.O. DRUM & STACK
P&ID

SCALE	JOB NO.	DRAWING NO.	REV.
N.T.S.	3362	GFE0401-220-0017	1