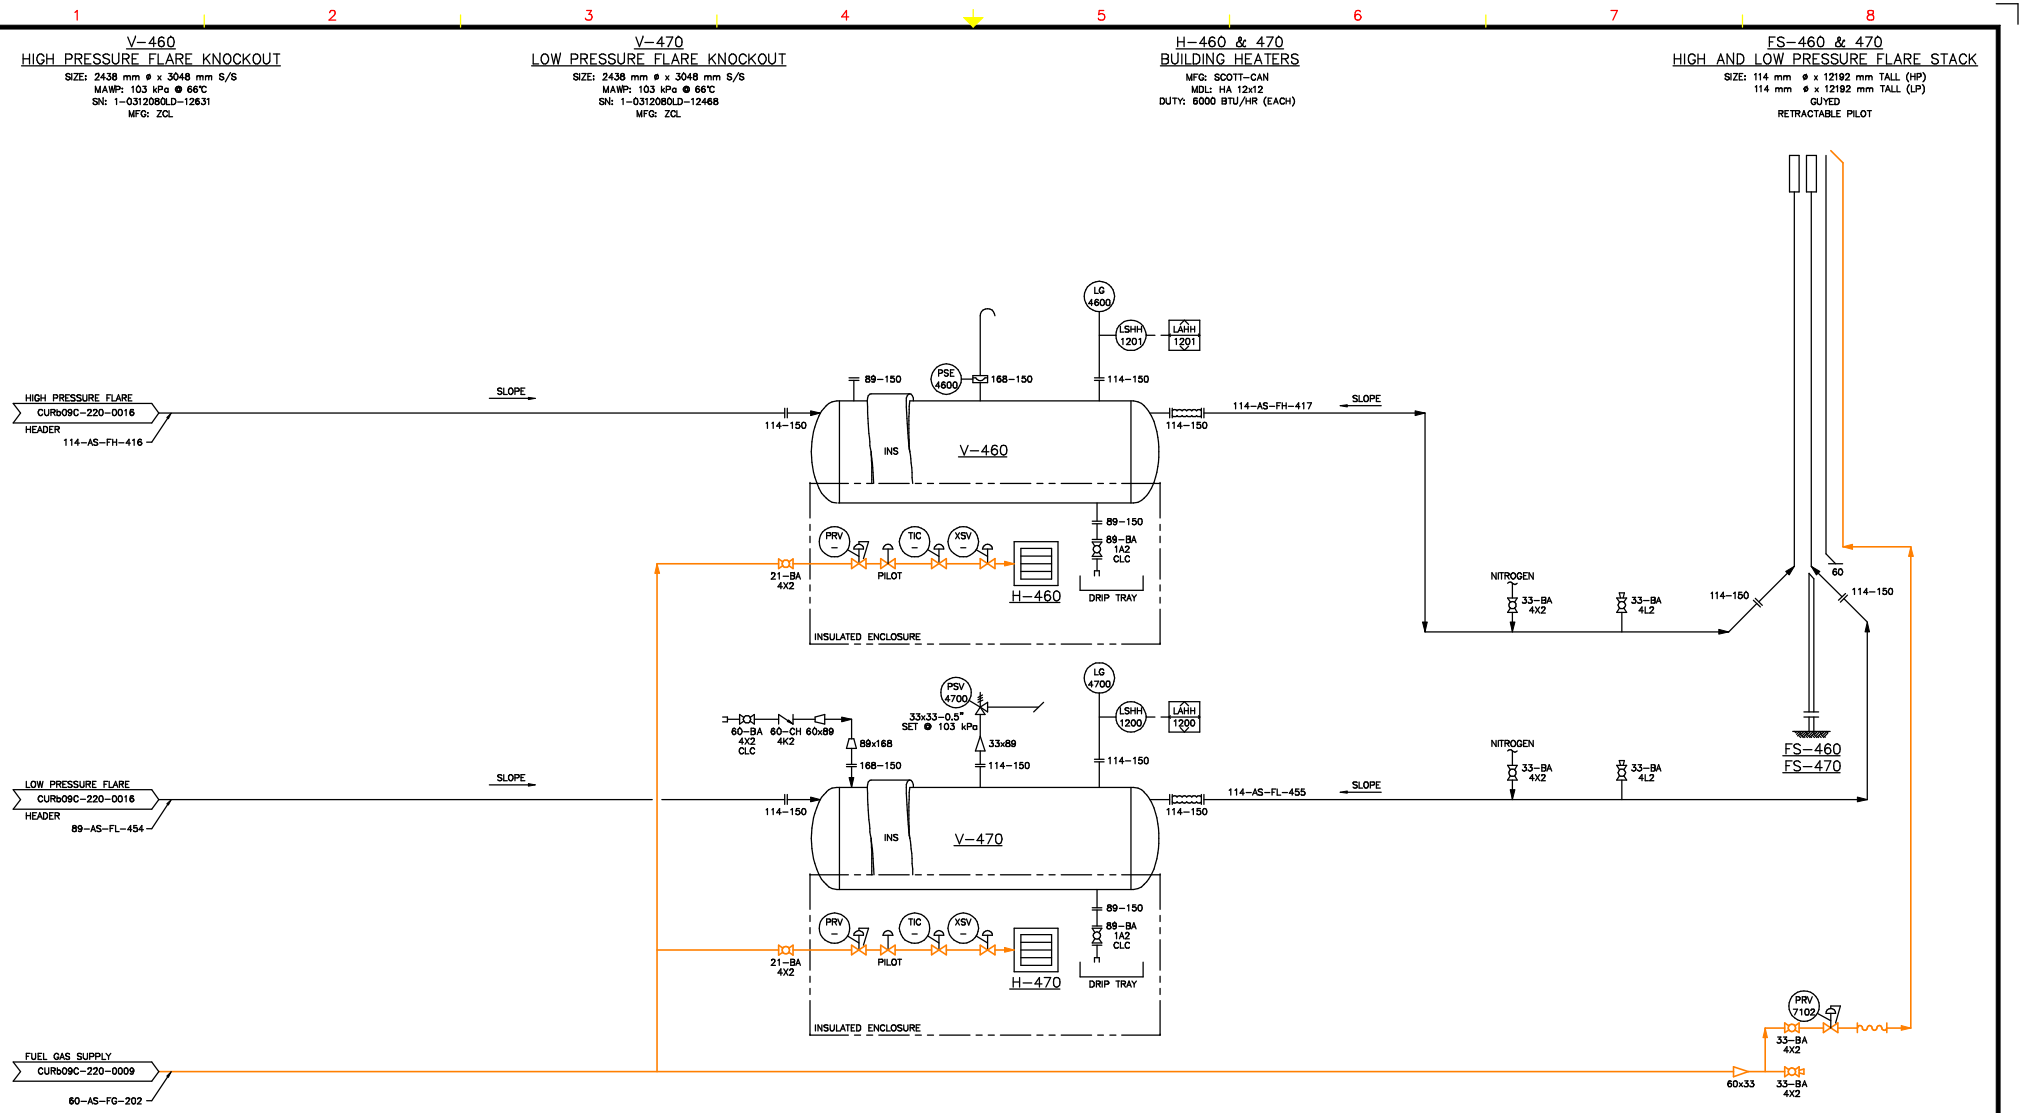

DRAWING NO.	REFERENCE DRAWINGS	
		NDSL

REV.	DESCRIPTION	BY	DATE	CHK	APP.	CLIENT
2	ASSET TRANSFER. AS-IS AS PER FIELD VISIT	WRM	2011-06-01	WRM		
1	AS-IS	WRM	2008-02-22	WRM		

DRAWN BY: WRM	DATE 2008-02-22
DESIGNED BY:	DATE
CHECKED BY:	DATE
APPROVED BY:	DATE
CLIENT BY:	DATE

Canadian Natural

TITLE
CURRANT COMPRESSOR STATION
b-09-C, 94-A-16
HIGH/LOW PRESSURE FLARE KNOCKOUTS/STACKS
PROCESS AND INSTRUMENTATION DIAGRAM

SCALE	JOB NO.	DRAWING NO.	REV.
N.T.S.	–	CURb09C-220-0017	2