FS-9310	S-9300	S-820/821	I-822	P-9320	S-805/806	F-840	H-835/836	G-800	G-810
FLARE STACK 2736x3048mm HIGH c/w 24 VDC IGNITOR (RETRACTABLE) 12V BATTERY BACK-UP	FLARE KNOCK OUT DRUM 2440mm ø x 3660mm S/S D.P.: 350 kPa @ -29 TO 38°C C.A. 3mm NOT REGISTERED OPERATES @ 95 kPa MAX	PROPANE TANK 2x2000 USGAL RENTAL	INCINERATOR WEST LAND MODEL 1020 PROPANE 64 kg (140 LB)/HR.	FLARE KNOCK OUT DRUM DRAIN PUMP 10 USGPM @ 100'-0" c/w 5 HP 48DV/3/60 RUPER MODEL 72205	PROPANE TANK 1000 GAL EACH RENTAL	FUEL FILTER CARTRIDGE TYPE	BUILDING HEATERS 2 - CATADYNE 2 - 20000 BTU/HR	GENERATOR CUMMINS 125 KW ENGINE: CTA 855B - 189 HP @ 1200RPM GENERATOR: KATO 6P2-1450 DUAL FUEL	GENERATOR CUMMINS 125 KW ENGINE: CTA 855B - 189 HP @ 1200RPM GENERATOR: KATO 6P2-1450 DUAL FUEL

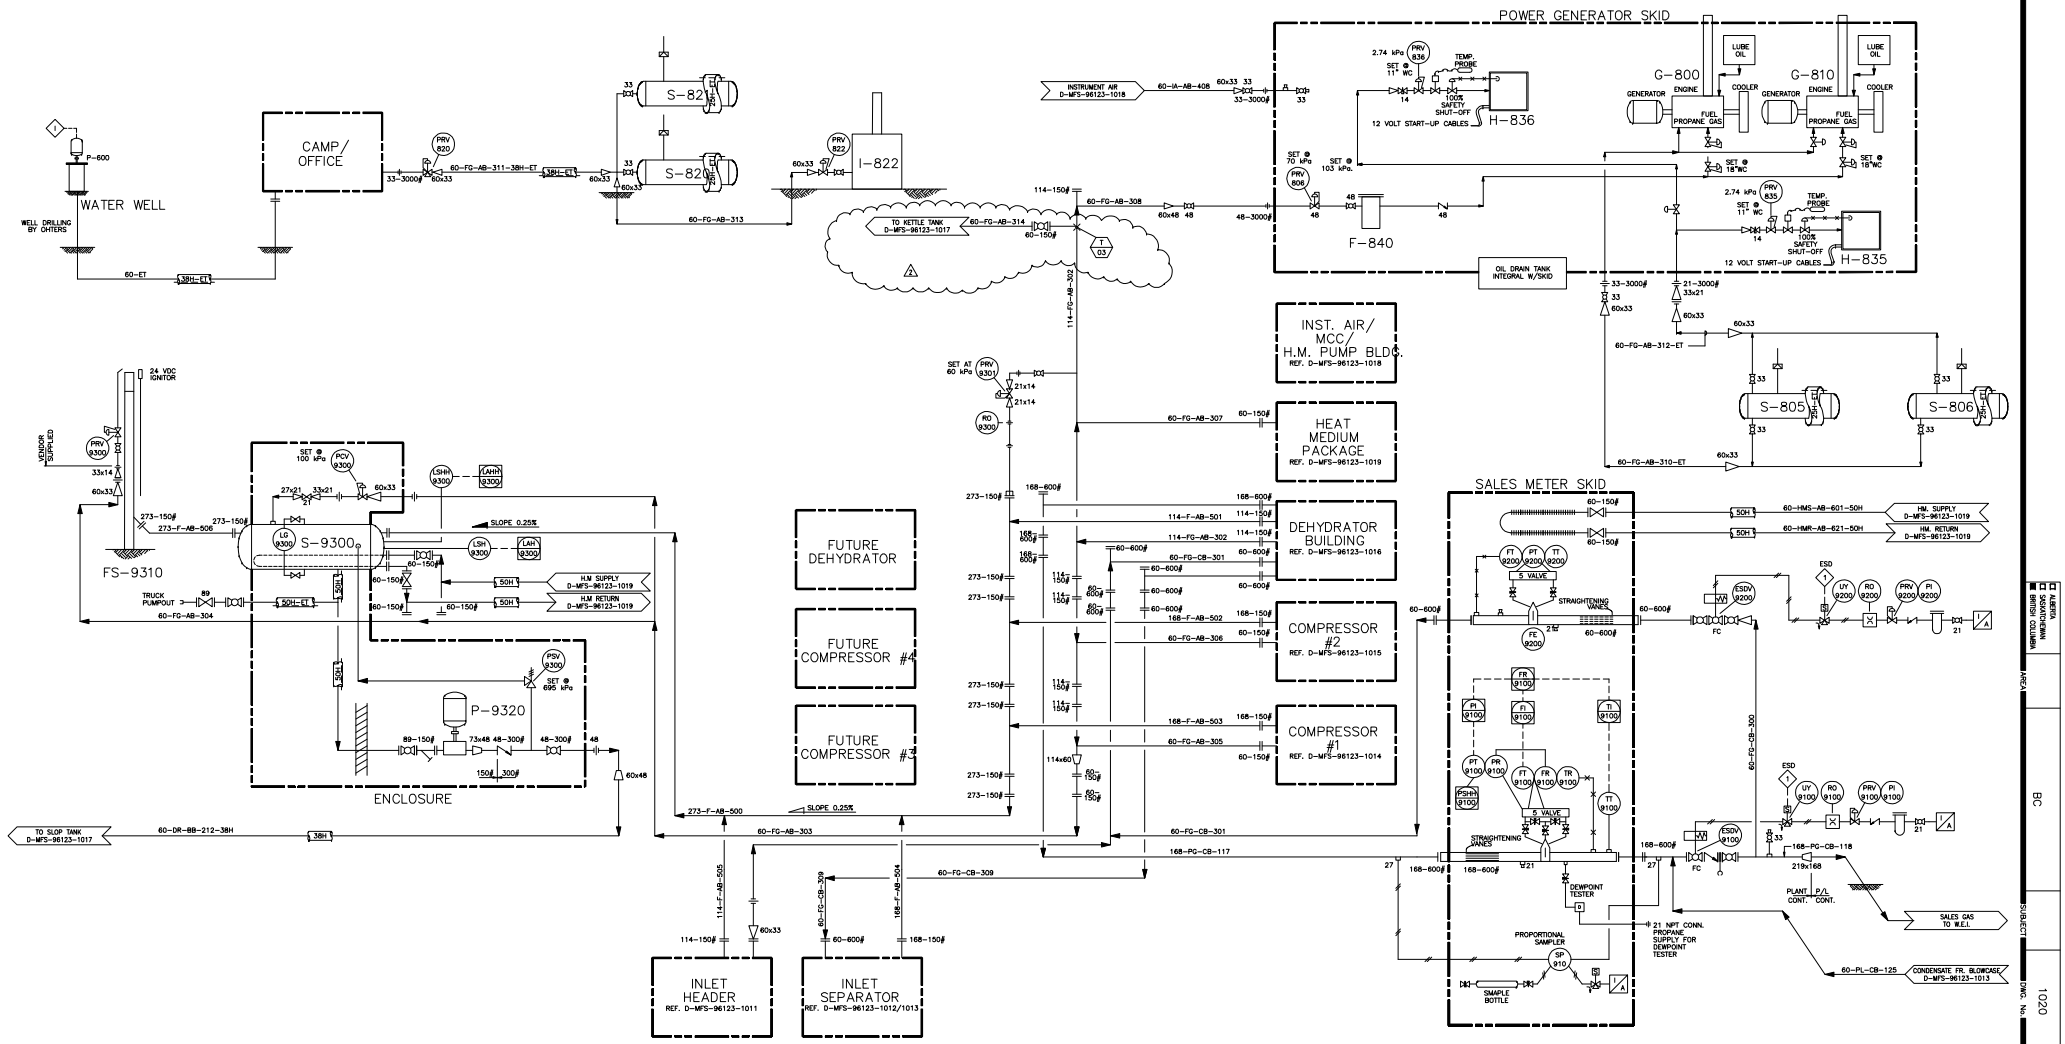

DRAWING No.	REFERENCE DRAWINGS

No.	REVISION	DATE	BY	CHK'D	APP'D	APP'D
1	KETTLE TANK ADDITION ISSUED FOR CONSTRUCTION	98-03-16	CDK			
1	"AS-BUILT"	97-05-15	VRDC			
0	ISSUED FOR CONSTRUCTION	97-01-20	ETC			
D	ISSUED FOR BID	96-12-13	KOC			
C	UPDATED	96-11-28	DCC			
B	REVISED PER CLIENT COMMENTS	96-11-04	RS			
A	NEW DRAWING	96-09-25	RS			

P:/96123/DWGS/61231020.DWG
PLOTTED: JUN 08, 1998 9:01 AM

DATE 97-05-15

APPROVALS

DESIGN

ENGINEERING

MANAGEMENT

BIRLEY/MARTIN CREEK GAS DEVELOPMENT

MECHANICAL FLOWSHEET
FLARE/FUEL/SALES GAS

NUMAC ENERGY
Numac Energy Inc.

DRAWING SHEET NUMBER 1 OF 1

SCALE NONE

D-MFS-96123-1020 2

ALBERTA
SASKATCHEWAN
BRITISH COLUMBIA

AREA BC

SUBJECT

DWG No. 1020