593-MF-21

AutoCAD 14

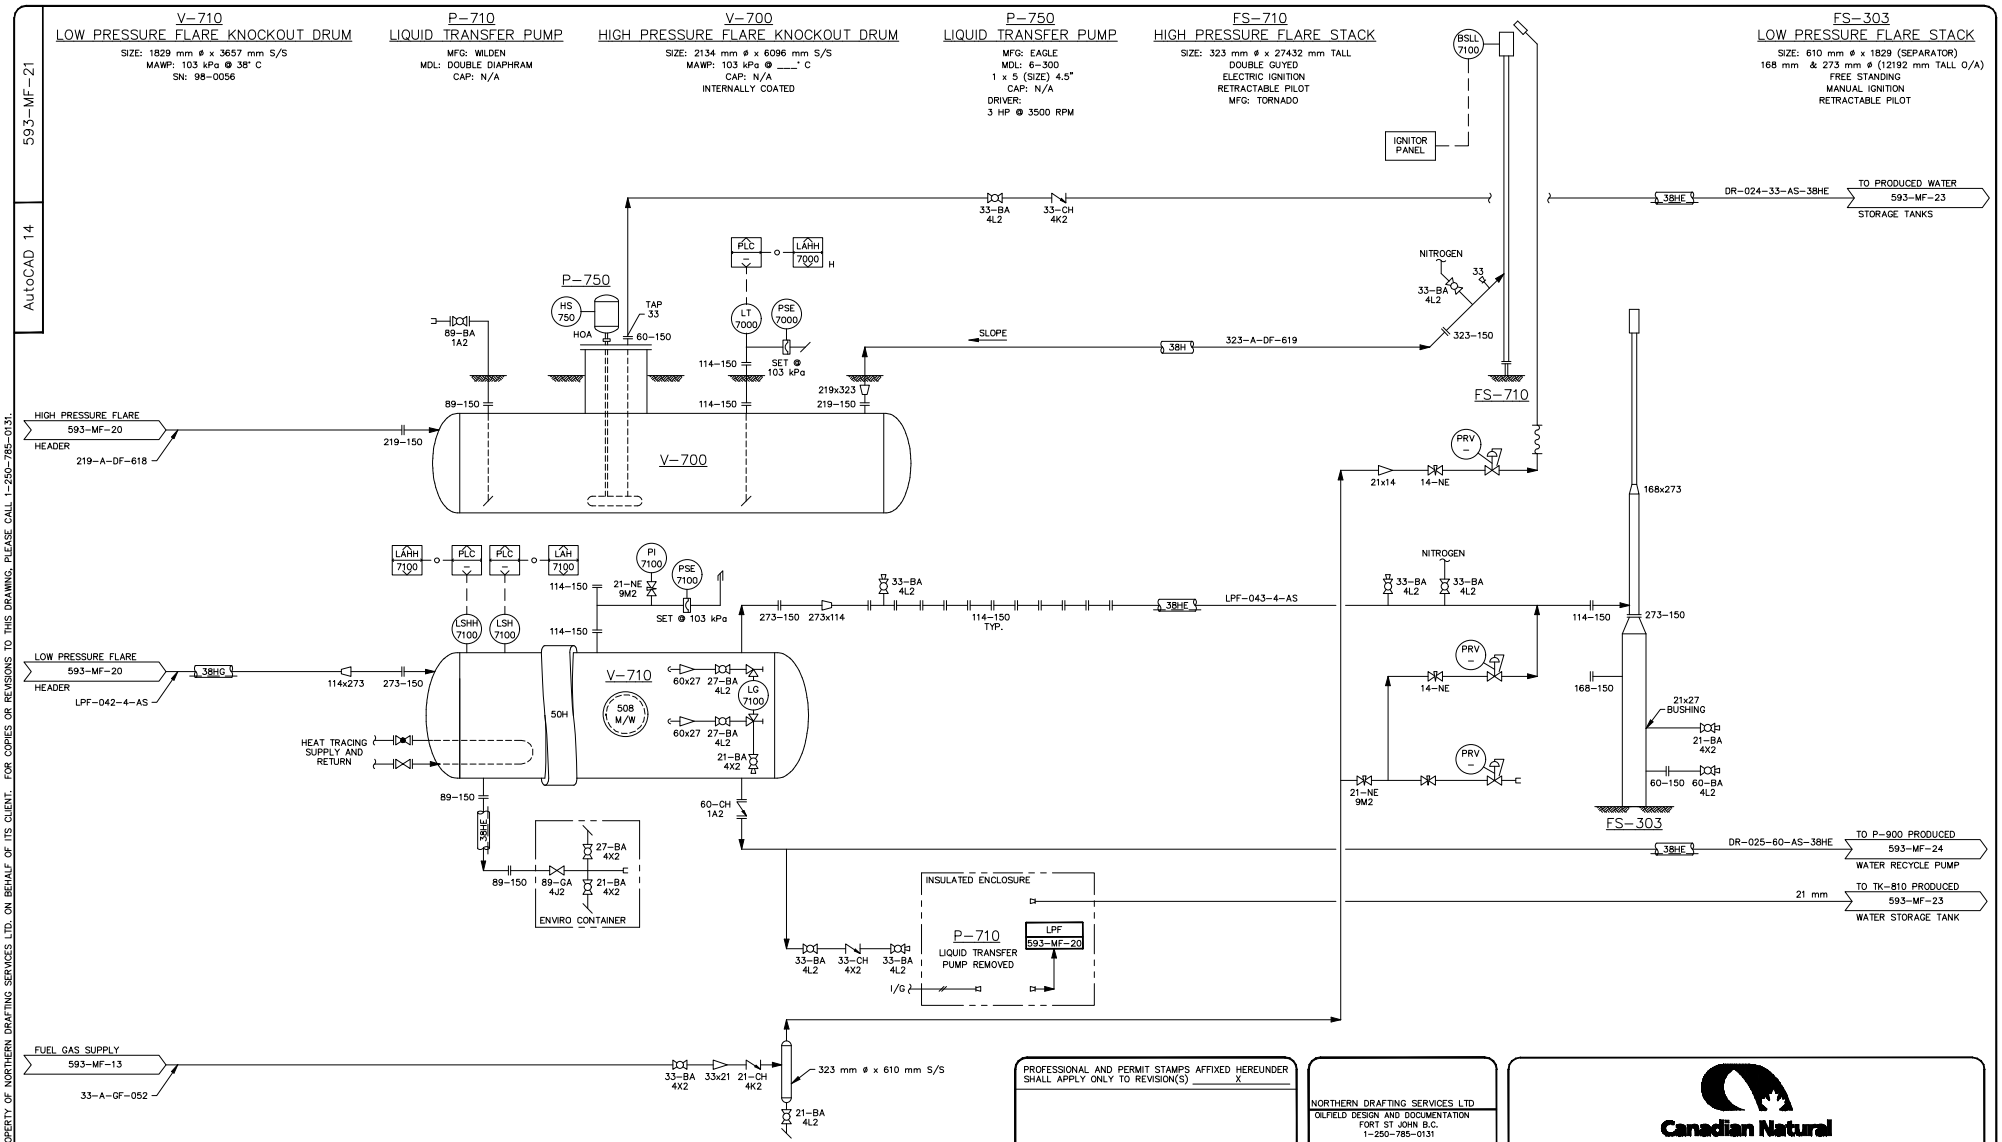

THIS DRAWING IS THE PROPERTY OF NORTHERN DRAFTING SERVICES LTD. ON BEHALF OF ITS CLIENT. FOR COPIES OR REVISIONS TO THIS DRAWING, PLEASE CALL 1-250-785-0131.

NO.	DATE	REVISIONS	DRAWN	CHECK	DESIGN	APPR.
7	24 09 09	AS-IS AS PER FIELD VISIT	WRM	WRM		
6	03 03 04	AS IS AND REDRAWN	WRM	WRM		
5	14 10 03	REVISED AND RE-ISSUED - DPH 6065	DFP			
4	23 05 02	AS BUILT	DPK			
3	29 11 01	REFERENCE TO TIE IN POINT, TANK REMOVAL	RS			
2	29 09 01	REVISED AS BUILT AS PER FIELD MARK-UPS	RS			
			DRAFTING		ENGINEERING	

NO.	TITLE
593-PF-01	PROCESS FLOW DIAGRAM
593-PP-01	MECHANICAL PLOT PLAN
593-MF-01 TO 27	MECHANICAL FLOW DIAGRAMS

REFERENCE DRAWINGS

PROFESSIONAL AND PERMIT STAMPS AFFIXED HEREUNDER SHALL APPLY ONLY TO REVISION(S) _____ X

PROFESSIONAL AND PERMIT STAMPS

NORTHERN DRAFTING SERVICES LTD
OILFIELD DESIGN AND DOCUMENTATION
FORT ST JOHN B.C.
1-250-785-0131

APPROVED FOR CONSTRUCTION

BY_____ DATE YY MM DD

BY_____ DATE YY MM DD

Canadian Natural

a-62-E, 94-G-8 JEDNEY CENTRAL COMPRESSOR STATION
FLARE KNOCKOUTS AND FLARE STACKS
MECHANICAL FLOW DIAGRAM

CLIENT FILE NO.	SCALE	NORTHERN DRAWING NUMBER	REV.
-	NTS	593-MF-21	7
CLIENT DWG NUMBER: JEDa62E-220--0021			