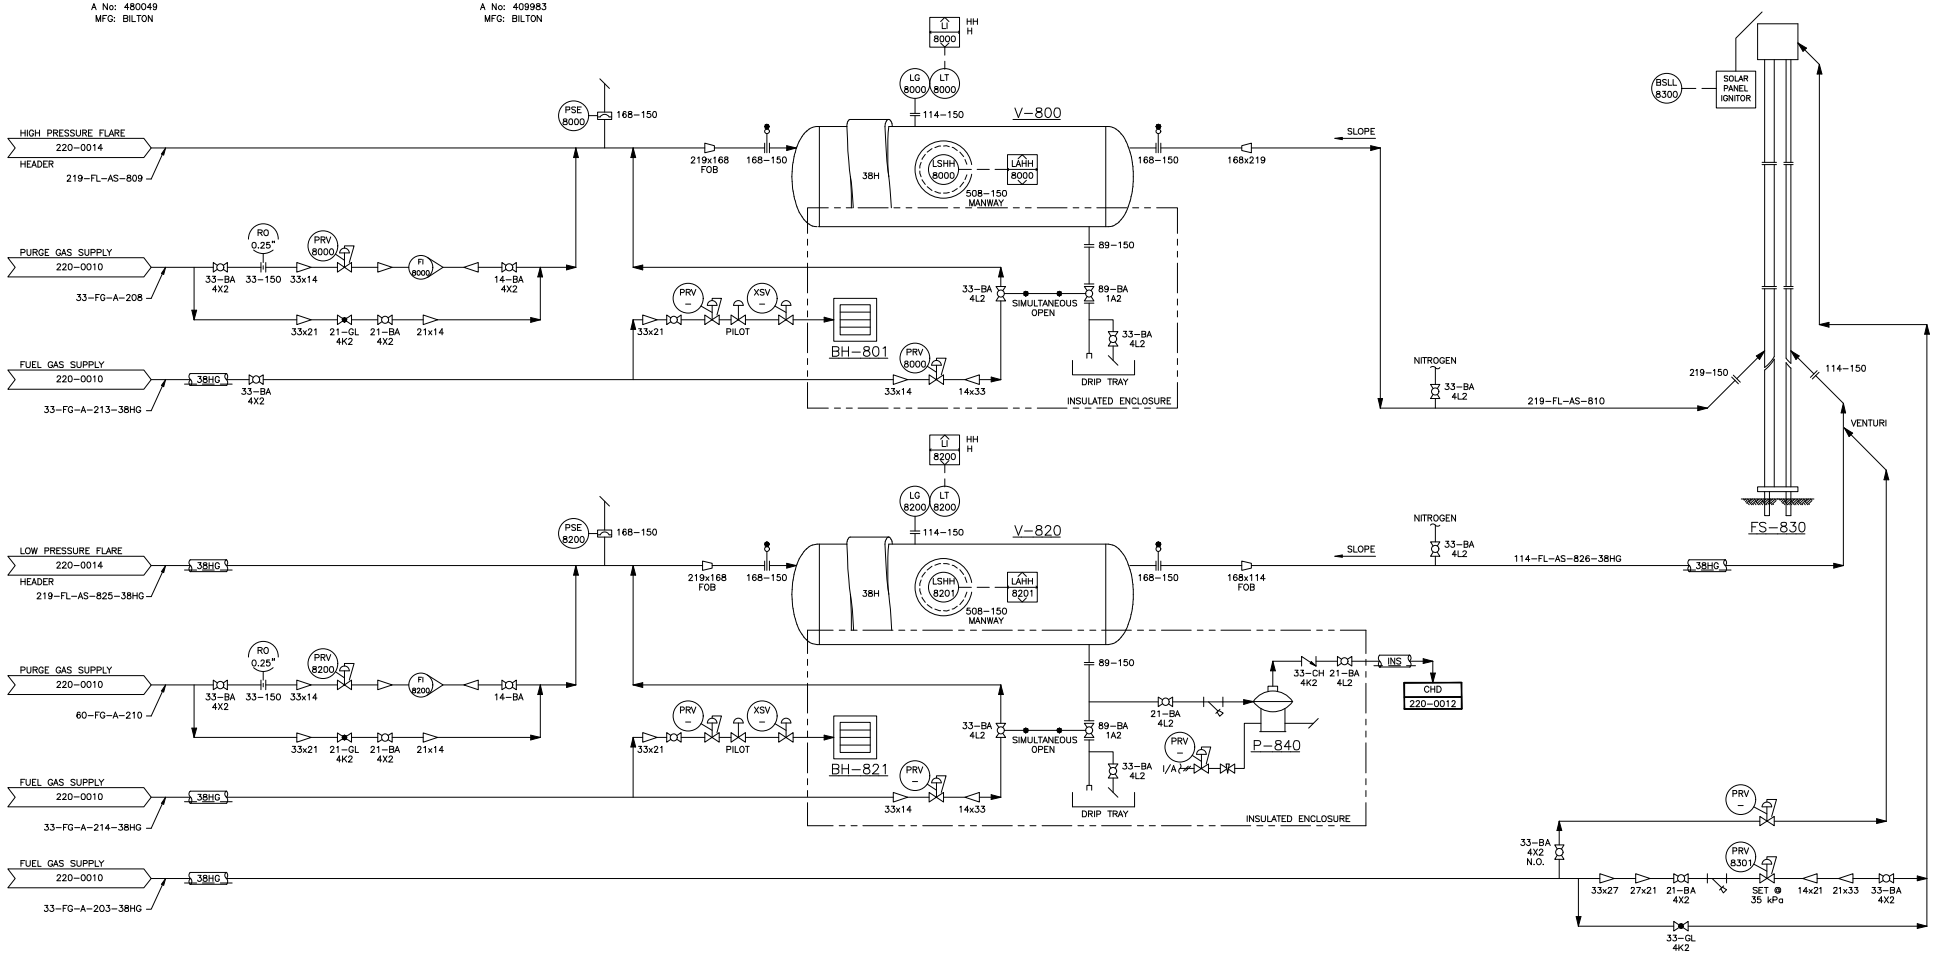

		2	CHANGE TO CNRL TITLEBLOCK	LDP	07-02-15	–	–	–
		1	AS-BUILT, REDRAWN FROM GLE. ORIGINALS	KS	04-04-26	WRM	–	–
610-MF-01 TO 17	MECHANICAL FLOW DIAGRAM (GLE. PIPING PLANS)	0	ISSUED FOR CONSTRUCTION – GLE. ENG.	CL	03-11-20	DHM	–	–
DRAWING NO.	REFERENCE DRAWINGS	REV.	DESCRIPTION	BY	DATE	CHK	APP.	CLIENT

DRAWN BY: LIANA DELPINTO	DATE 07-02-15	Canadian Natural	
DESIGNED BY: –	DATE –		
CHECKED BY: –	DATE –	TITLE a-17-J, 94-B-9 KOBES (TOWNSEND) COMPRESSOR STATION – HIGH & LOW PRESSURE KNOCKOUTS & FLARE STACKS MECHANICAL FLOW DIAGRAM	
APPROVED BY: –	DATE –		
CLIENT BY: –	DATE –	SCALE NTS	JOB NO. –
		DRAWING NO. KOBa17J-220-0015	REV. 2

AREA