


13-20-96-9w6m
H₂O Tank.

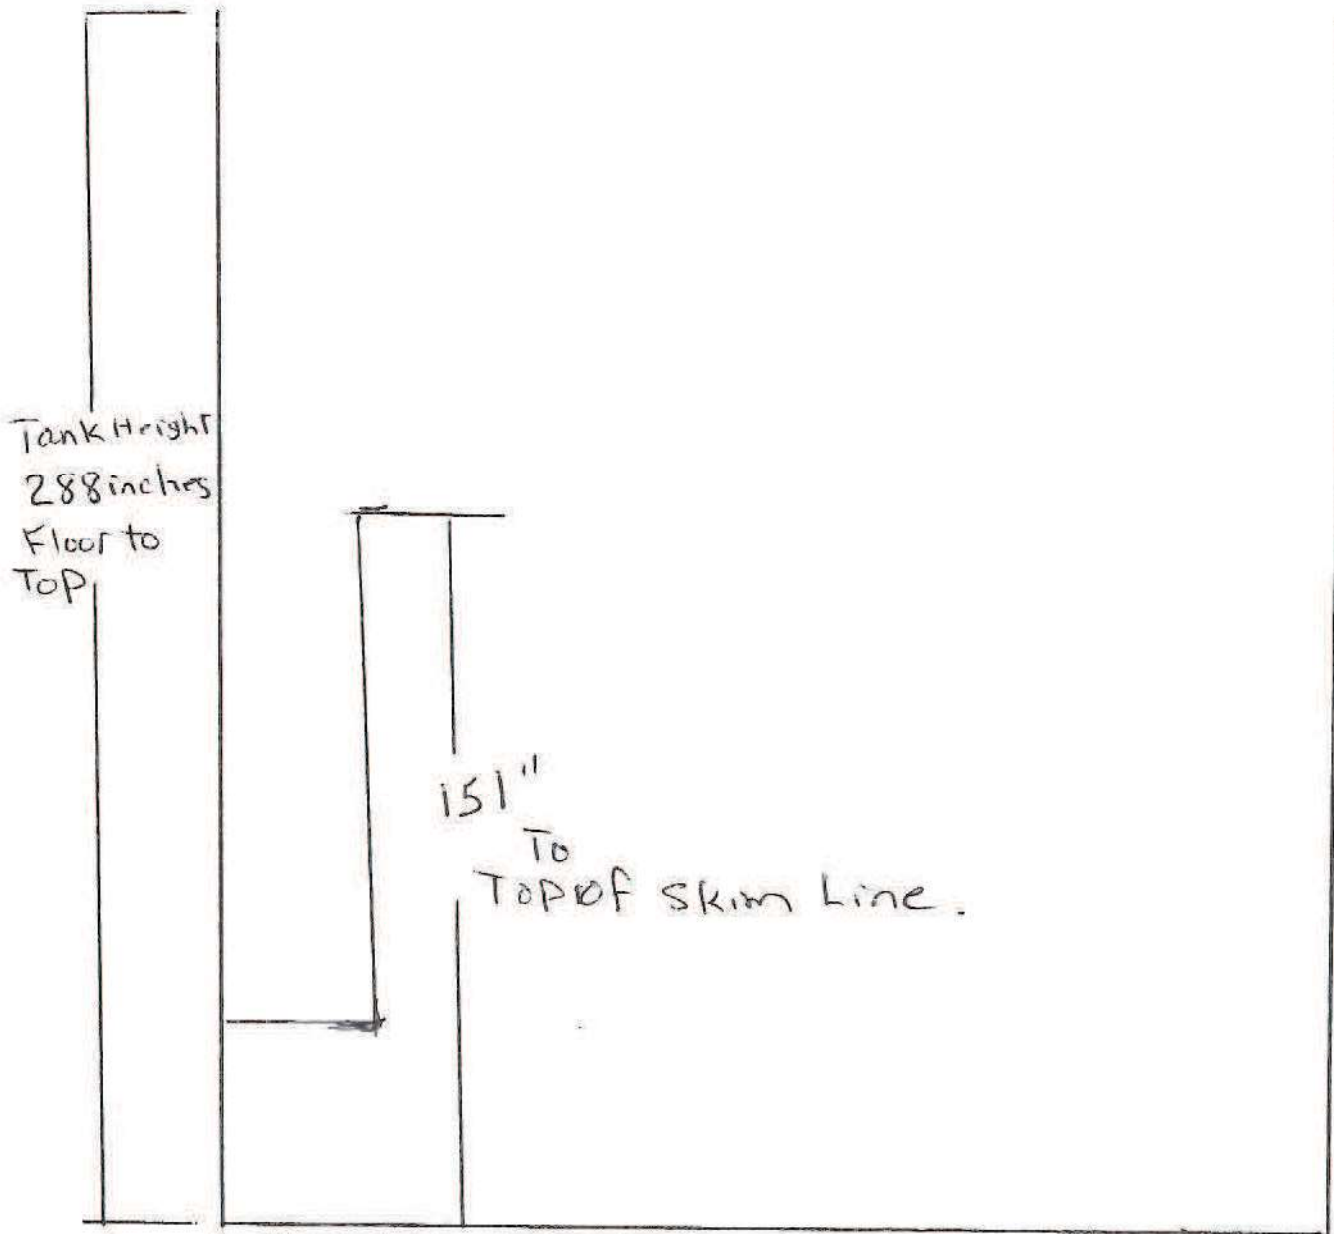

Total Tank Volume is 160m^3
Volume to top of SKIM LINE is 84m^3

13-20-96-9w6m
Water Tank.

Removed floating skimmer attachment from Skim
line as it wouldn't float in the Oil.