


PSV DATA

MFG: CROSBY
 MODEL: 972103MA
 SERIAL: SE25660-2
 SET PRESS: 9308 kPa
 CAPACITY: 5258scfm
 SERVICED BY: UNIFIED VALVE
 SERVICE DATE: 09/2005
 SIZE: 1" x 1.5"
 CODE STAMP: UV
 BLOCK VALVE: NO
 CRN: OG0201.20
 LOCATION: TOP HEAD
 TAG: G708222

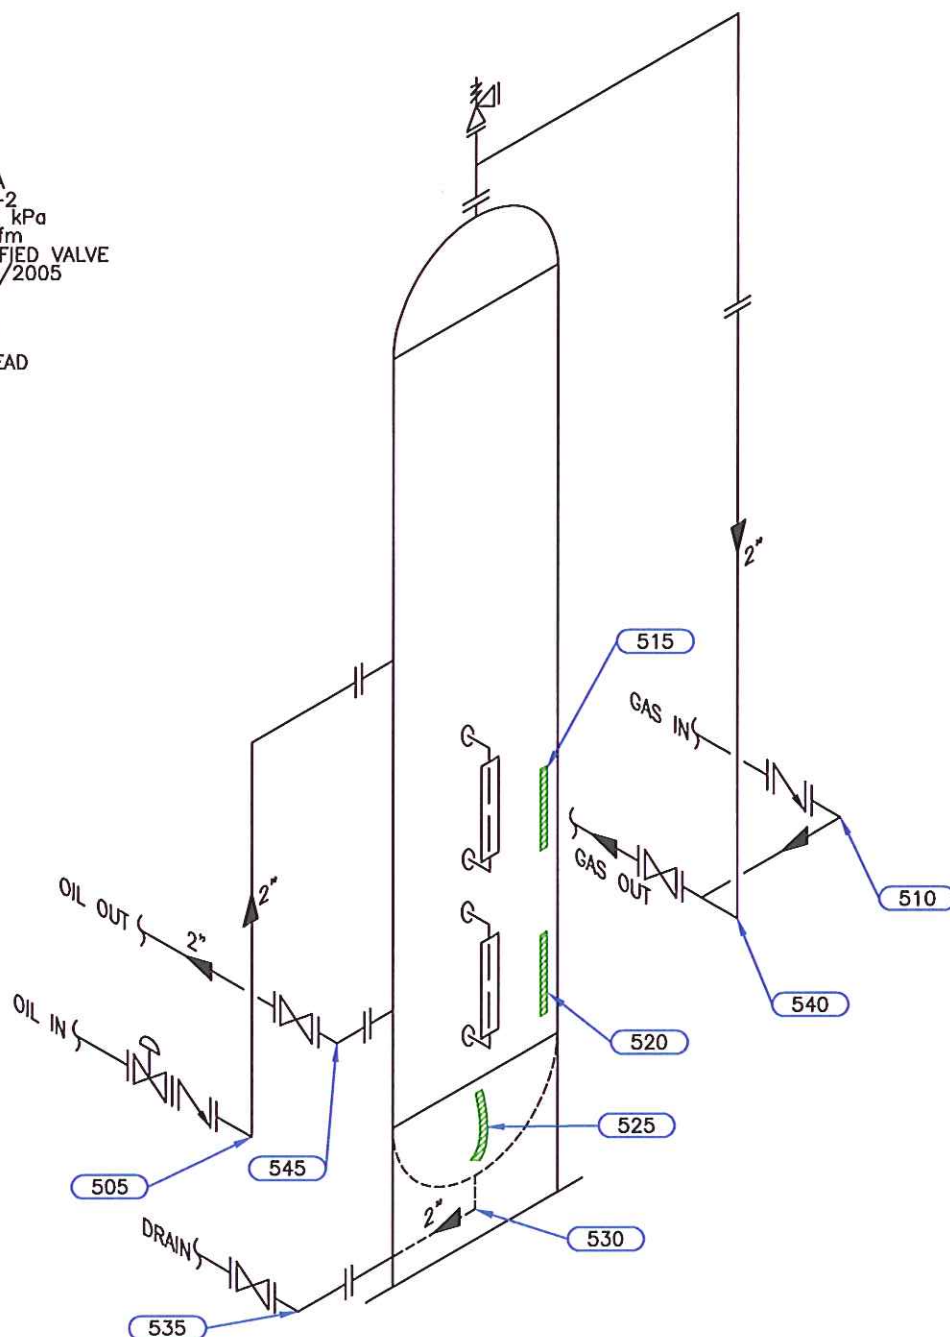

SKID # 16830

Equip. No. _____ Prov. Reg. No. 465108 C.R.N. P-3410.2 Serial No. VS-10369 Yr. Inst. _____
 Code/Div. ASME VIII, DIV 1 Size: 32in x 192in Manufacturer: LARSEN & D'AMICO Yr. Blt. 2001
 C. Stamp: YES Service: SWEET PWHT: NIL Radiography: RT-1 Insulated: NO

Design & Materials Data

HEAD:
 Top Mat'l. SA 516 70N Top Nom. 30.4mm Top C.A. 1.6mm
 Btm. Mat'l. _____ Btm. Nom. _____ Btm. C.A. _____
 CHANNEL:
 Material: _____ Nominal: _____ C.A. _____
 BOOT
 Head Mat'l. _____ Head Nom. _____ Head C.A. _____
 Shell Mat'l. _____ Shell Nom. _____ Shell C.A. _____
 SHELL
 Material: SA 516 70N Nominal: 31.8mm C.A. 1.6mm
 MAWP Shell Side: 9308 kPa @ Temp. 93°C
 MAWP Tube Side: _____ @ Temp. _____

CLIENT	CONOCOPHILLIPS CANADA		
FACILITY	HAMBURG 10-16 COMPRESSOR STATION LSD 10-16-97-10 W6M		
ITEM	BLOWCASE		
BY: CB	DATE: 01/03	DWG.# 5	

UTS DATA

CLIENT: CONOCOPHILLIPS CANADA
EQUIPMENT: BLOWCASE
CRN#: P-3410.2
PROV REG: A 465108
TESTED ON STREAM

FACILITY: HAMBURG COMPRESSOR STATION
SERVICE: SWEET
LOCATION: 10-16-97-10 W6M
RTD JOB #: 05.002110
REFER TO DRAWING: 5

[illegible]

FACILITY: HAMBURG COMPRESSOR STATION
SERVICE: SWEET
LOCATION: 10-16-97-10 W6M
RTD JOB #: 05.002110
REFER TO DRAWING: 5

Test Point	THICKNESS DATA						Flag	Crit	C.A.	Nom.	Short Term	Long Term	Ave. mm/yr	Flag Date
505														
Description: 2" 90° ELBOW														
	2003	1	2004	2	2008	7								
Min. Thick.	5.7		5.7		5.7		5.39		2.2	5.50	0	0	L	
Average:	6		6		6						0	0	L	
Analysis:														
510														
Description: 2" 90° ELBOW														
	2003	1	2004	2	2008	7								
Min. Thick.	5.4		5.4		5.4		5.39		2.2	5.50	0	0	L	
Average:	5.7		5.7		5.7						0	0	L	
Analysis:														
535														
Description: 2" 90° ELBOW														
	2003	1	2004	2	2008	7								
Min. Thick.	5.7		5.7		5.3		5.39		2.2	5.50	.09	.07	S	2008
Average:	6		6		5.6						.09	.07	S	2010
Analysis:														
540														
Description: 2" 90° ELBOW														
	2003	1	2004	2	2008	7								
Min. Thick.	5.5		5.4		5.4		5.39		2.2	5.50	0	.02	L	2009
Average:	5.7		5.7		5.7						0	0	L	
Analysis:														
545														
Description: 2" 90° ELBOW														
	2003	1	2004	2	2008	7								
Min. Thick.	5.2		5.2		5.2		5.39		2.2	5.50	0	0	L	2008
Average:	5.5		5.5		5.5						0	0	L	
Analysis:														