


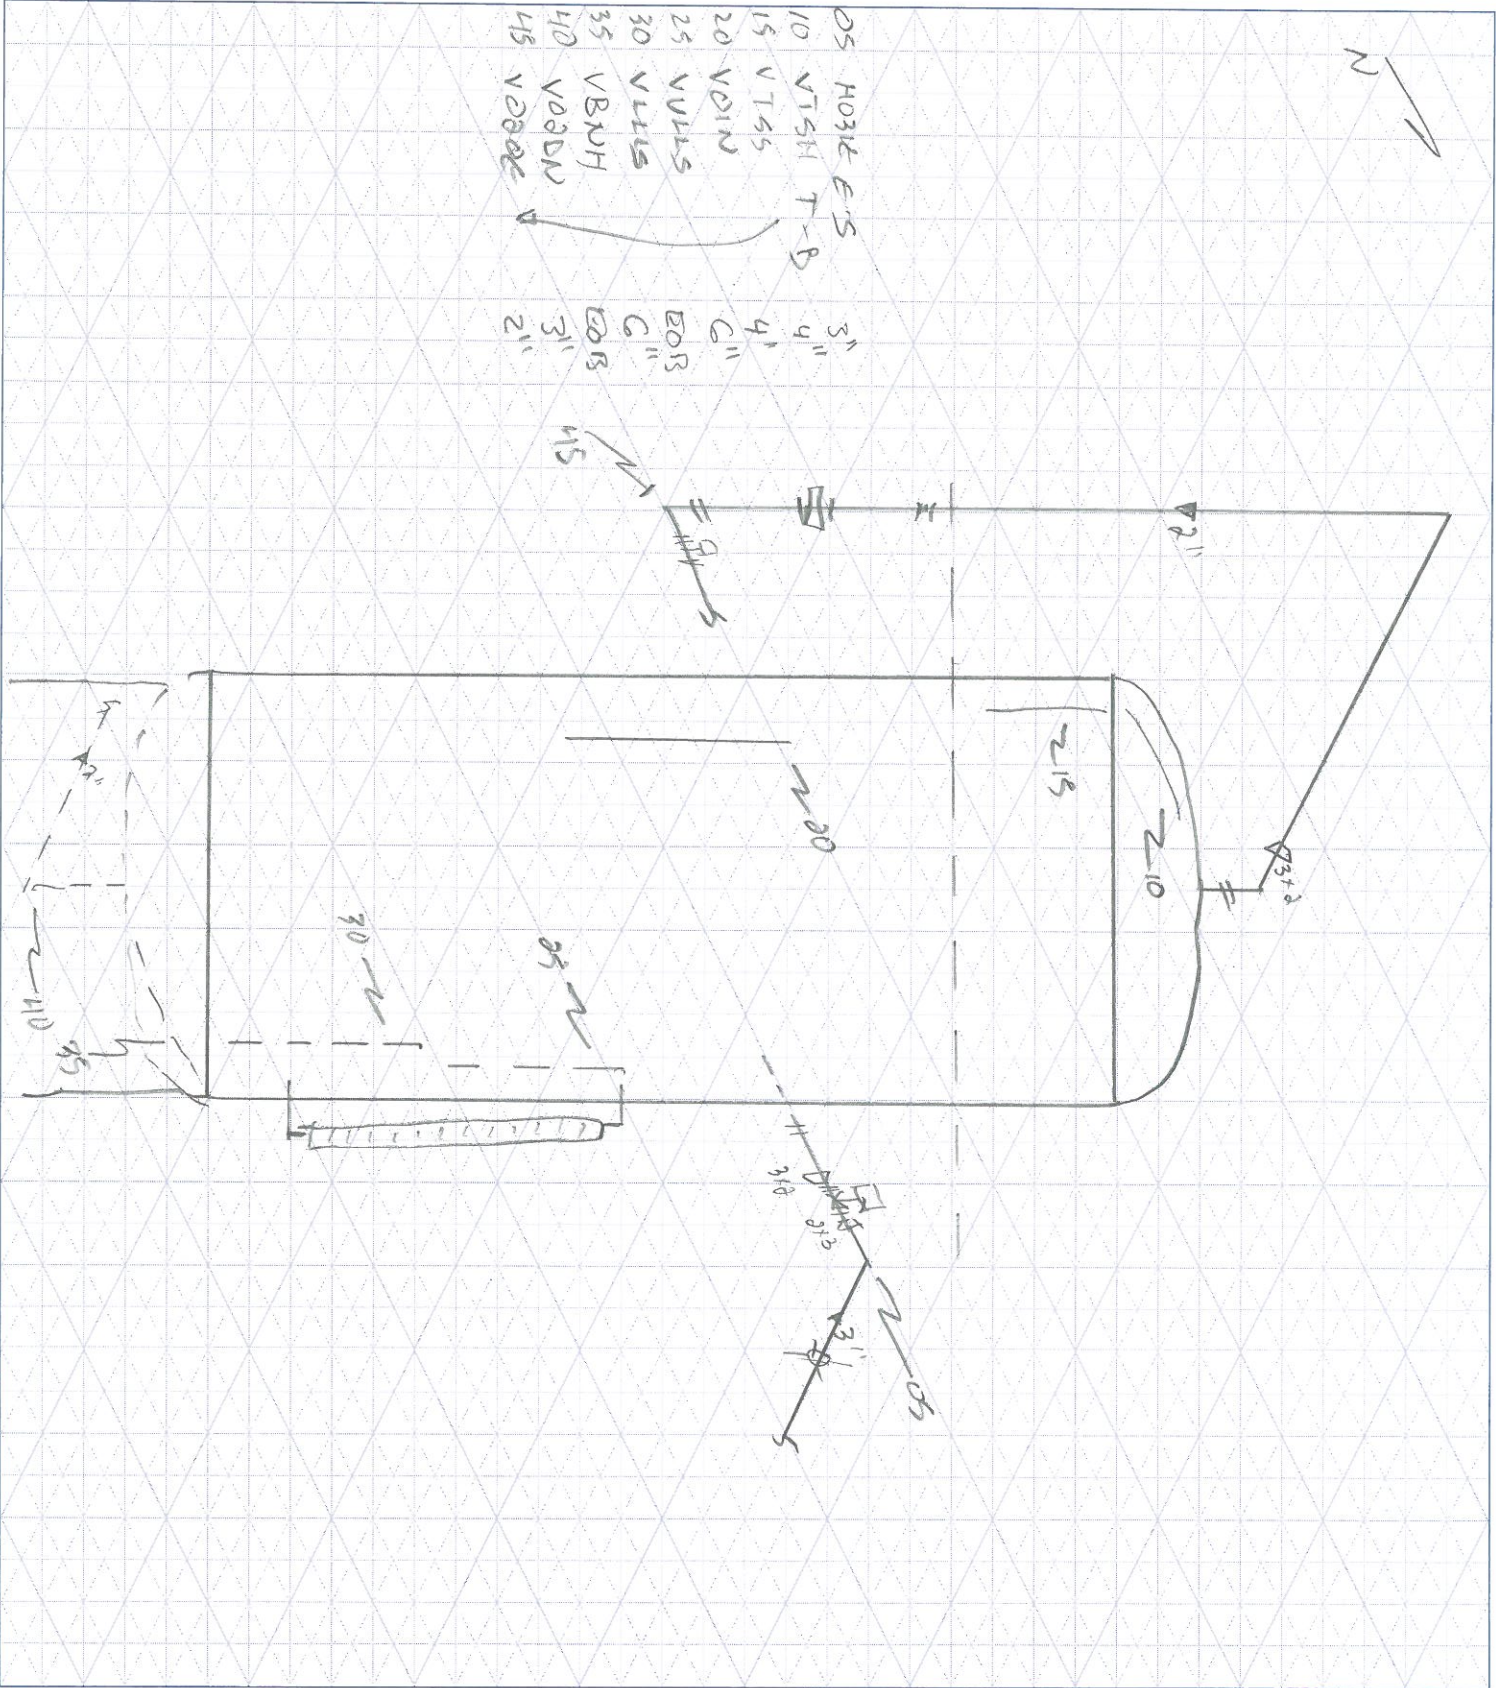

CUSTOMER: CNEL FACILITY: 12-09 Hobbema field LSD: 05-16-044-24w4m
P & ID: _____ DRAWN BY: KK DATE: 05-09-10 DRAWING NO. 156816-KK-20
VESSEL DESCRIPTION: Separator
Equip. No. _____ Pro.Reg.No. (A) AD441749 C.R.N. N0684.21 Serial No. V98309 Yr. Inst. _____
Code/Div. 0 w Size: 24" ID 100 X 8' Manufacturer: Chadco Yr. Blt. 1998
C. Stamp _____ Service: SWGT PWHT: _____ J.E.: _____ Radiography: RT-2 Insulated: NO
HEAD SHELL:
Top Mat'l _____ Top Nom. 1.065 Top C.A. .125 Material _____ Nominal 1.125 C.A. .125
Btm Mat'l _____ Btm Nom. 1.065 Btm C.A. .125 MDMT 1480 p91 @Temp 200F
BOOT CHANNEL:
Head Mat'l _____ Head Nom. _____ Head C.A. _____ Top Mat'l _____ Top Nom. _____ Top C.A. _____
Shell Mat'l _____ Shell Nom. _____ Shell C.A. _____ Btm Mat'l _____ Btm Nom. _____ Btm C.A. _____
MAWP Shell side: 1480 p91 @ Temp. 100 OF MAWP Tube side: _____ @ Temp. _____
PIPING INFORMATION:
Circuit. No. _____ Line No. (s) (PLEASE PUT LINE NUMBERS ON APPLICABLE LINES ON THE DRAWING)
Piping Class _____ Service: _____ Yr. Blt. _____
MAWP: _____ @ Temp. _____ Size & Schedule of Piping (PLEASE PUT APPROPRIATE SIZES AND SCHEDULES OF PIPING ON DRAWING)

A0441749

Readings in inches

	PNT1	PNT2	PNT3
LOC5	0.309	0.297	0.280
LOC10	1.108	1.210	1.104
LOC15	1.113	1.133	1.113
LOC20	1.137	1.137	1.135
LOC25	1.132	1.128	1.128
LOC30	1.130	1.116	1.098
LOC35	1.202	1.081	1.081
LOC40	0.441	0.439	0.435
LOC45	0.204	0.193	0.191