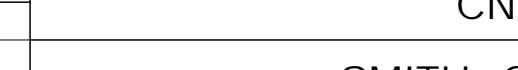


A triangle with the letter B inside it.

| | | | | | | | | | | | | | | | | |
|---|------------|---|------|-----|-----|-----|-------------------|---------------|---|---|--------------------|--------------|-----------|------------------------|----------------|-----|
| THIS DRAWING IS COPYRIGHT AND IS THE PROPERTY OF PTW ENERGY SERVICES LTD. IT MAY NOT BE COPIED, REPRODUCED OR USED IN WHOLE OR IN PART IN ANY WAY WITHOUT WRITTEN PERMISSION OF PTW ENERGY SERVICES. USE OF THIS DRAWING IS PERMITTED ONLY FOR THE SPECIFIC PURPOSE FOR WHICH IT WAS PREPARED. ANY REVISIONS MUST BE SET FORTH SEPARATELY UPON REQUEST. | | | | | | | | | | | | | | | | |
| NO. | DATE | REVISION | DRWN | CHK | ENG | APR | ENGINEERING STAMP | CLIENT/VENDOR | GENERAL NOTES | www.ptwenergy.com | ENGINEERING RECORD | | | | CNRL BUILDING | |
| A | 2023/03/15 | ISSUED FOR APPROVAL | DS | BK | KW | | | | 1. "POST CONSTRUCTION DRAWINGS" ARE GENERATED FROM CONSTRUCTION CHANGE INFORMATION FORWARDED TO PTW ENERGY SERVICES LTD BY THE OWNER'S FIELD SUPERVISORS AND OR 1800 CONTRACTORS. ANY CHANGES NOT DOCUMENTED WILL NOT APPEAR ON THE DRAWINGS AND THEREFORE THE DRAWING MAY NOT BE AN ACCURATE REPRESENTATION OF THE CONSTRUCTED FACILITY. |  | DRAWN | DS | MAR 14/23 | SMITH OIL VRU BUILDING | | |
| B | 2023/03/21 | ISSUED FOR APPROVAL - REVISED PER COMMENTS CLOUDED AS SHOWN | MM | TT | KW | | | | 2. PRIOR TO THE COMMENCEMENT OF ANY CONSTRUCTION AND OR EXCAVATION IT SHALL BE THE RESPONSIBILITY OF THE OWNER REPRESENTATIVE TO VERIFY THE LOCATION AND STRIKES, ANY PIPING, ELECTRICAL, EQUIPMENT OR BUILDINGS. | | CHECKED | BHA | | PLATE LAYOUT | | |
| | | | | | | | | | 3. ANY REVISIONS MADE TO EXISTING EQUIPMENT, ELECTRICAL OR INSTRUMENTATION ON A FACILITY NOT DESIGNED BY PTW ENERGY SERVICES LTD IS ONLY SHOWN AS A REPRESENTATION OF WHAT EXISTS AND MUST BE VERIFIED BY THE OWNER. | | DESIGNED | KW | MAR 13/23 | SCALE | DRAWING NUMBER | REV |
| | | | | | | | | | | | NONE | S002 | B | | | |
| | | | | | | | | | | | | CONTRACT No. | | | | |
| | | | | | | | | | | | PROJECT No. | W44129 | | | | |