

DRWN CHK ENG APR

DS BK KW

MM TT KW


ENGINEERING STAMP


NO. DATE

A 2023/03/15 ISSUED FOR APPROVAL

REVISION

B 2023/03/21 ISSUED FOR APPROVAL - REVISED PER COMMENTS CLOUDED AS SHOWN

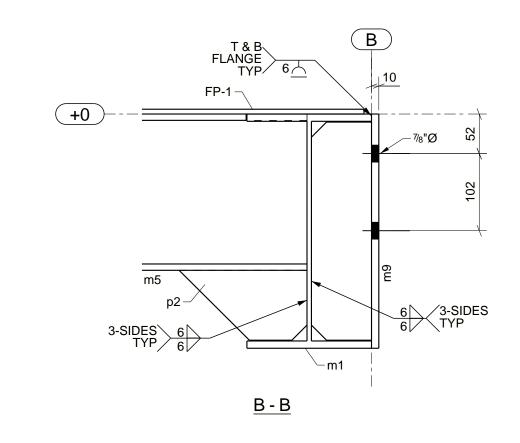

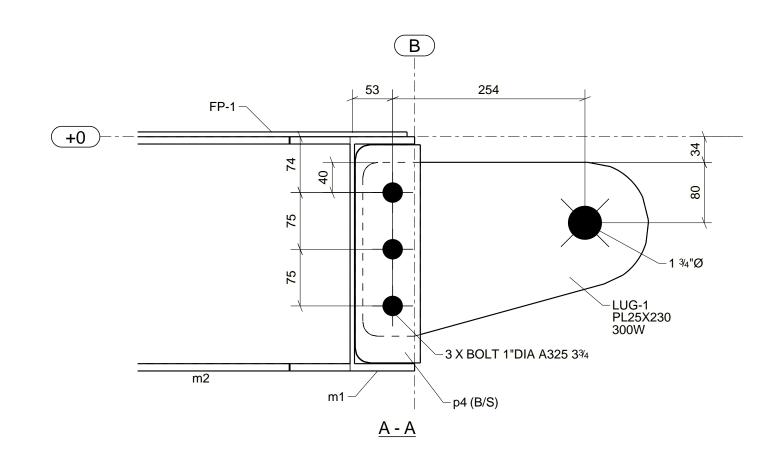

ONE REQ'D ~ S004

LUG-1	1	1	PL25X230	378	31	31	300W		
LUG-1	<u> </u>	- '							
m1	2	2	W310X39 (W12X26)	4000	676	676	350W		
m2	3	3	W310X39 (W12X26)	3830	945	945	350W		
m3	11	11	C150X12 (C6X8.2)	1912	525	525	300W		
m4	1	1	W200X27 (W8X18)	1912	108	108	350W		
m5	2	2	W200X27 (W8X18)	482	48	48	350W		
m9	2	2	W310X39 (W12X26)	310	22	22	350W		
p2	2	2	PL6X92	169	2	2	300W		
p4	8	8	PL13X86	289	44	44	300W		
FP-1	1	1		3980	1741	1741	A36		SUB-ASSEMBLY
LUG-1	3	3		230	92	92	300W		SUB-ASSEMBLY
MARK	PER	TOTAL	DESCRIPTION	LENGTH	LBS.PER	LBS.TOTAL	GRADE	HEAT NO.	REMARK

GENERAL NOTES

1. "POST CONSTRUCTION DRAWINGS" ARE GENERATED FROM
CONSTRUCTION CHANGE INFORMATION FORWARDED TO PTW
ENERGY SERVICES LTD. BY THE OWNER'S FIELD SUPERVISORS
AND OR HIRED CONTRACTORS. ANY CHANGES NOT
DOCUMENTED WILL NOT APPEAR ON THE DRAWINGS AND
THEREFORE THE DRAWING MAY NOT BE AN ACCURATE
REPRESENTATION OF THE CONSTRUCTED FACILITY.

1. PRIOR TO THE COMMENCEMENT OF ANY CONSTRUCTION AND
OR EXCAVATION IT SHALL BE THE RESPONSIBILITY OF THE
OWNERS REPRESENTATIVE TO VERIFY THE LOCATION AND
STATUS OF ANY PIPING, ELECTRICAL, EQUIPMENT OR
BUILDINGS.

3. ANY REVISIONS MADE TO EXISTING EQUIPMENT, ELECTRICAL
OR INSTRUMENTATION ON A FACILITY NOT DESIGNED BY
THE WENERGY SERVICES LTD. IS ONLY SHOWN AS A
REPRESENTATION OF WHAT EXISTS AND MUST BE VERIFIED BY
THE OWNER.

CLIENT/VENDOR

www.ptwenergy.com
PTW
STRUCTURAL SOLUTIONS

	LUG-1	3	3				230	92	92	300W		SUB-ASSEMBI	LY	
	MARK	PER	TOTAL	DESCRIP	PTION		LENGTH	LBS.PER	LBS.TOTAL	GRADE	HEAT NO.	REMARK		
					/ ENERGY SERVICES LTD. IT MAY NOT E CES AND IT MUST BE RETURNED IMMED		N WHOLE OR IN PART IN	ANY WAY WI	THOUT WRITTE	EN PERMISSION	OF PTW ENERGY SERVICES. USE OF THIS DRAWING	IS PERMITTED ONLY FOR THE SPI	ECIFIC	
	E	ENGI	NEEF	RING RE	CORD	CNDL DUILDING								
				BY	DATE	CNRL BUILDING								
	DRAWN CHECKED			DS	MAR 14/23		SMITH OIL VRU BUILDING							
				BHA										
	DESIG	DESIGNED KW MAR 13/23												
REVIEWED					SKID									
						SCALE				DF	RAWING NUMBER		RE	
	CONTRACT No.					NONE				5004				
PROJECT No.			W44129 NON		NONE					S004				