THIS DRAWING IS THE EXCLUSIVE PROPERTY OF PRESSON ENERFLEX AND MAY NOT BE COPIED OR COMMUNICATED TO A THIRD PARTY WITHOUT THE WRITTEN AUTHORIZATION OF PRESSON ENERFLEX.

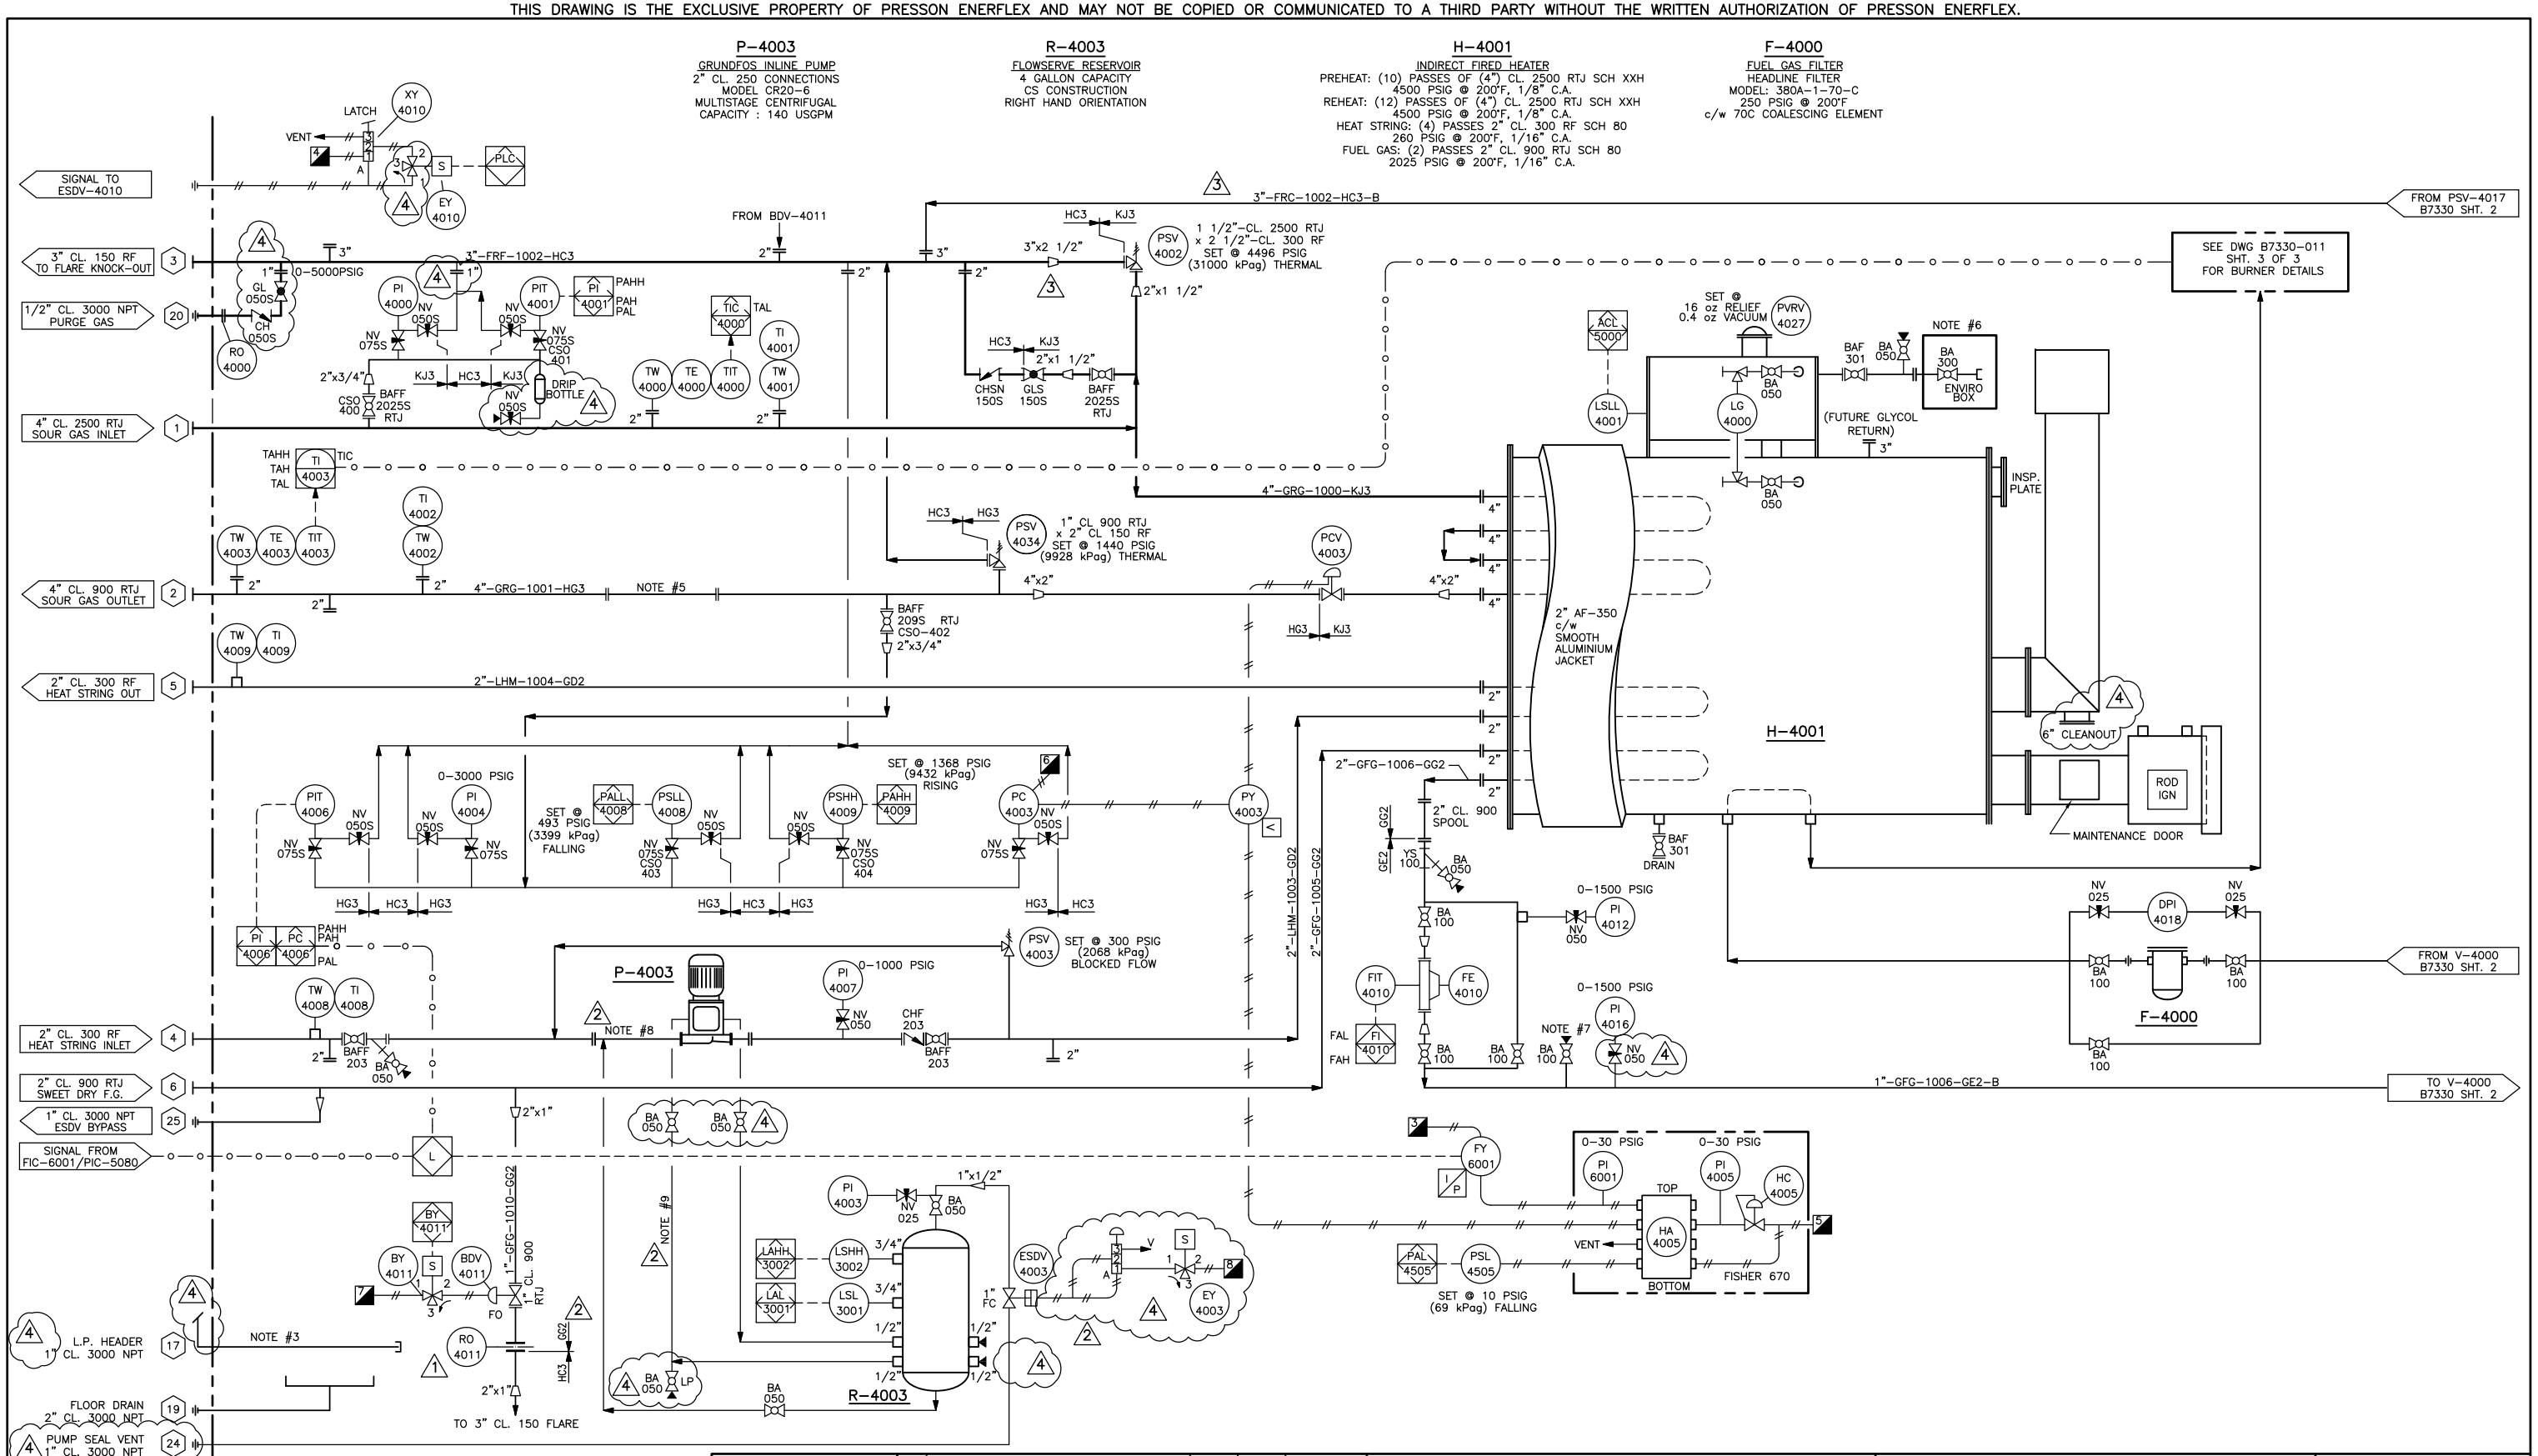

NOTES:

1) COLD FILL LINE TO BE MARKED ON LINE HEATER
2) ALL TUBING TO BE 316 SS c/w 316 SS SWAGELOK TUBE FITTINGS.
3) ALL LOW PRESSURE VENTING INSTRUMENTS TO BE VENTED ON A COMMON LP VENT HEADER AT EAVE HEIGHT.
4) NO SOCKET WELD OR THREADED FLANGES IN SOUR SERVICE.
5) SPOOL PIECE FOR FUTURE METER RUN.
6) 3" VALVE AND CAMLOCK ARE INCLUDED WITH THE ENVIROBOX.
7) HIGH PRESSURE SWEET GAS PURGE.
8) MAIN GLYCOL CIRCULATION THROUGH PUMP PRIMARY SEALS.
9) GLYCOL CIRCULATION THROUGH PUMP SECONDARY SEALS. 2
10) ELECTRICAL NOT IN PRESSON SCOPE OF WORK.

bp

NO.	REVISION	BY	CHKD.	DATE
4	AS BUILT	RWM		07/04/04
3	CHANGED PSV-4002 SIZE, AND ADDED REDUCER	AB		07/03/01
2	REVISED AS SHOWN	AEB		07/02/26
1	ADDED RO-4011	AEB		07/01/16
0	ISSUED FOR CONSTRUCTION	EB		06/11/22
B	RE-ISSUED FOR APPROVAL	AEB		06/10/18
A	ISSUED FOR APPROVAL	SM		06/08/25

CUSTOMER REFERENCE: 119-22-00

Presson ENERFLEX

CUSTOMER: BP CANADA ENERGY COMPANY

JOB NO. B7330-01

PROJECT: TWO LAKES 3-3
LSD: 03-03-63-13 W6M

TITLE: SOUR LINE HEATER SKID PACKAGE
P & ID

DRAWN	CHECKED	APPROVED	SCALE	DATE	DRAWING NUMBER
AEB			NTS	06/08/08	B7330-011 SHT. 1 OF 3 4