


PSV DATA

MFG: FARRIS
 MODEL: 266A13-120/SP
 SERIAL: CE-44982-A10
 SET PRES: 10066 kPa
 CAPACITY: 14220 scfm
 SERVICED BY: N/S
 SERVICE DATE: 08/21/2005
 SIZE: 1.5in x 2.5in
 CODE STAMP: UV/NB
 LOCK VALVE: NO
 SRN: OG2369.5C
 LOCATION: MID SHELL
 TAG: 1686F

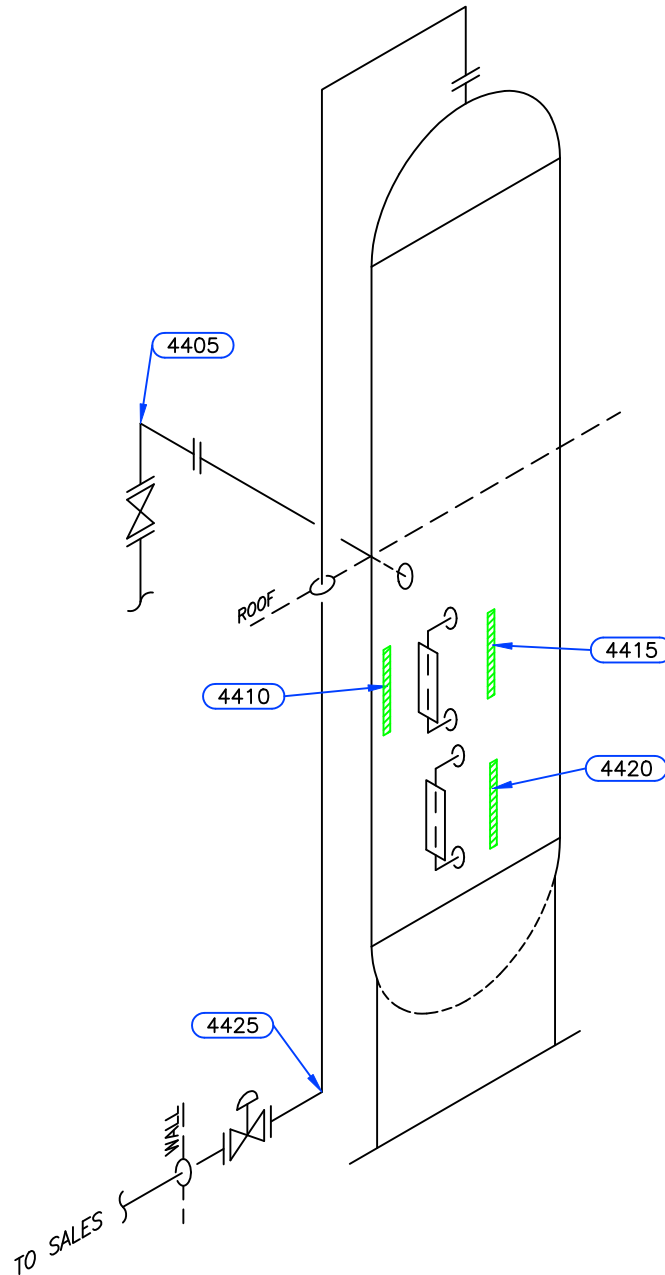

Equip. No. _____ Prov. Reg. No. Ⓐ 443773 C.R.N. L-4302.2 Serial No. 98C-60761 Yr. Inst. _____
 Code/Div. ASME VIII, Div 1 Size: 30in x 28ft Manufacturer: ALCO GAS & OIL Yr. Bld. 1999
 C. Stamp: U Service: SWEET PWHT: HT Radiography: RT-1 Insulated: NO

Design & Materials Data

HEAD:
 Top Mat'l. SA 516 70N Top Nom. 37.5mm Top C.A. 3.2mm
 Btm. Mat'l. _____ Btm. Nom. _____ Btm. C.A. _____
 CHANNEL:
 Material: _____ Nominal: _____ C.A. _____
 BOOT
 Head Mat'l. _____ Head Nom. _____ Head C.A. _____
 Shell Mat'l. _____ Shell Nom. _____ Shell C.A. _____
 SHELL
 Material: SA 516 70N Nominal: 38.1mm C.A. 3.2mm
 MAWP Shell Side: 10204 kPa @ Temp. 38°C
 MAWP Tube Side: _____ @ Temp. _____

CLIENT	CANADIAN NATURAL RESOURCES		
FACILITY	SADDLE HILLS GAS PLANT LSD 10-11-75-07 W6M		
ITEM	GLYCOL CONTACTOR		
BY: MH	DATE: 05/2010	DWG.# 44	

UTS DATA

CLIENT: CANADIAN NATURAL RESOURCES LTD
EQUIPMENT: GLYCOL CONTACTOR
CRN#: L-4302.2
PROV REG: A 443773
TESTED ON STREAM

FACILITY: SADDLE HILLS GAS PLANT
SERVICE: SWEET
LOCATION: 10-11-75-07 W6M
RTD JOB #:105.00157
REFER TO DRAWING: 44

Test Point	THICKNESS DATA													
4410														
Description:	LOWER SHELL													
	2010	5												
Min. Thick.	38.8						34.9		3.2	38.1			L	
Average:	38.9										0	0	L	
Analysis:														
4415														
Description:	LOWER SHELL													
	2010	5												
Min. Thick.	39						34.9		3.2	38.1			L	
Average:	39.1										0	0	L	
Analysis:														
4420														
Description:	LOWER SHELL													
	2010	5												
Min. Thick.	39						34.9		3.2	38.1			L	
Average:	39.1										0	0	L	
Analysis:														

UTS DATA

CLIENT: CANADIAN NATURAL RESOURCES LTD
EQUIPMENT: GLYCOL CONTACTOR PIPING
CRN#:
PROV REG:
TESTED ON STREAM

FACILITY: SADDLE HILLS GAS PLANT
SERVICE: SWEET
LOCATION: 10-11-75-07 W6M
RTD JOB #:105.00157
REFER TO DRAWING: 44

Test Point	THICKNESS DATA				Flag	Crit	C.A.	Nom.	Short Term	Long Term	Ave. mm/py	Flag Date
4405												
Description:	6" 90° ELBOW											
	2010	5										
Min. Thick.	12.5			9.63		1.4	11					L
Average:	12.9								0	0		L
Analysis:												
4425												
Description:	6" 90° ELBOW											
	2010	5										
Min. Thick.	10.6			9.63		1.4	11					L
Average:	10.8								0	0		L
Analysis:												