

CML Isometric Drawing

LSD 06-17-025-20W4M

Jur #

Serial # 19606B-1

Date

5/29/2019

FACILITY

WINTERING HILLS WEST 06-17

FIELD



DRUMHELLER

Phone:403-793-7697

8 Sarah King Crt E Brooks, Alberta, T1R 0J8
grady.rustebakke@gmail.com

GRADY
INSPECTION LTD

DWG 1

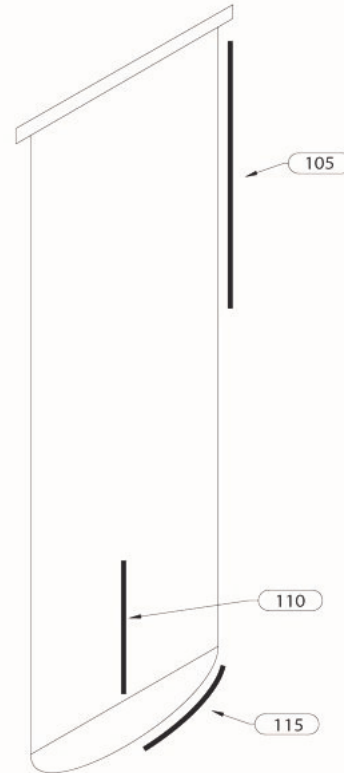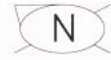

CML Isometric Drawing