


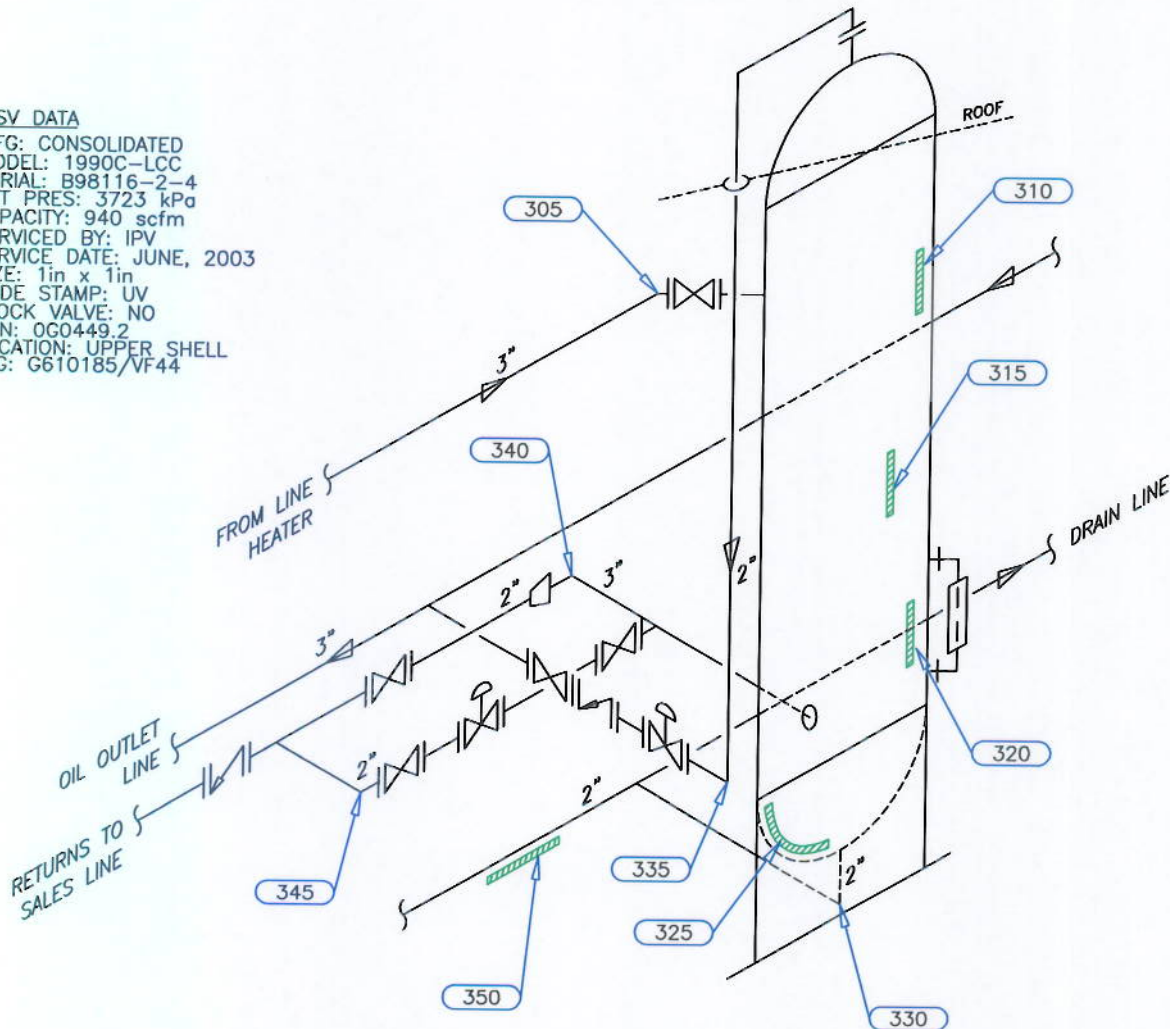

PSV DATA

MFG: CONSOLIDATED
 MODEL: 1990C-LCC
 SERIAL: B98116-2-4
 SET PRES: 3723 kPa
 CAPACITY: 940 scfm
 SERVICED BY: IPV
 SERVICE DATE: JUNE, 2003
 SIZE: 1in x 1in
 CODE STAMP: UV
 BLOCK VALVE: NO
 CRN: OG0449.2
 LOCATION: UPPER SHELL
 TAG: G610185/VF44



Equip. No. _____ Prov. Reg. No. **A 2846495** C.R.N. **K-9594.2** Serial No. **F-1622** Yr. Inst. _____
 Code/Div. **ASME VIII, DIV 1** Size: **30in x 89in** Manufacturer: **FLO-SKID MANUFACTURING** Yr. Blt. **1993**
 C. Stamp: **U** Service: **SWEET** PWHT: **NO** Radiography: **RT-2** Insulated: **NO**

Design & Materials Data

HEAD:
 Mat'l. **SA 516 70N** Nom. **20.3mm** C.A. **1.6mm**
 Mat'l. **SA 516 70N** Nom. **20.4mm** C.A. **1.6mm**
 CHANNEL:
 Material: _____ Nominal: _____ C.A. _____
 BOOT
 Head Mat'l. _____ Head Nom. _____ Head C.A. _____
 Shell Mat'l. _____ Shell Nom. _____ Shell C.A. _____
 SHELL
 Material: **SA 516 70N** Nominal: **19.1mm** C.A. **1.6mm**
 MAWP Shell Side: **5171 kPa** @ Temp. **38°C**
 MAWP Tube Side: _____ @ Temp. _____

CLIENT	CONOCOPHILLIPS CANADA		
FACILITY	VALHALLA OIL & GAS GATHERING LSD 08-04-75-09 W6M		
ITEM	GROUP SEPARATOR		
BY: EG	DATE: 00/09	DWG.# 15	

CLIENT: CONOCOPHILLIPS CANADA
EQUIPMENT: GROUP SEPARATOR
EQUIPMENT ID#:
PROV REG: A 2846495
TESTED ON STREAM

FACILITY: VALHALLA GAS & OIL GATHERING
SERVICE: SWEET
LOCATION: 08-04-75-09 W6M
RTD JOB #: 05.003798
REFER TO DRAWING: 15

Test Point	THICKNESS DATA				Flag	Crit	C.A.	Nom.	Short Term	Long Term	Ave. mm/py
310											
Description:	SHELL OPPOSITE INLET										
	2000	7	2005	10							
Min. Thick.	19.2		19.2		17.50		1.6	19.10	0	0	L
Average:	19.5		19.5						0	0	L
Analysis:											
315											
Description:	UPPER SHELL										
	2000	7	2005	10							
Min. Thick.	19.2		19.2		17.50		1.6	19.10	0	0	L
Average:	19.4		19.4						0	0	L
Analysis:											
320											
Description:	SHELL @ L/L										
	2000	7	2005	10							
Min. Thick.	19.1		19.1		17.50		1.6	19.10	0	0	L
Average:	19.3		19.3						0	0	L
Analysis:											
325											
Description:	BOTTOM HEAD										
	2000	7	2005	10							
Min. Thick.	18.8		18.8		18.80		1.6	20.40	0	0	L
Average:	19.3		19.3						0	0	L
Analysis:	2005/10 MIN SCAN @ NOZZLE.										
330											
Description:	2" ROLLING NOZZLE										
	2000	7	2005	10							
Min. Thick.	8.2		8.2		6.10		2.6	8.70	0	0	L
Average:	8.5		8.5						0	0	L
Analysis:											

CLIENT: CONOCOPHILLIPS CANADA
EQUIPMENT: GROUP SEPARATOR PIPING
EQUIPMENT ID#:
PROV REG:
TESTED ON STREAM

FACILITY: VALHALLA GAS & OIL GATHERING
SERVICE: SWEET
LOCATION: 08-04-75-09 W6M
RTD JOB #: 05.003798
REFER TO DRAWING: 15

Test Point	THICKNESS DATA				Flag	Crit	C.A.	Nom.	Short Term	Long Term	Ave. mm/py
305											
Description: 3" 45° ELBOW											
	2000	7	2005	10							
Min. Thick.	5.3		5.3		3.30		2.2	5.50	0	0	L
Average:	5.6		5.6						0	0	L
Analysis:											
335											
Description: 2" 90° ELBOW											
	2000	7	2005	10							
Min. Thick.	3.9		3.9		1.90		2	3.90	0	0	L
Average:	4.1		4.1						0	0	L
Analysis:											
340											
Description: 3" 90° ELBOW											
	2000	7	2005	10							
Min. Thick.	4.8		4.8		3.30		2.2	5.50	0	0	L
Average:	5.1		5.1						0	0	L
Analysis:											
345											
Description: 2" 90° ELBOW											
	2000	7	2005	10							
Min. Thick.	4.1		3.9		1.90		2	3.90	.04	.04	L
Average:	4.2		4.3						0	0	L
Analysis: 2005/10-MIN SCAN AT DSW											
350											
Description: 2" BOTTOM BAND											
	2000	7	2005	10							
Min. Thick.	3.6		3.6		1.90		2	3.90	0	0	L
Average:	3.8		3.8						0	0	L
Analysis:											