


ITEM:

**SEPARATOR**

A 0438986

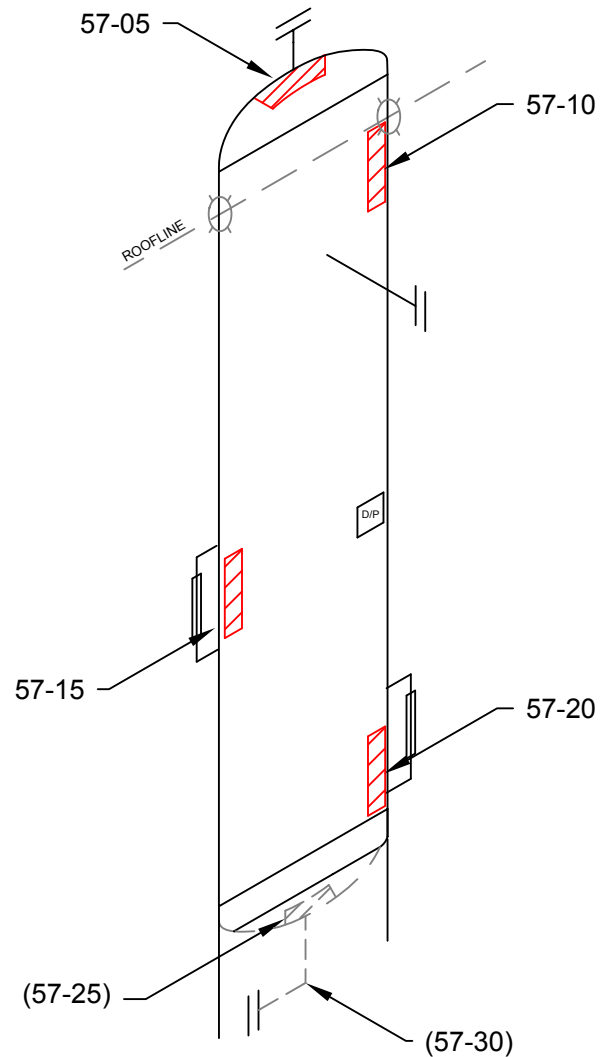

STETTLER, AB (403) 742-4868  
 LACOMBE, AB (403) 782-7855  
 BROOKS, AB (403) 501-8029  
 GRANDE PRAIRIE, AB (866) 422-9732

TECHNICIAN:

STEVE GILLINGHAM  
 SNT LEVEL II  
 CGSB 48.9712  
 LEVEL II # 11441

DATE: **01/28/11**DWG # **57**CLIENT: **CNRL**LSD: **08-31-073-09-W6M**

INSPECTOR : RAJ KHAN

LOCATION : VALHALLA

DISTRICT UNIT : WEST COUNTY

BLDG/SKID : SKD 0208

PROCESS : SOUR

CODE : ASME SEC VIII DIV 1

SPECIFICATION : AS PER ASME SE 797

TECHNIQUE : UT 1-1, REV .1

METHOD : UT CONTINUOUS / A SCAN

SURFACE COND : PAINTED

SURFACE TEMP : AMBIENT

**VESSEL INFORMATION**VESSEL # : **A 0438986**

CRN # : N0293.2

SERIAL # : V-2878A1

MANUFACTURER : OPSCO

DATE BUILT : 1998

CLIENT ID / TAG : -

M.A.W.P. : 1475 PSI

M.A.W.T. : 250 °F

JOINT EFFICIENCY/RT : RT 1

STRESS RELIEVED : YES

INSULATED : NO

MANWAY : NO

**VESSEL SPECIFICATIONS**


|                     | OD  | NOMINAL | MATERIAL  | CA    |
|---------------------|-----|---------|-----------|-------|
| <b>VESSEL HEAD</b>  | 24" | 1.074"  | SA-516-70 | .125" |
| <b>VESSEL SHELL</b> | 24" | 1.125"  | SA-516-70 | .125" |
| <b>BOOT HEAD</b>    | -   | -       | -         | -     |
| <b>BOOT SHELL</b>   | -   | -       | -         | -     |

COMMENTS:

PROJECT:

**C70099**

**A 0438986**

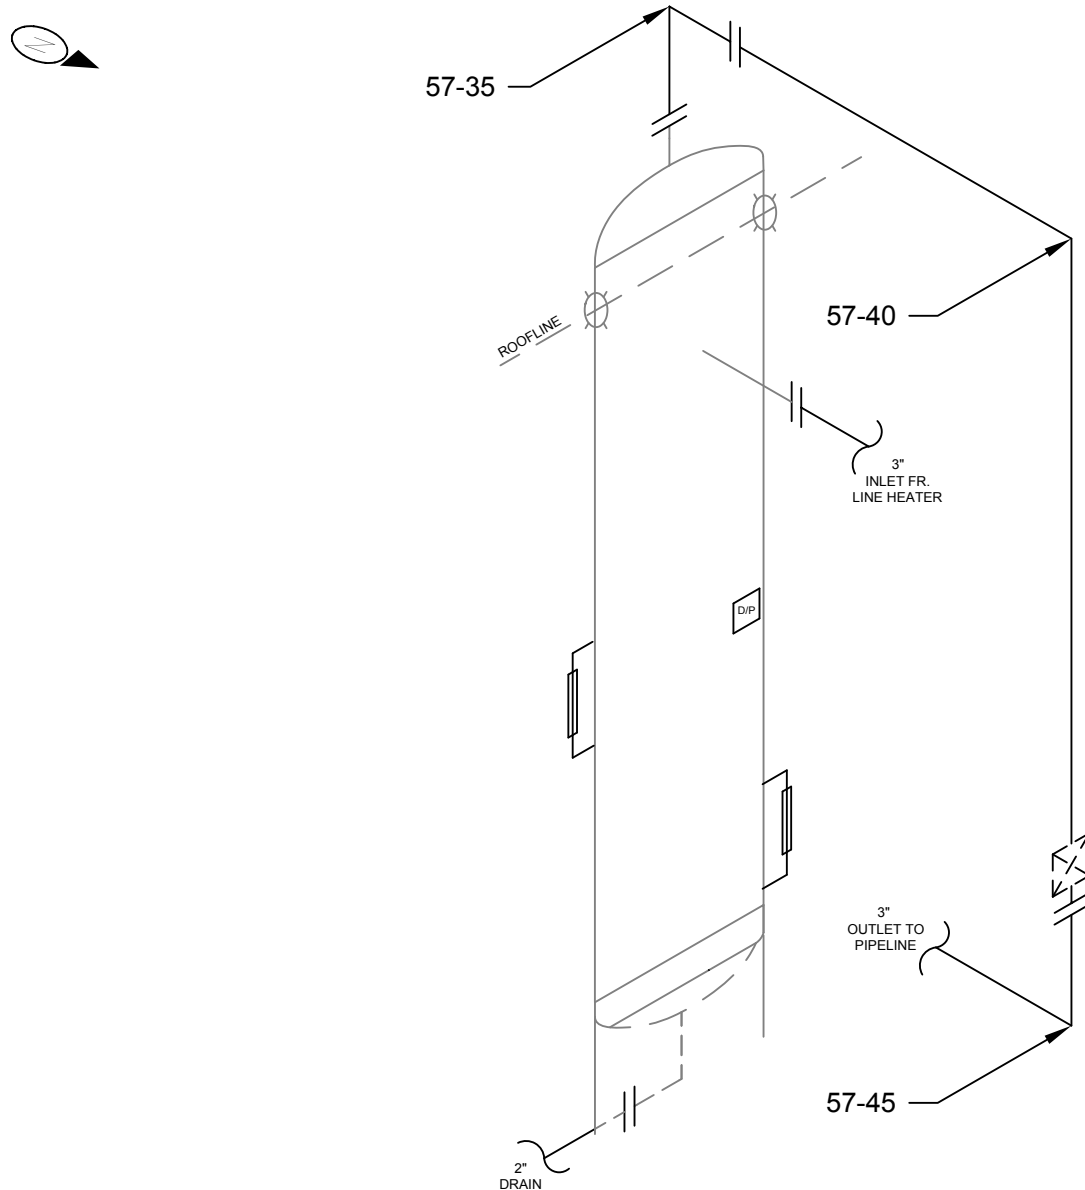



## ULTRASONIC CORROSION SURVEY

Survey Name: CNRL

LSD: 08-31-073-09W6 Dwg: 57 Vessel Number: A0438986 Manufacturer: OPSCO Survey Date: 1/29/11  
District Unit: WEST COUNTY Vessel Name: SEPARATOR Serial Number: V-2878A1 Inspector: RAJ KHAN  
Location: VALHALLA Year Built: 1998 Shell MAWP PSI: 1475 MAWT F: 250 Process: SOUR  
Skid: SKD0208 Tag Number: - Tube MAWP PSI: 0 MAWT F: 0 Project #: C70099  
CRN: N0293.2 Vessel CA: 0.1250

| Band     | Description |            |          | Readings |       |       |       |       |       | Year | Avg<br>Inches | Min<br>Inches | Nominal     | CA     | TMIN   | Recommended<br>Next Inspection | Recommended<br>Retirement<br>Date |
|----------|-------------|------------|----------|----------|-------|-------|-------|-------|-------|------|---------------|---------------|-------------|--------|--------|--------------------------------|-----------------------------------|
|          |             |            |          | 1        | 2     | 3     | 4     | 5     | 6     |      |               |               |             |        |        |                                |                                   |
| 57-05    | Top         | Head       | Baseline | 1.109    | 1.109 | 1.110 | 1.105 | 1.109 | 1.109 | 2006 | 1.109         | 1.105         | 1.0740      | 0.1250 | 0.8118 | 2012                           | 2031                              |
| Shape    | Ellipsoidal | Shell Side | Previous | 1.109    | 1.109 | 1.110 | 1.105 | 1.109 | 1.109 | 2006 | 1.109         | 1.105         | Comments--> |        |        |                                |                                   |
| OD       | 24          |            | Current  | 1.109    | 1.069 | 1.110 | 1.105 | 1.109 | 1.109 | 2011 | 1.102         | 1.069         |             |        |        |                                |                                   |
| Spec.    | VIII Div 1  |            |          |          |       |       |       |       |       |      | ST Loss MPY   | 0.007         | OK          |        |        |                                |                                   |
| Material | SA 516 - 70 |            |          |          |       |       |       |       |       |      | LT Loss MPY   | 0.007         |             |        |        |                                |                                   |
| 57-10    | Upper       | Shell      | Baseline | 1.128    | 1.133 | 1.135 | 1.136 | 1.136 | 1.138 | 2006 | 1.134         | 1.128         | 1.1250      | 0.1250 | 0.8392 | 2012                           | 2031                              |
| Shape    | Cylindrical | Shell Side | Previous | 1.128    | 1.133 | 1.135 | 1.136 | 1.136 | 1.138 | 2006 | 1.134         | 1.128         | Comments--> |        |        |                                |                                   |
| OD       | 24          |            | Current  | 1.128    | 1.133 | 1.135 | 1.136 | 1.136 | 1.138 | 2011 | 1.134         | 1.128         |             |        |        |                                |                                   |
| Spec.    | VIII Div 1  |            |          |          |       |       |       |       |       |      | ST Loss MPY   | 0.000         | OK          |        |        |                                |                                   |
| Material | SA 516 - 70 |            |          |          |       |       |       |       |       |      | LT Loss MPY   | 0.000         |             |        |        |                                |                                   |
| 57-15    | Mid         | Shell      | Baseline | 1.152    | 1.153 | 1.153 | 1.153 | 1.154 | 1.126 | 2006 | 1.149         | 1.126         | 1.1250      | 0.1250 | 0.8392 | 2012                           | 2031                              |
| Shape    | Cylindrical | Shell Side | Previous | 1.152    | 1.153 | 1.153 | 1.153 | 1.154 | 1.126 | 2006 | 1.149         | 1.126         | Comments--> |        |        |                                |                                   |
| OD       | 24          |            | Current  | 1.152    | 1.153 | 1.153 | 1.141 | 1.136 | 1.126 | 2011 | 1.144         | 1.126         |             |        |        |                                |                                   |
| Spec.    | VIII Div 1  |            |          |          |       |       |       |       |       |      | ST Loss MPY   | 0.000         | OK          |        |        |                                |                                   |
| Material | SA 516 - 70 |            |          |          |       |       |       |       |       |      | LT Loss MPY   | 0.000         |             |        |        |                                |                                   |
| 57-20    | Lower       | Shell      | Baseline | 1.154    | 1.153 | 1.159 | 1.156 | 1.156 | 1.153 | 2006 | 1.155         | 1.153         | 1.1250      | 0.1250 | 0.8392 | 2012                           | 2031                              |
| Shape    | Cylindrical | Shell Side | Previous | 1.154    | 1.153 | 1.159 | 1.156 | 1.156 | 1.153 | 2006 | 1.155         | 1.153         | Comments--> |        |        |                                |                                   |
| OD       | 24          |            | Current  | 1.154    | 1.153 | 1.159 | 1.156 | 1.156 | 1.153 | 2011 | 1.155         | 1.153         |             |        |        |                                |                                   |
| Spec.    | VIII Div 1  |            |          |          |       |       |       |       |       |      | ST Loss MPY   | 0.000         | OK          |        |        |                                |                                   |
| Material | SA 516 - 70 |            |          |          |       |       |       |       |       |      | LT Loss MPY   | 0.000         |             |        |        |                                |                                   |



## ULTRASONIC CORROSION SURVEY

Survey Name: CNRL

LSD: 08-31-073-09W6 Dwg: 57 Vessel Number: A0438986 Manufacturer: OPSCO Survey Date: 1/29/11  
District Unit: WEST COUNTY Vessel Name: SEPARATOR Serial Number: V-2878A1 Inspector: RAJ KHAN  
Location: VALHALLA Year Built: 1998 Shell MAWP PSI: 1475 MAWT F: 250 Process: SOUR  
Skid: SKD0208 Tag Number: - Tube MAWP PSI: 0 MAWT F: 0 Project #: C70099  
CRN: N0293.2 Vessel CA: 0.1250

| Band     | Description  |            |          | Readings |       |       |       |       |             | Year | Avg<br>Inches | Min<br>Inches | Nominal     | CA     | TMIN   | Recommended<br>Next Inspection | Recommended<br>Retirement<br>Date |
|----------|--------------|------------|----------|----------|-------|-------|-------|-------|-------------|------|---------------|---------------|-------------|--------|--------|--------------------------------|-----------------------------------|
|          |              |            |          | 1        | 2     | 3     | 4     | 5     | 6           |      |               |               |             |        |        |                                |                                   |
| 57-25    | Bottom       | Head       | Baseline | 1.105    | 1.107 | 1.106 | 1.086 | 1.092 | 1.089       | 2006 | 1.098         | 1.086         | 1.0740      | 0.1250 | 0.8118 | 2012                           | 2031                              |
| Shape    | Ellipsoidal  | Shell Side | Previous | 1.105    | 1.107 | 1.106 | 1.086 | 1.092 | 1.089       | 2006 | 1.098         | 1.086         | Comments--> |        |        |                                |                                   |
| OD       | 24           |            | Current  | 1.095    | 1.072 | 1.094 | 1.086 | 1.088 | 1.088       | 2011 | 1.087         | 1.072         |             |        |        |                                |                                   |
| Spec.    | VIII Div 1   |            |          |          |       |       |       |       | ST Loss MPY |      | 0.003         |               | OK          |        |        |                                |                                   |
| Material | SA 516 - 70  |            |          |          |       |       |       |       | LT Loss MPY |      | 0.003         |               |             |        |        |                                |                                   |
| 57-30    | Drain        | Nozzle     | Baseline | 0.294    | 0.294 | 0.291 | 0.287 | 0.294 | 0.294       | 2006 | 0.292         | 0.287         | 0.3430      | 0.1250 | 0.0768 | 2012                           | 2031                              |
| Shape    | 90° Elbow    | Shell Side | Previous | 0.294    | 0.294 | 0.291 | 0.287 | 0.294 | 0.294       | 2006 | 0.292         | 0.287         | Comments--> |        |        |                                |                                   |
| OD       | 2.375        |            | Current  | 0.293    | 0.290 | 0.285 | 0.275 | 0.281 | 0.280       | 2011 | 0.284         | 0.275         |             |        |        |                                |                                   |
| Spec.    | VIII Div 1   |            |          |          |       |       |       |       | ST Loss MPY |      | 0.002         |               | OK          |        |        |                                |                                   |
| Material | SA 234 - WPB |            |          |          |       |       |       |       | LT Loss MPY |      | 0.002         |               |             |        |        |                                |                                   |
| 57-35    |              | Piping     | Baseline | 0.290    | 0.293 | 0.291 | 0.290 | 0.291 | 0.295       | 2006 | 0.292         | 0.290         | 0.3000      | 0.0375 | 0.1245 | 2012                           | 2031                              |
| Shape    | 90° Elbow    | Shell Side | Previous | 0.290    | 0.293 | 0.291 | 0.290 | 0.291 | 0.295       | 2006 | 0.292         | 0.290         | Comments--> |        |        |                                |                                   |
| OD       | 3.5          |            | Current  | 0.284    | 0.278 | 0.270 | 0.282 | 0.276 | 0.293       | 2011 | 0.281         | 0.270         |             |        |        |                                |                                   |
| Spec.    | B31.3        |            |          |          |       |       |       |       | ST Loss MPY |      | 0.004         |               | OK          |        |        |                                |                                   |
| Material | A 234 - WPB  |            |          |          |       |       |       |       | LT Loss MPY |      | 0.004         |               |             |        |        |                                |                                   |
| 57-40    |              | Piping     | Baseline | 0.279    | 0.278 | 0.274 | 0.274 | 0.277 | 0.284       | 2006 | 0.278         | 0.274         | 0.3000      | 0.0375 | 0.1245 | 2012                           | 2031                              |
| Shape    | 90° Elbow    | Shell Side | Previous | 0.279    | 0.278 | 0.274 | 0.274 | 0.277 | 0.284       | 2006 | 0.278         | 0.274         | Comments--> |        |        |                                |                                   |
| OD       | 3.5          |            | Current  | 0.275    | 0.265 | 0.271 | 0.263 | 0.268 | 0.266       | 2011 | 0.268         | 0.263         |             |        |        |                                |                                   |
| Spec.    | B31.3        |            |          |          |       |       |       |       | ST Loss MPY |      | 0.002         |               | OK          |        |        |                                |                                   |
| Material | A 234 - WPB  |            |          |          |       |       |       |       | LT Loss MPY |      | 0.002         |               |             |        |        |                                |                                   |



## ULTRASONIC CORROSION SURVEY

Survey Name: CNRL

|                |                |         |                |           |                 |          |              |          |            |        |
|----------------|----------------|---------|----------------|-----------|-----------------|----------|--------------|----------|------------|--------|
| LSD:           | 08-31-073-09W6 | Dwg: 57 | Vessel Number: | A0438986  | Manufacturer:   | OPSCO    | Survey Date: | 1/29/11  |            |        |
| District Unit: | WEST COUNTY    |         | Vessel Name:   | SEPARATOR | Serial Number:  | V-2878A1 | Inspector:   | RAJ KHAN |            |        |
| Location:      | VALHALLA       |         | Year Built:    | 1998      | Shell MAWP PSI: | 1475     | MAWT F:      | 250      | Process:   | SOUR   |
| Skid:          | SKD0208        |         | Tag Number:    | -         | Tube MAWP PSI:  | 0        | MAWT F:      | 0        | Project #: | C70099 |
|                |                |         | CRN:           | N0293.2   | Vessel CA:      | 0.1250   |              |          |            |        |

| Band     | Description |            | Readings |       |       |       |       |       | Year        | Avg<br>Inches | Min<br>Inches | Nominal     | CA     | TMIN   | Recommended<br>Next Inspection | Recommended<br>Retirement<br>Date |
|----------|-------------|------------|----------|-------|-------|-------|-------|-------|-------------|---------------|---------------|-------------|--------|--------|--------------------------------|-----------------------------------|
|          |             |            | 1        | 2     | 3     | 4     | 5     | 6     |             |               |               |             |        |        |                                |                                   |
| 57-45    | Piping      | Baseline   | 0.293    | 0.295 | 0.293 | 0.295 | 0.295 | 0.293 | 2006        | 0.294         | 0.293         | 0.3000      | 0.0375 | 0.1245 | 2012                           | 2031                              |
| Shape    | 90° Elbow   | Shell Side | Previous | 0.293 | 0.295 | 0.293 | 0.295 | 0.295 | 2006        | 0.294         | 0.293         | Comments--> |        |        |                                |                                   |
| OD       | 3.5         | Current    | 0.293    | 0.290 | 0.283 | 0.281 | 0.281 | 0.290 | 2011        | 0.286         | 0.281         |             |        |        |                                |                                   |
| Spec.    | B31.3       |            |          |       |       |       |       |       | ST Loss MPY | 0.002         |               | OK          |        |        |                                |                                   |
| Material | A 234 - WPB |            |          |       |       |       |       |       | LT Loss MPY | 0.002         |               |             |        |        |                                |                                   |