


ITEM:

SEPARATOR

A 0410656

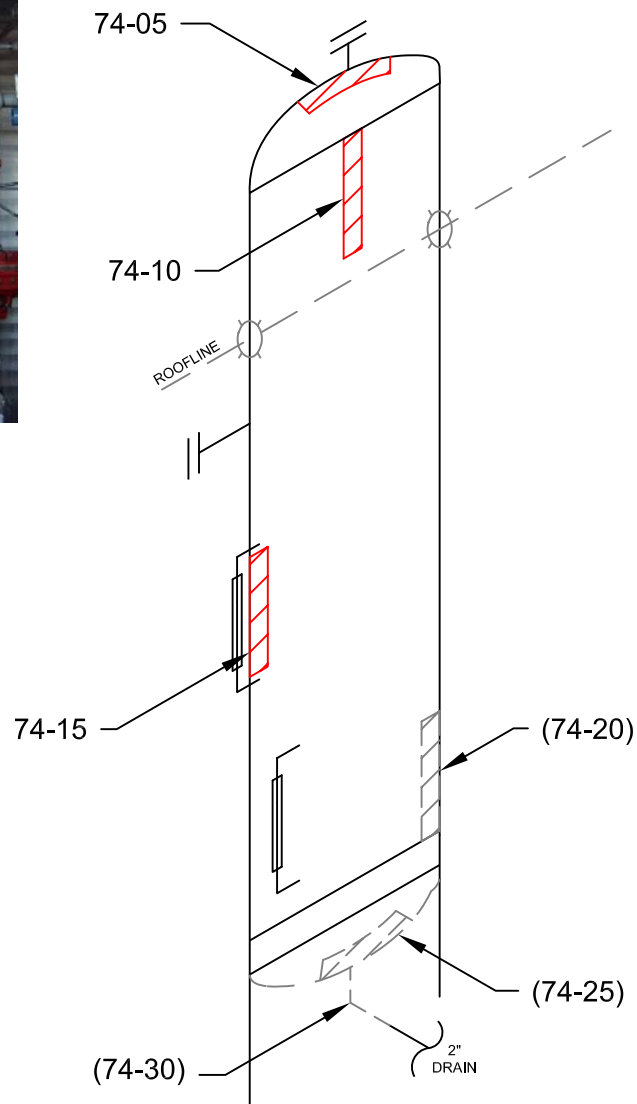

STETTLER, AB (403) 742-4868
LACOMBE, AB (403) 782-7855
BROOKS, AB (403) 501-8029
GRANDE PRAIRIE, AB (866) 422-9732

TECHNICIAN:

GLENN ALLEN
SNT LEVEL II
CGSB 48.9712
LEVEL II # 9738

DATE: 01/26/08**DWG # 74****CLIENT: TALISMAN ENERGY LTD.****LSD: 04-35-074-08-W6M****INSPECTOR :** DUANE PAETKAU**LOCATION :** TEEPEE CREEK FIELD**DISTRICT UNIT :** GPOU**BLDG/SKID:** SKD 0592**PROCESS:** SOUR**CODE:** ASME SEC VIII DIV 1**SPECIFICATION:** AS PER ASME SE 797**TECHNIQUE:** UT-1-1, REV. 1**METHOD:** UT CONTINUOUS / A SCAN**SURFACE COND:** PAINTED**SURFACE TEMP:** AMBIENT**VESSEL INFORMATION****VESSEL # :** A 0410656**CRN # :** K0138.123**SERIAL # :** VS-9520**MANUFACTURER:** SELECT**DATE BUILT:** 1999**CLIENT ID / TAG:** -**M.A.W.P. :** 1440 PSI**M.A.W.T. :** 100 °F**JOINT EFFICIENCY/RT:** RT 1**STRESS RELIEVED:** YES**INSULATED :** NO**MANWAY :** NO**VESSEL SPECIFICATIONS**

	OD	NOMINAL	MATERIAL	CA
VESSEL HEAD	24"	1.063"	SA-516-70	.125"
VESSEL SHELL	24"	.943"	SA-516-70	.125"
BOOT HEAD	-	-	-	-
BOOT SHELL	-	-	-	-

COMMENTS:

PROJECT:
C10175