


ITEM:

LINE HEATER - PIPING

A 0569292

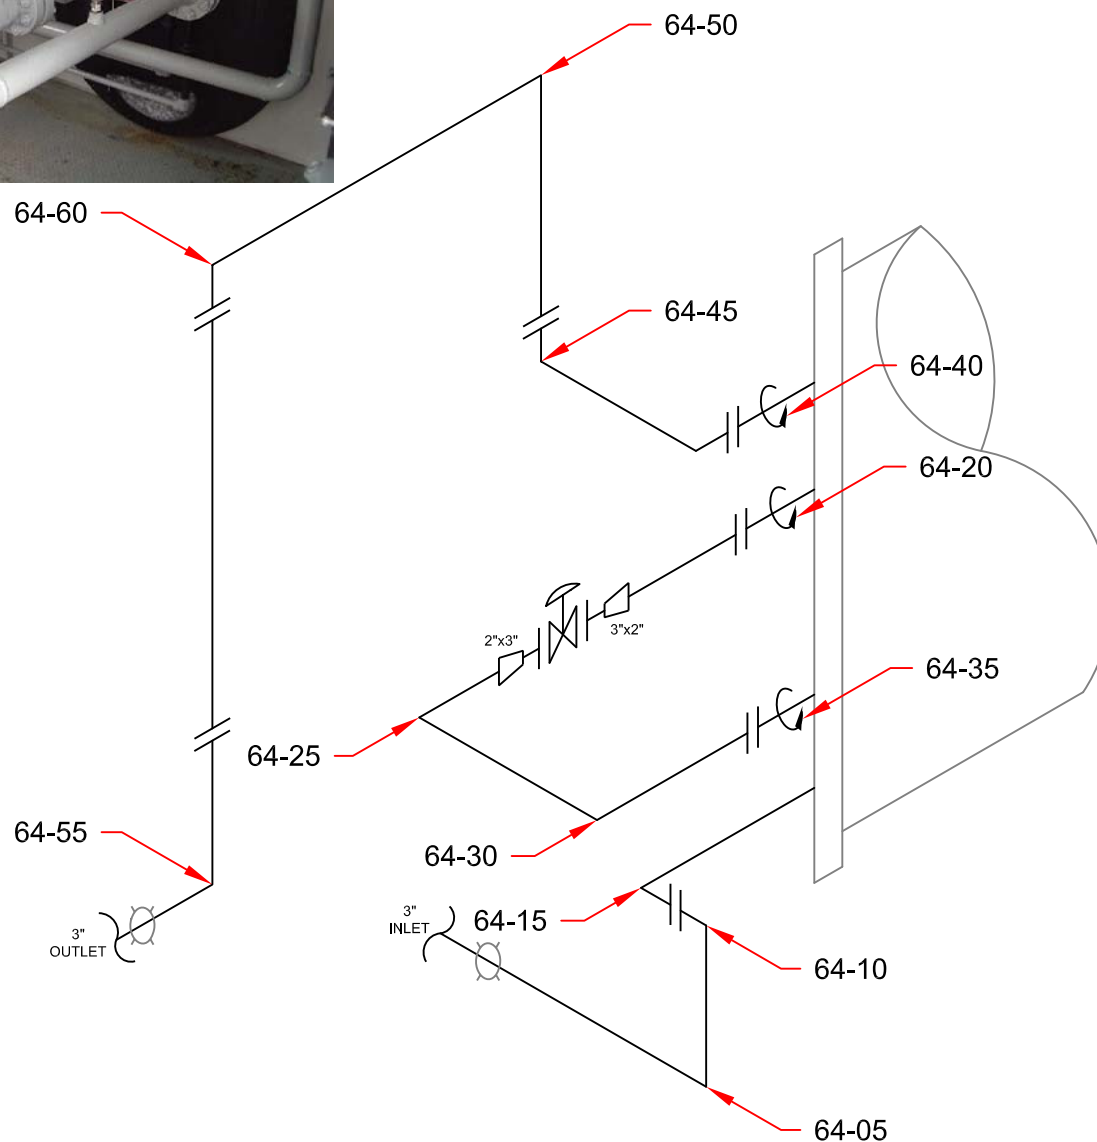

HUNT
INSPECTION LTD.

STETTLER, AB (403) 742-4868
LACOMBE, AB (403) 782-7855
BROOKS, AB (403) 501-8029
GRANDE PRAIRIE, AB (866) 422-9732

TECHNICIAN:

GLENN ALLEN
SNT LEVEL II
CGSB 48.9712
LEVEL II # 9738

DATE : 01/25/08

DWG # 64A

CLIENT : TALISMAN ENERGY LTD.

LSD : 13-35-074-08-W6M

INSPECTOR : DUANE PAETKAU

LOCATION : TEEPEE CREEK FIELD

DISTRICT UNIT : GPOU

BLDG/SKID : SKD 0586

PROCESS : SOUR

CODE : ASME B31.3

SPECIFICATION : AS PER ASME SE 797

TECHNIQUE : UT-1-1, REV.1

METHOD : UT CONTINUOUS / A SCAN

SURFACE COND : PAINTED

SURFACE TEMP : AMBIENT

PIPING INFORMATION

PIPING ID	SIZE	SCH	NOM	M.A.W.P. (VESSEL)	M.A.W.T. (VESSEL)	FLANGE RATING
64-05	3.50"	XXS	.600"	3375 PSI	200 °F	-
64-10	"	"	"	"	"	"
64-15	"	"	"	"	"	"
64-20	"	"	"	"	"	"
64-25	3.50"	XS	.300"	1600 PSI	200 °F	"
64-30	"	"	"	"	"	"
64-35	"	"	"	"	"	"
64-40	"	"	"	"	"	"
64-45	"	"	"	"	"	"
64-50	"	"	"	"	"	"
64-55	"	"	"	"	"	"
64-60	"	"	"	"	"	"

COMMENTS:

PROJECT:

C10175