


ITEM:

SEPARATOR

A 0414803

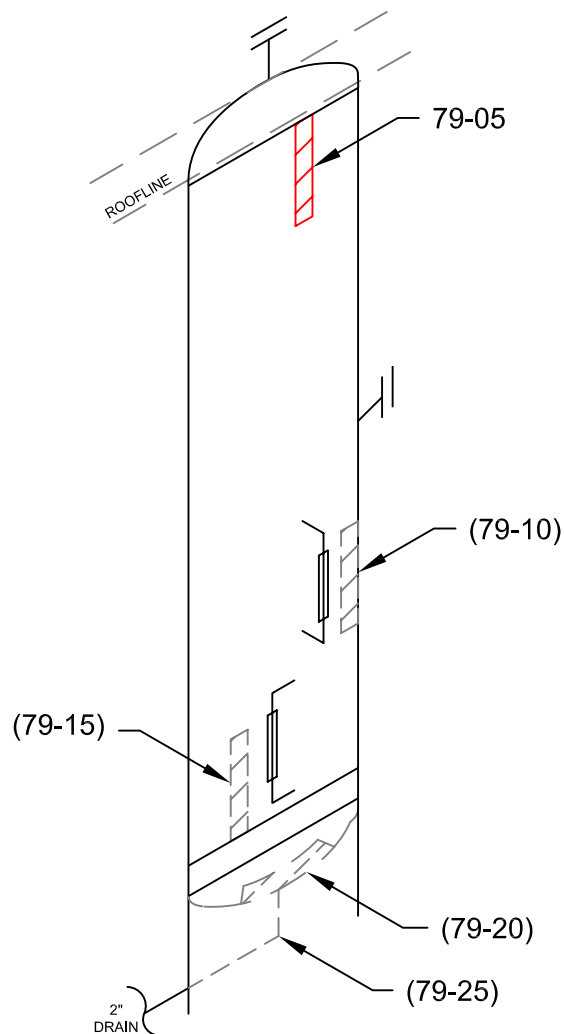

STETTLER, AB (403) 742-4868
 LACOMBE, AB (403) 782-7855
 BROOKS, AB (403) 501-8029
 GRANDE PRAIRIE, AB (866) 422-9732

TECHNICIAN:

GLENN ALLEN
 SNT LEVEL II
 CGSB 48.9712
 LEVEL II # 9738

DATE: 01/26/08**DWG # 79****CLIENT: TALISMAN ENERGY LTD.****LSD: 12-25-074-08-W6M****INSPECTOR :** DUANE PAETKAU**LOCATION :** TEEPEE CREEK FIELD**DISTRICT UNIT :** GPOU**BLDG/SKID:** SKD 0595**PROCESS:** SOUR**CODE:** ASME SEC VIII DIV 1**SPECIFICATION:** AS PER ASME SE 797**TECHNIQUE:** UT-1-1, REV. 1**METHOD:** UT CONTINUOUS / A SCAN**SURFACE COND:** PAINTED**SURFACE TEMP:** AMBIENT**VESSEL INFORMATION****VESSEL # :** A 0414803**CRN # :** L8282.21**SERIAL # :** 001013-001**MANUFACTURER:** BS&B**DATE BUILT:** 2000**CLIENT ID / TAG:** -**M.A.W.P. :** 1440 PSI**M.A.W.T. :** 130 °F**JOINT EFFICIENCY/RT:** RT 1**STRESS RELIEVED:** YES**INSULATED :** NO**MANWAY :** NO**VESSEL SPECIFICATIONS**

	OD	NOMINAL	MATERIAL	CA
VESSEL HEAD	20"	.825"	SA-516-70	.125"
VESSEL SHELL	20"	.875"	SA-516-70	.125"
BOOT HEAD	-	-	-	-
BOOT SHELL	-	-	-	-

COMMENTS:

TOP HEAD IS ENCLOSED IN ROOF

PROJECT:

C10175