



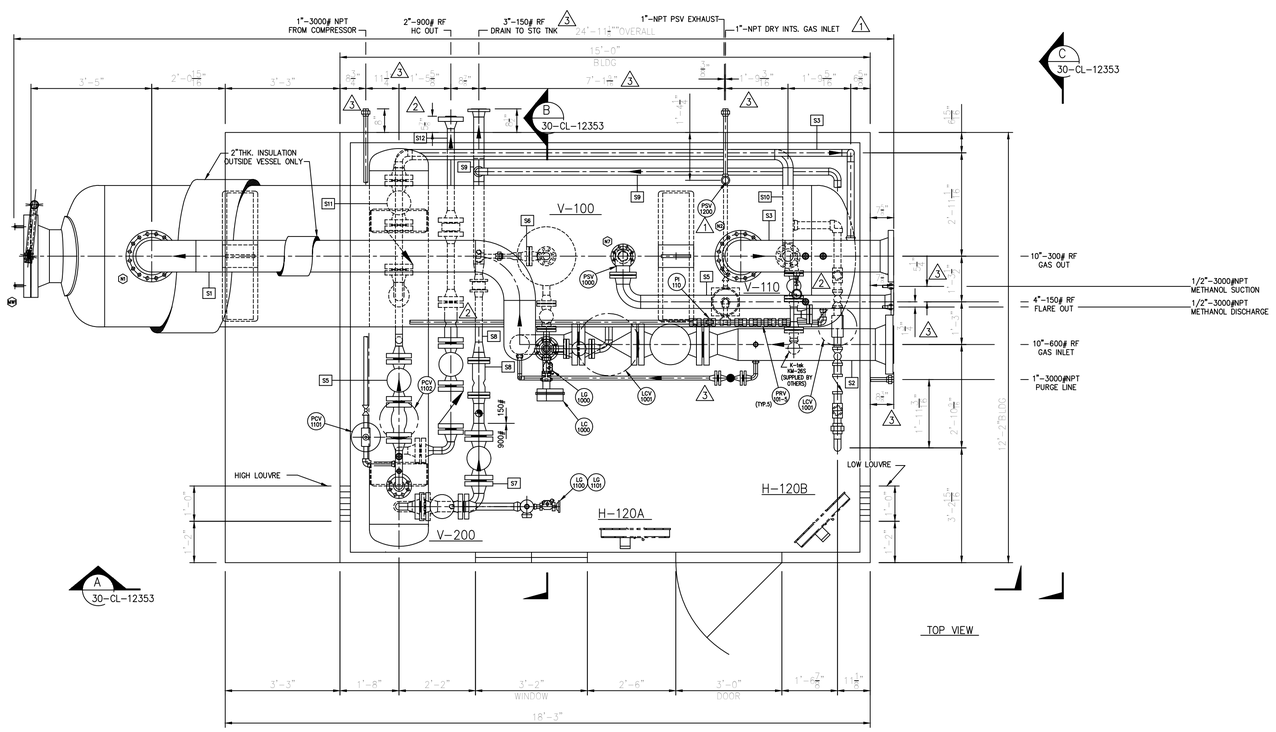


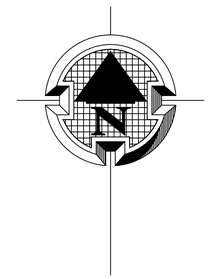

(REF. ONLY)

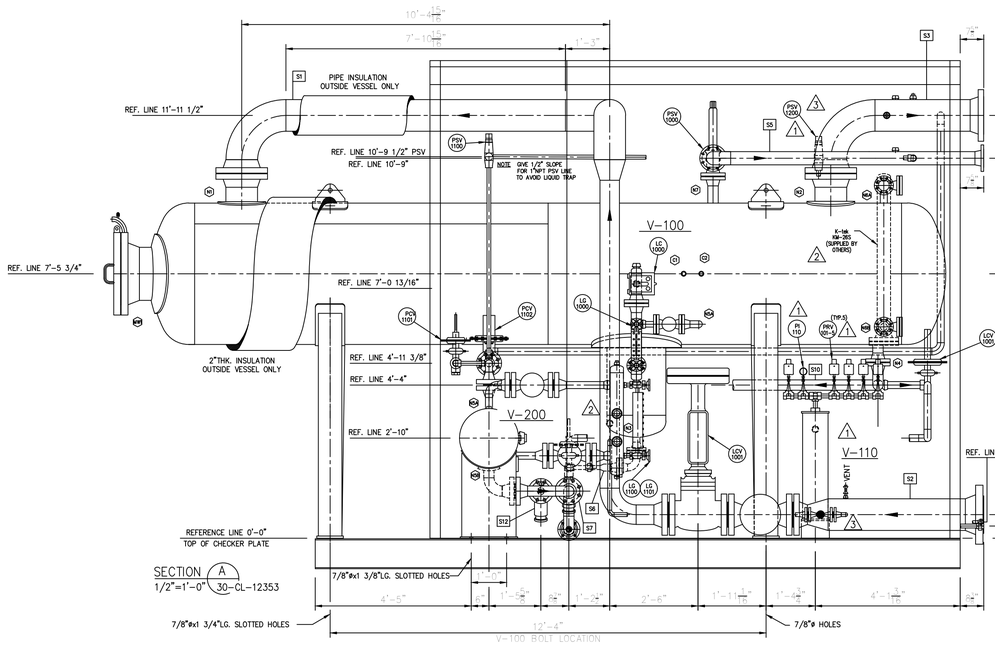

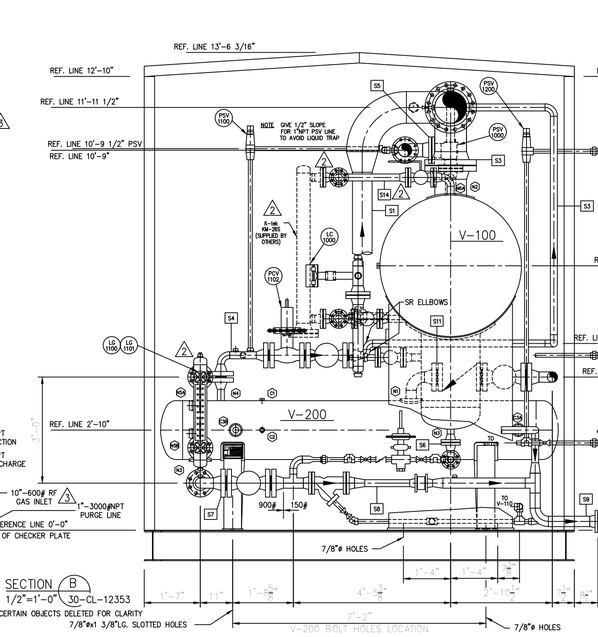

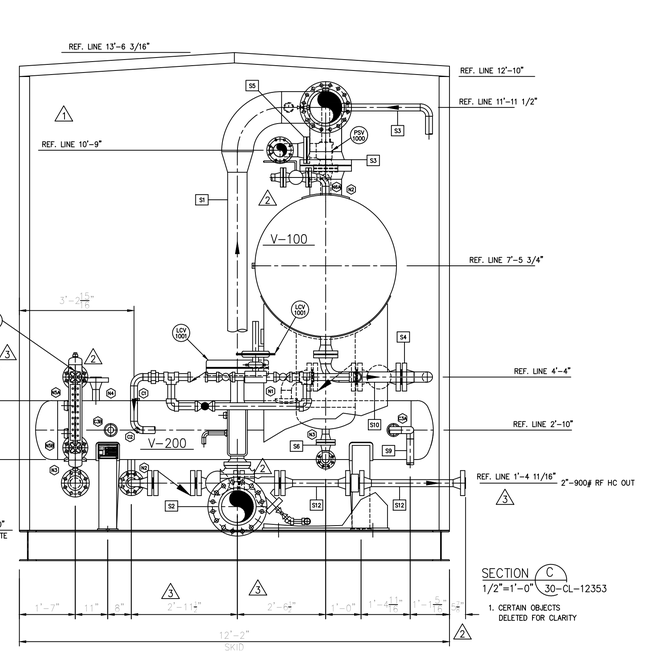

–	–	–	–	–	–
–	–	–	–	–	–
–	–	–	–	–	–
–	–	–	–	–	–
–	–	–	–	–	–
–	–	–	–	–	–
–	–	–	–	–	–
–	–	–	–	–	–
–	–	–	–	–	–
TAG	V-100 DESCRIPTION	SIZE-RATING	TAG	V-200 DESCRIPTION	SIZE-RATING

CUSTOMER CONNECTIONS FOR (V-100,V-200)

CP Drawing: 011055 / Date: 12-07-2001 / Time: 09:04 / User ID: D.KHAM

GENERAL NOTES:

1. PIPING DESIGNED TO ASME CODE B31.3 1999 EDITION.
2. UNLESS OTHERWISE INDICATED, SHOP SHALL LOCATE ALL CUSTOMER CONNECTIONS NOT SHOWN ON DRAWING.
3. ALL SKID EDGE DIMENSIONS SHALL HAVE A TOLERANCE OF ± [1\4]" OF THE INDICATED DIMENSIONS.
4. TOP OF FLOOR PLATE TO CENTERLINE OF PIPE TO BE A MINIMUN OF 6"
5. PAINTING: COMMERCIAL SANDBLASTING TO SSPC-SP6, (1) ONE COAT SHOP PRIMER & (2) TWO COATS VALSPAR SKY BLUE.
6. APPROX. TOTAL SHIPPING WEIGHT: 35 000 LBS.

REFERENCE DRAWINGS:

30-CL-12351 REV.0 – 48"OD x 20'-0"s/s x 720 PSIG. 3-PH. HORIZ. SEPARATOR.
30-CL-12352 REV.0 – 20"OD x 10'-0"s/s x 2160 PSIG. HORIZ. SUMP.
30-CL-12359 REV.0 – 12'-2" x 18'-3"LG. SKID.
30-CL-12355 REV.0 – P&ID.

REV	DATE	REV BY	CHK'D BY	APP'D BY	DESCRIPTION
3	OCT.31/01	DK	WT	WT	AS BUILT
2	SEP.26/01	DK	WT	WT	REVISED ORIENTATION FOR LEVEL CAGE ON V-200, DEL. LG-1001, REV. STRAINER DIM.
1	SEP.25/01	DK	WT	WT	INSERT V-110, FUEL GAS SCRUBBER
0	AUG.30/01	DK	WT	WT	ISSUED FOR CONSTRUCTION
B	JUL.26/01	DK	WT	WT	REISSUED FOR APPROVAL
A	JUL.19/01	DK	WT	WT	ISSUED FOR APPROVAL

REVISIONS

This drawing is the property of BLACK, SIVALLS & BRYSON (CANADA) LTD. and is lent to the recipient for his confidential use only. In consideration of the loan of this drawing, the recipient promises and agrees that it shall not use used in any way detrimental to the interests of BLACK, SIVALLS & BRYSON (CANADA) LTD. , that it shall be returned upon request, and that it shall not be reproduced copied, lent or otherwise disposed of, directly or indirectly, without the written approval of BLACK, SIVALLS & BRYSON (CANADA) LTD.

BLACK, SIVALLS & BRYSON (CANADA) LTD.
2314-8TH. STREET, NISKU, ALBERTA, CANADA T9E-7Z2
PH: (780)-955-2888 / FAX: (780)-955-8911
WEB PAGE: WWW.BSB.AB.CA

TITLE	48"OD x 20'-0"S/S x 2160 PSIG 3-PHASE HORIZ. SEPARATOR w/24"OD x 8'-0" S/S x 1440 PSIG HORIZONTAL SUMP
CUSTOMER	ANADARKO CANADA ENERGY c/o TUNDRA ENGINEERING LTD.
LOCATION	LSD 4-03-57-23 W5M
DRAWN:	D.KHAM
DATE:	JUL.18/01
ENG.:	WESLEY.T
SCALE:	1/2"=1'-0"
S.O. NUMBER	011055
P.O NUMBER	-----
UNITS REQ'D	1
DRAWING NUMBER	30-CL-12353
REV	3